


WILLIAMS STREET DETOUR

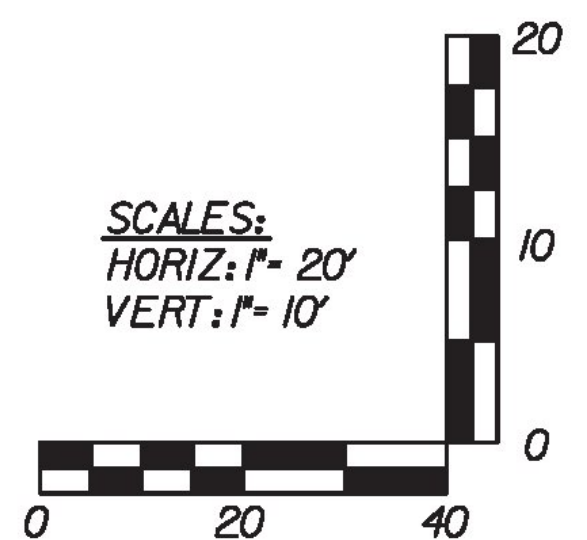

RFC - 12/21/2010  
WILLIAMS STREET DETOUR

PROJECT NAME: BRATTLEBORO  
PROJECT NUMBER: 1M 091-(150)

**AS BUILT  
RECORD PLANS**

BECK & BELLUCCI, INC.

TYLIN INTERNATIONAL

FILE NAME: HW-100-WSD-601.dgn  
PROJECT LEADER: Brian W. Clogston P.E.  
DESIGNED BY: Phillip E. Kendall P.E.  
WILLIAMS STREET DETOUR PROFILE

PLOT DATE: 12/21/2010  
DRAWN BY: J. R. Howe P.E.  
CHECKED BY: J. R. Howe P.E.  
SHEET HW-100-WSD-601