


NOTES:
 1. THE SIGN PACKAGE IS BASED ON VTRANS STANDARDS E-100 AND E-107 AND MUTCD TABLE 6C-1 (2009 EDITION).

**AS BUILT
 RECORD PLANS**

RFC - 12/21/2010
 WILLIAMS STREET DETOUR

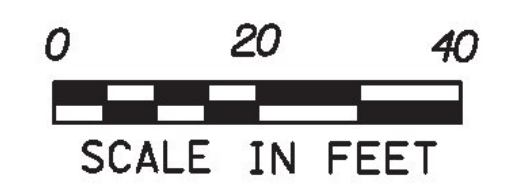

BECK & BELLUCCI, INC.	TYLIN INTERNATIONAL	PROJECT NAME: BRATTLEBORO	PLOT DATE: 12/21/2010
		PROJECT NUMBER: 1M 091-(150)	DRAWN BY: J. R. Howe P.E.
		FILE NAME: HW-100-WSD-701.dgn	CHECKED BY: J. R. Howe P.E.
		PROJECT LEADER: Brian W. Clogston P.E.	SHEET HW-100-WSD-701
		DESIGNED BY: Phillip E. Kendall P.E.	
		WILLIAMS STREET DETOUR SIGNING PLAN	