




11+25

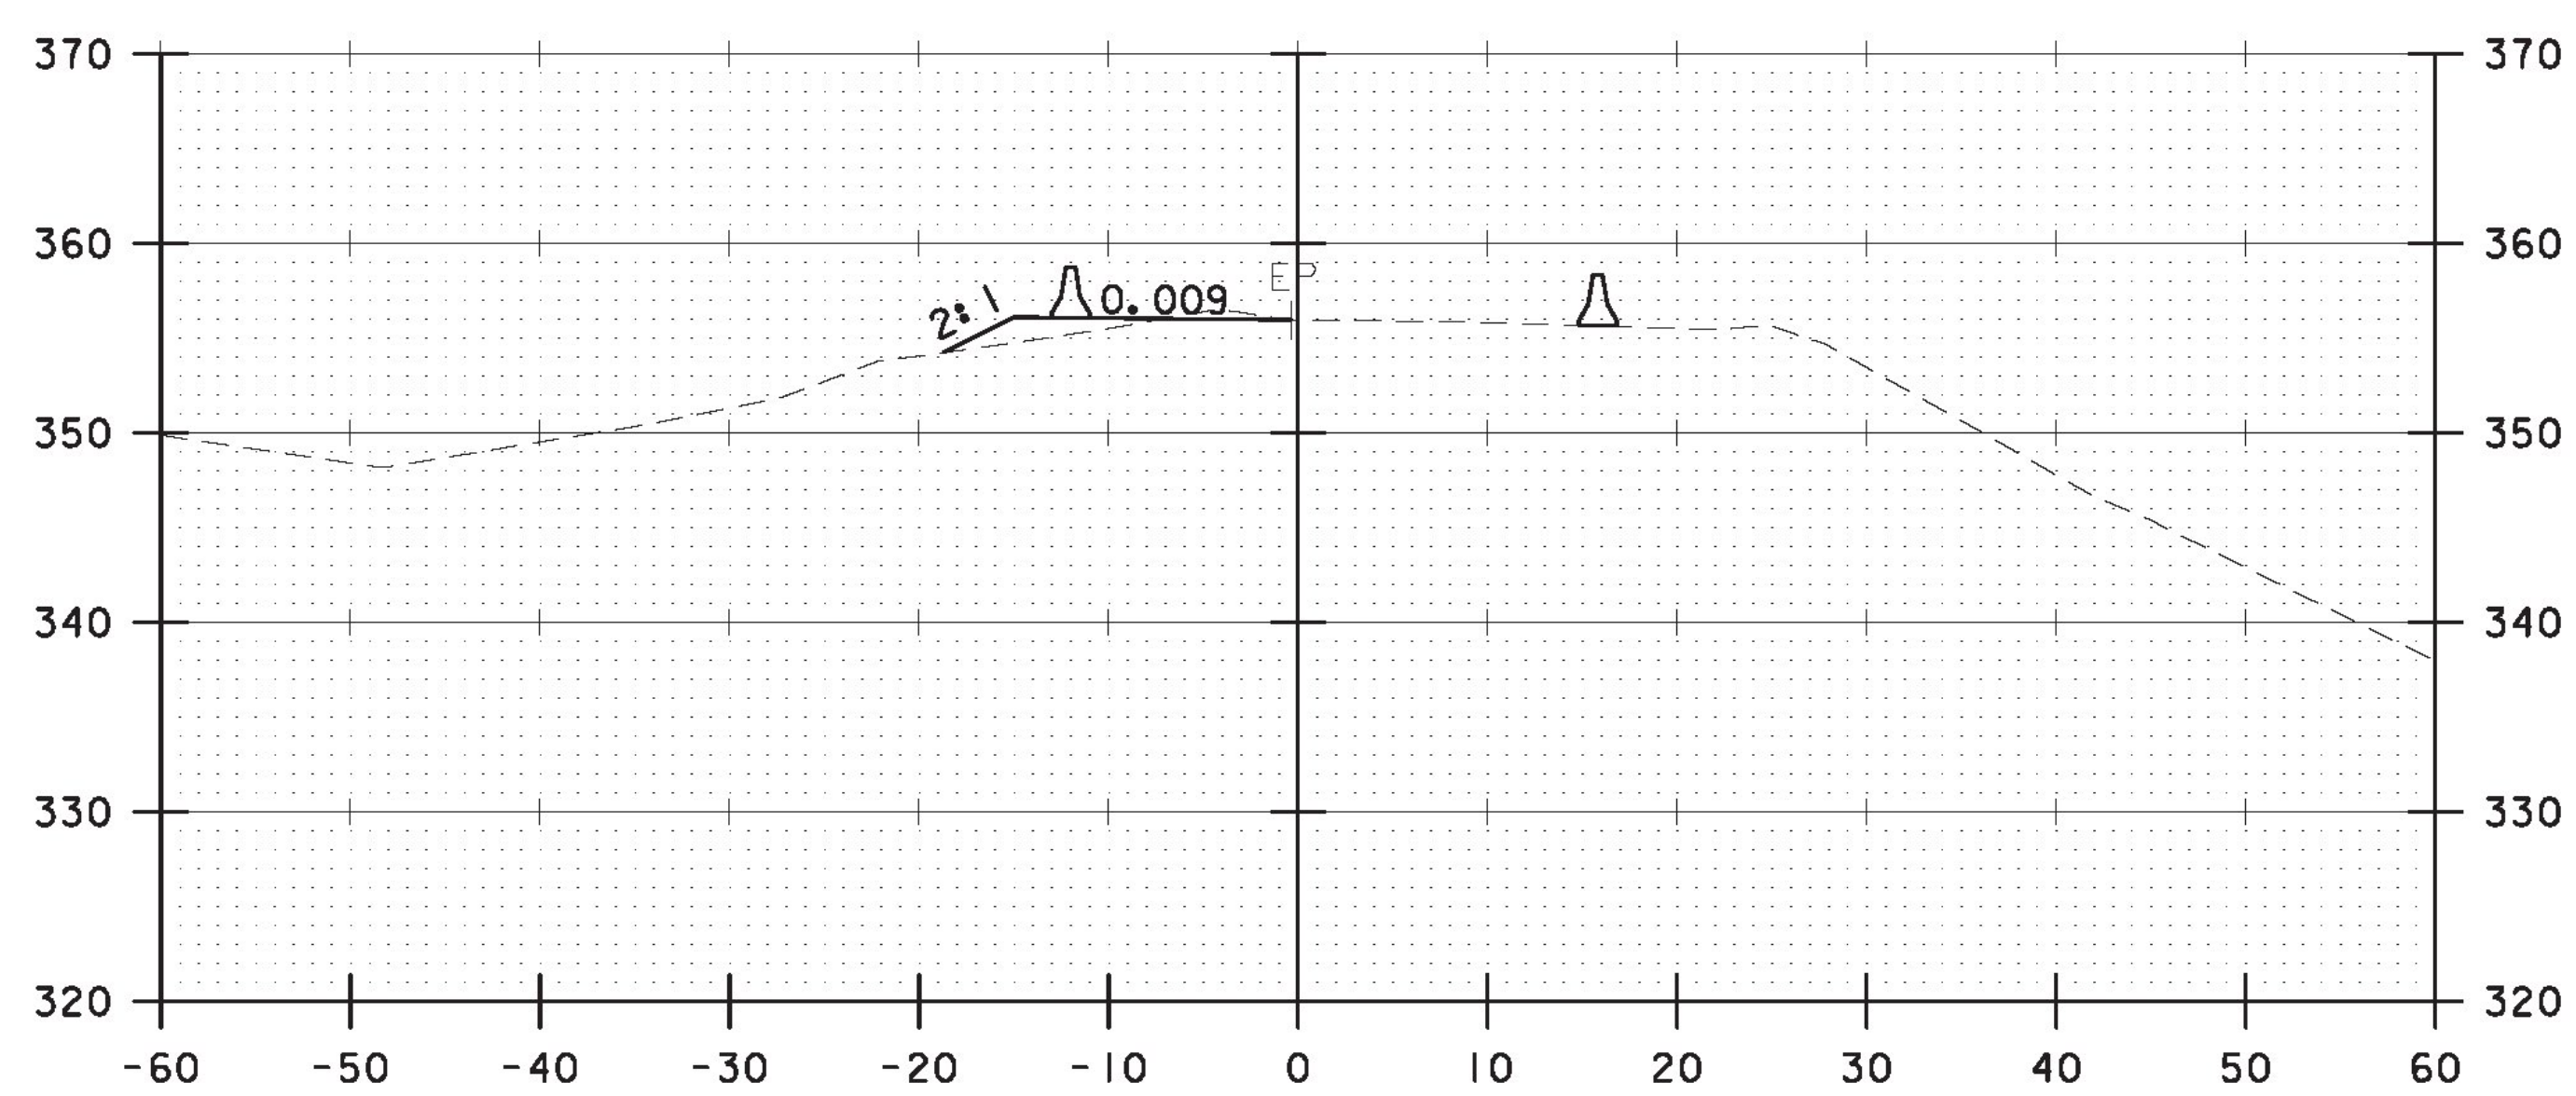


11+00

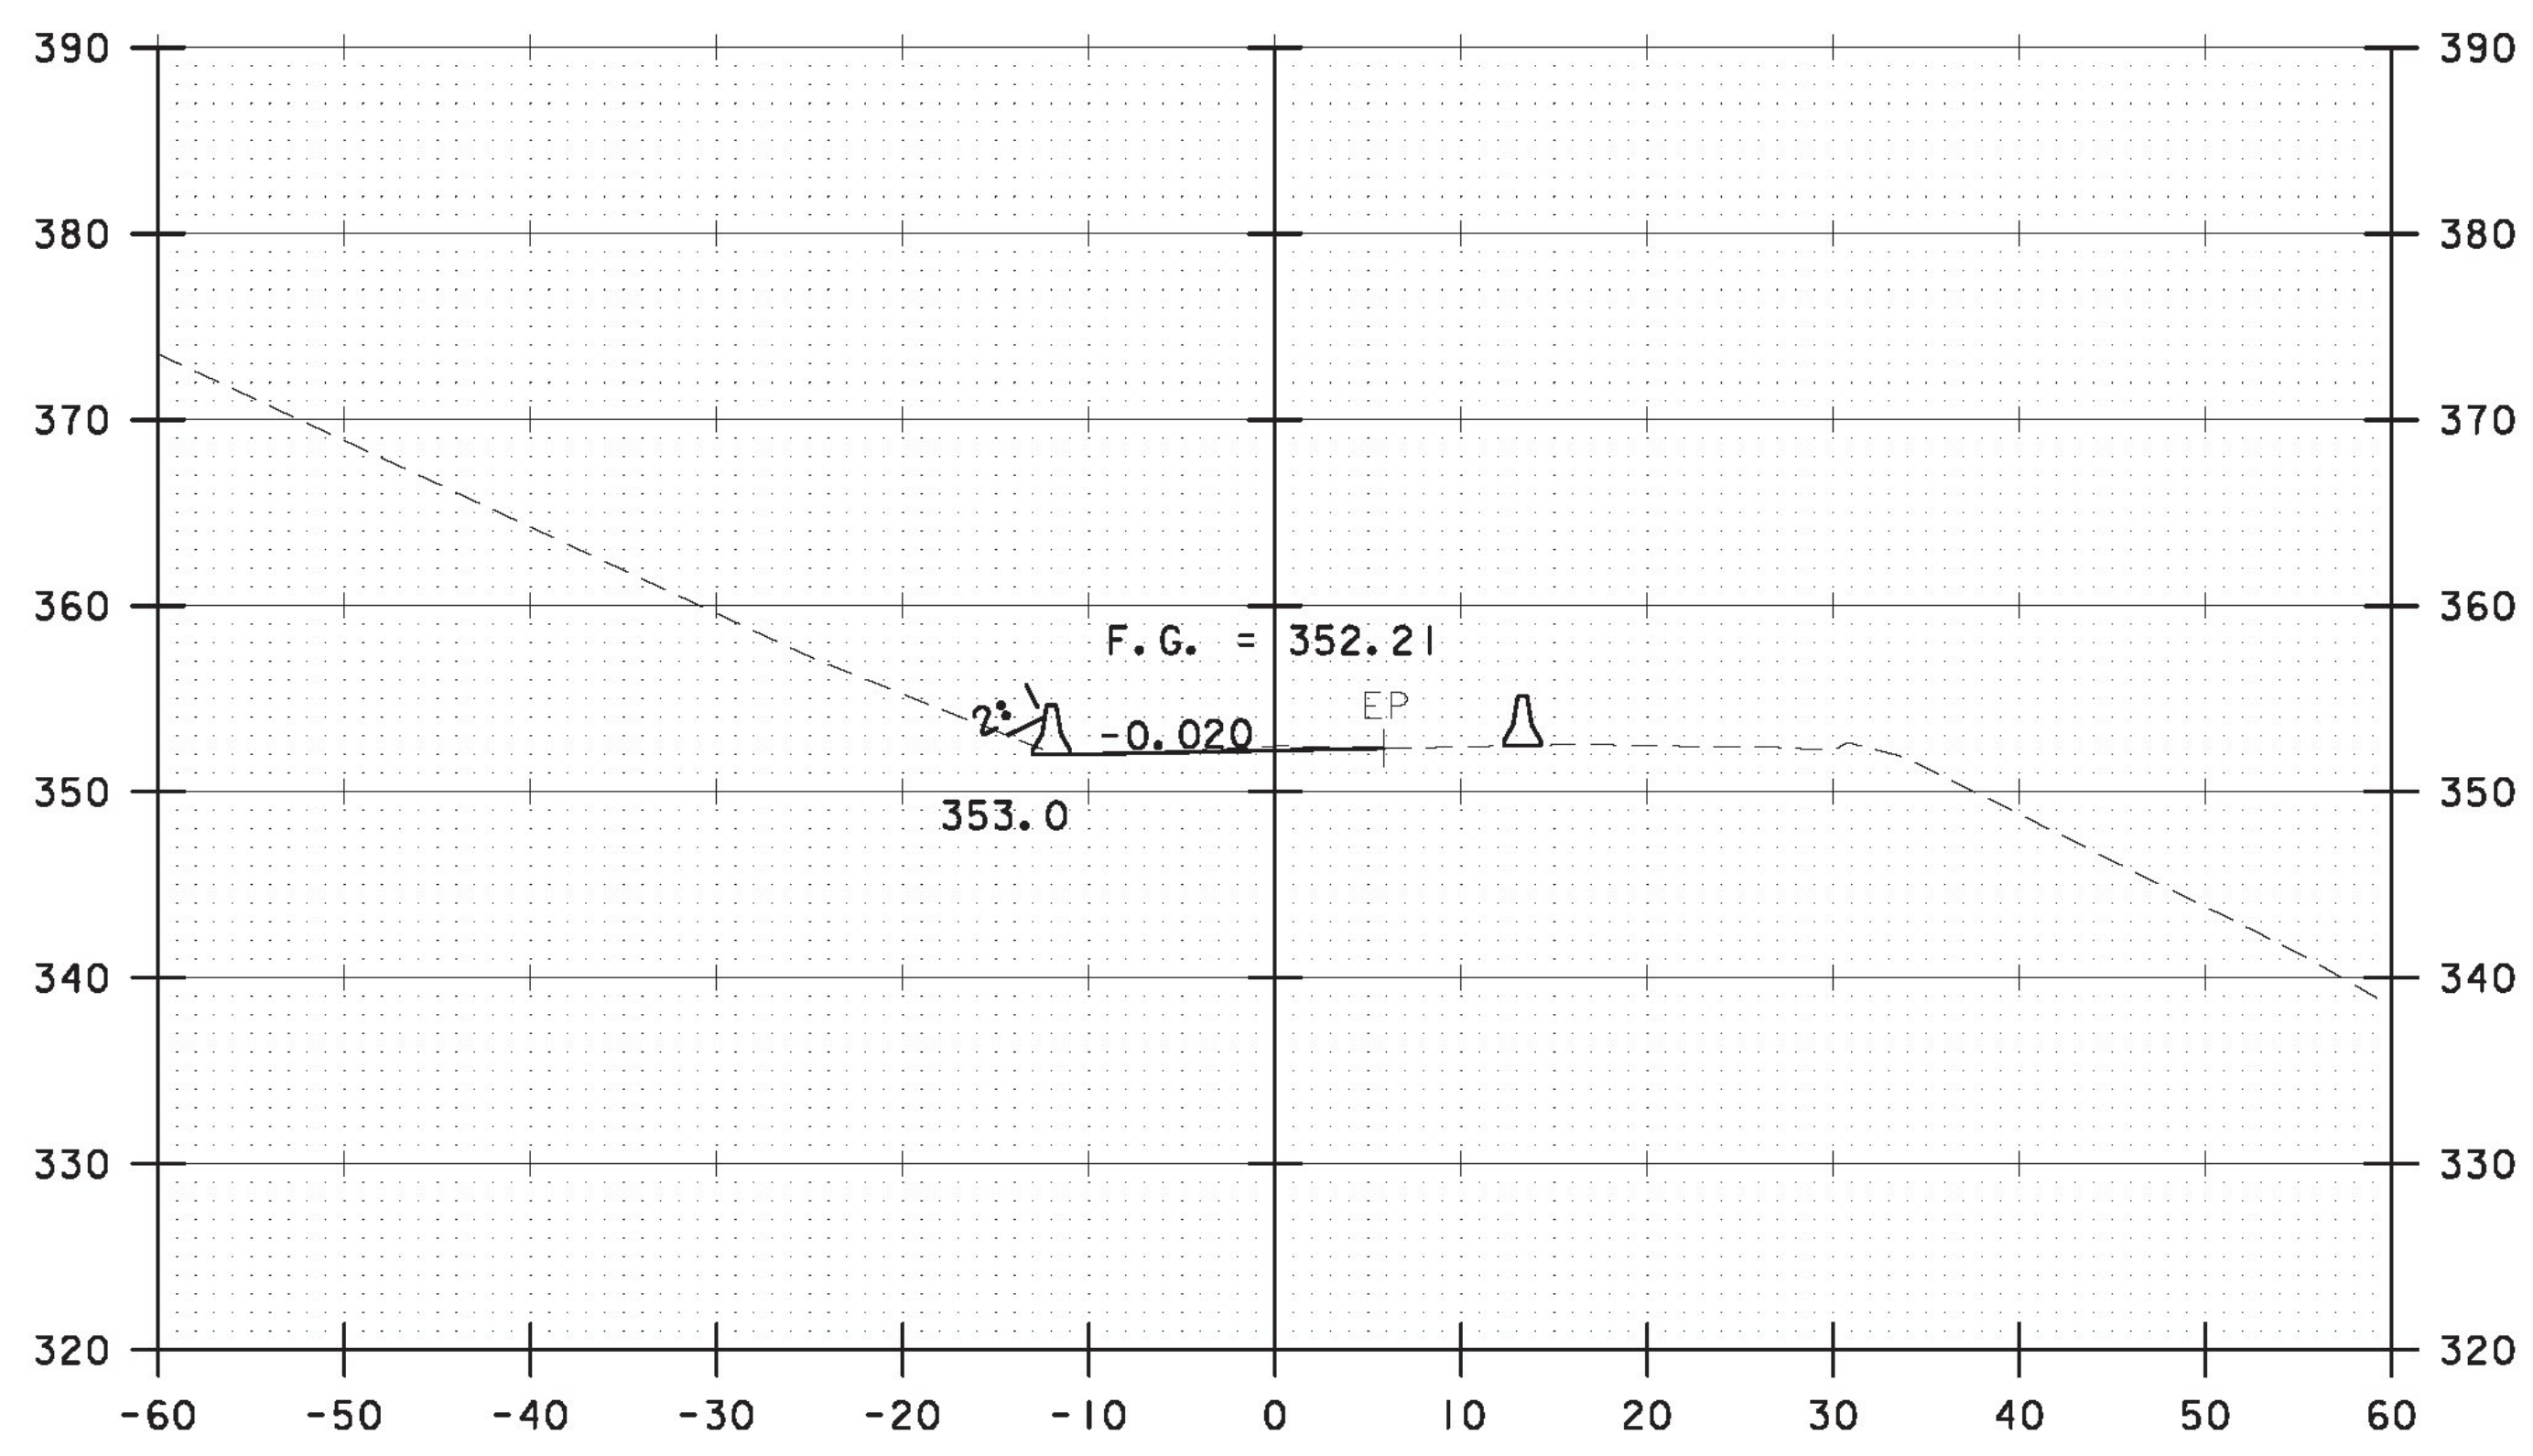

11+75

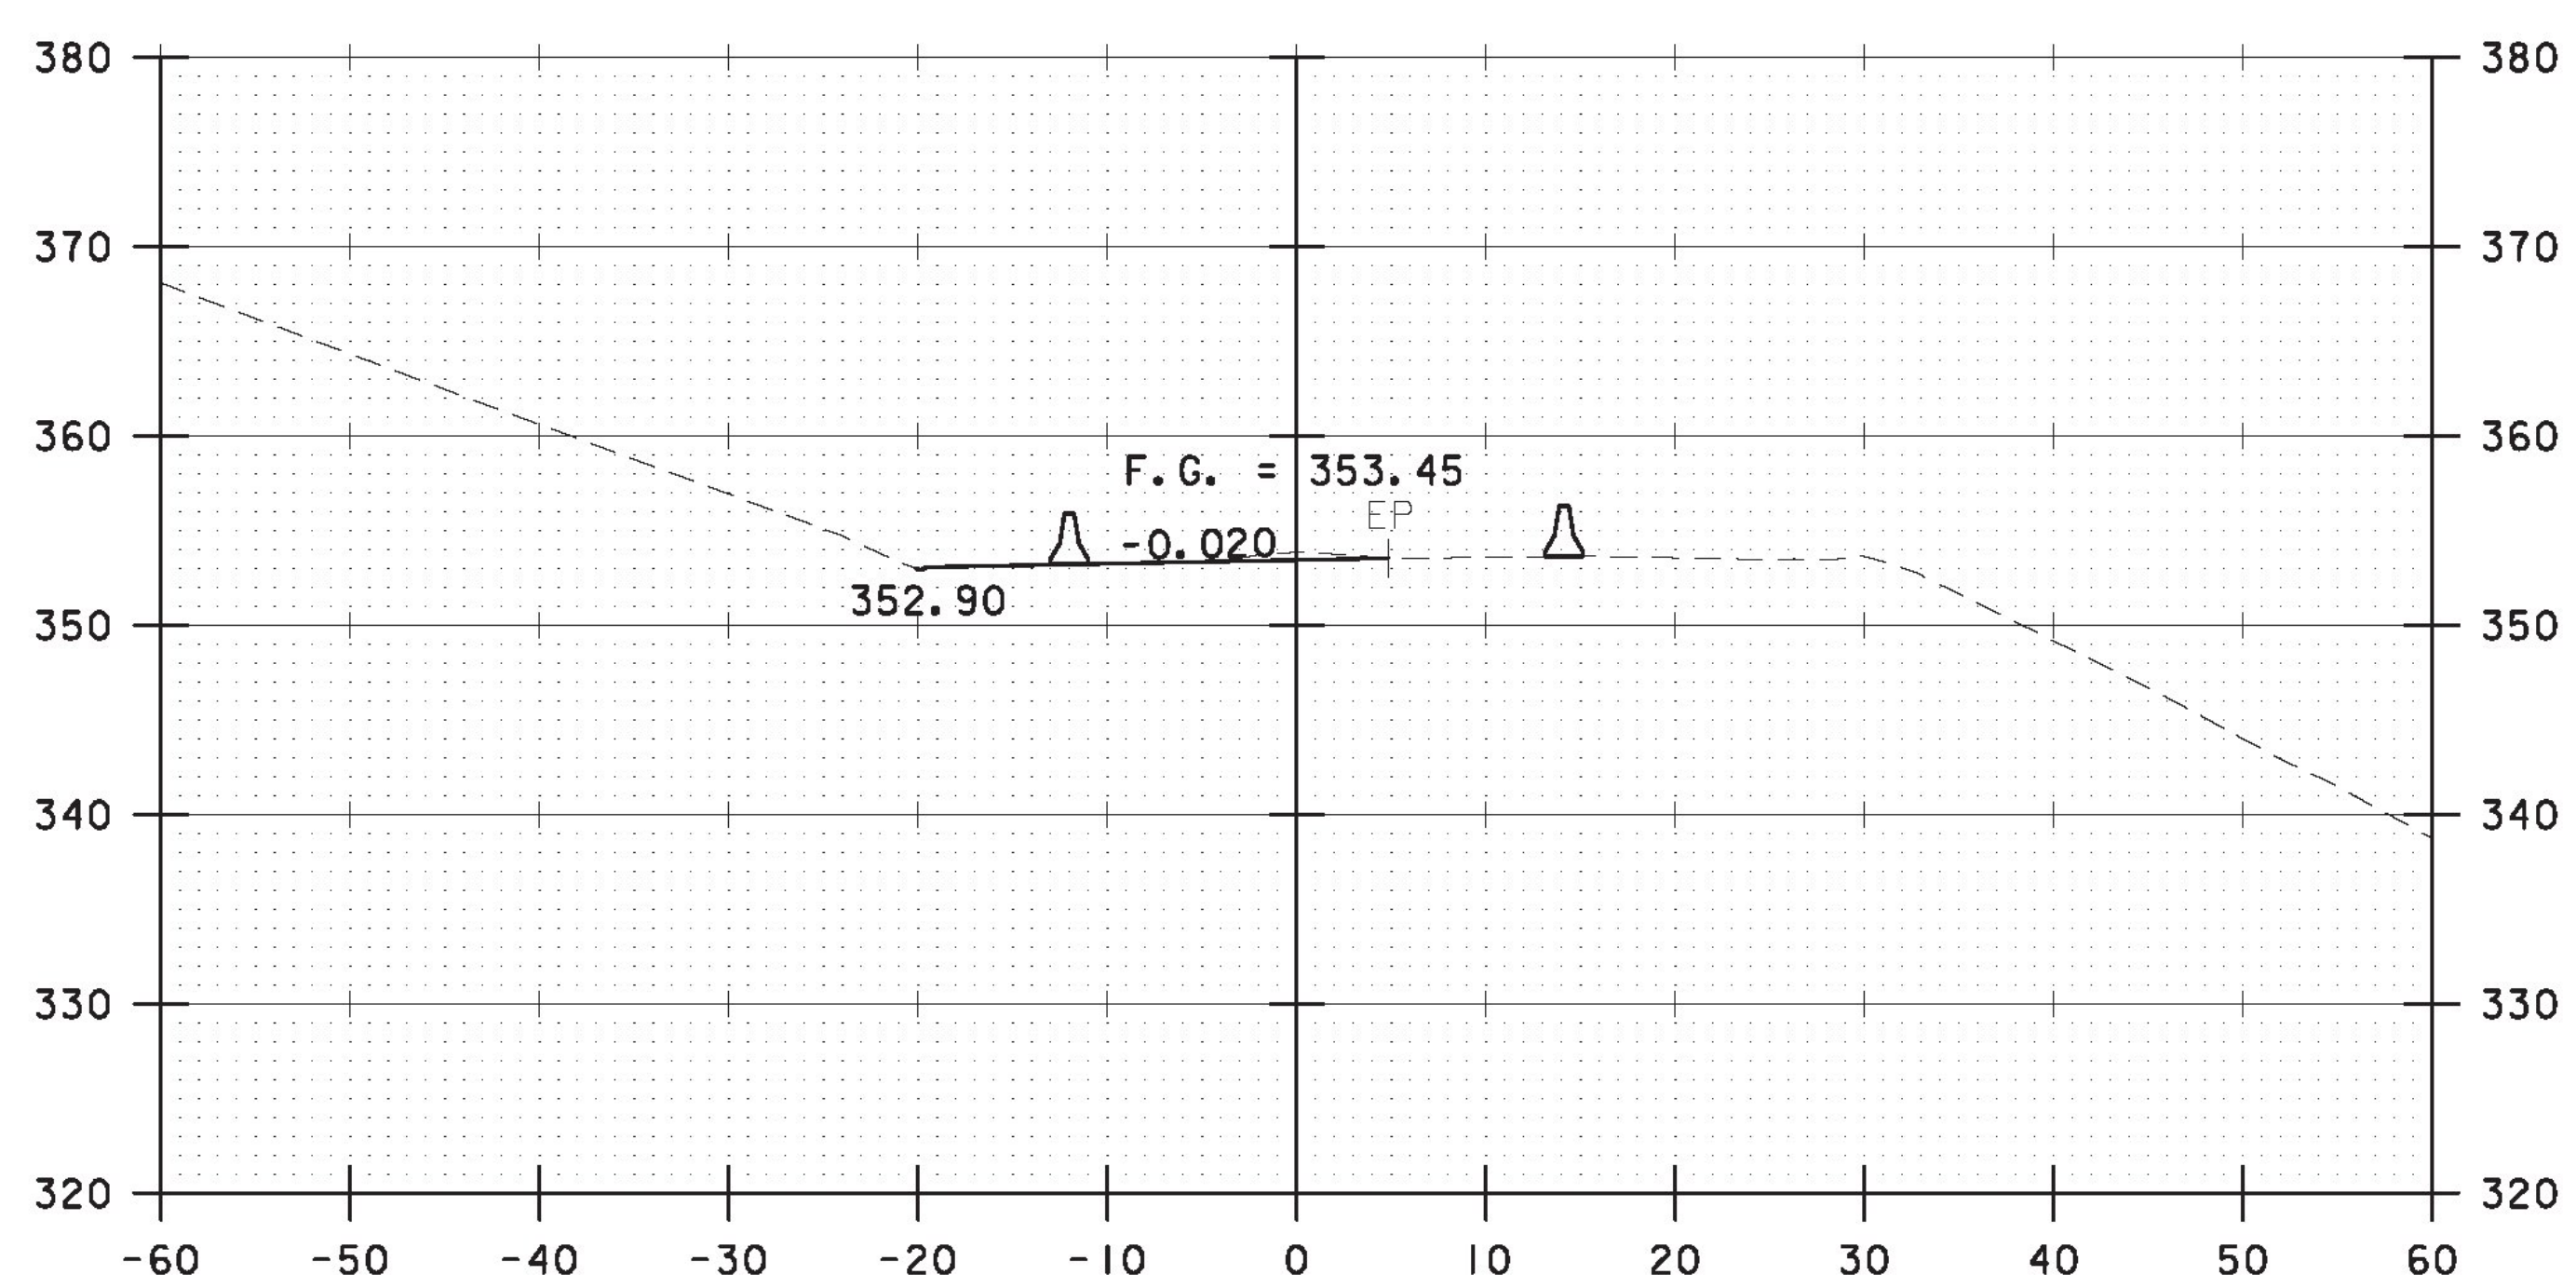

11+50

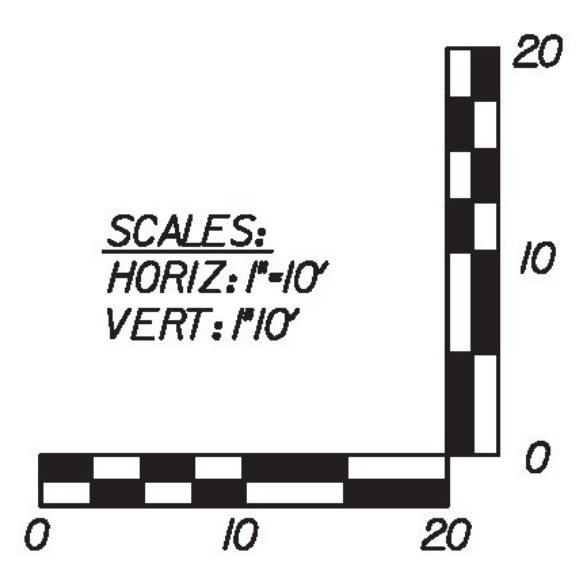

WILLIAMS STREET
STA. 11+00 TO STA. 11+75

RFC - 12/21/2010
WILLIAMS STREET DETOUR

PROJECT NAME: BRATTLEBORO
PROJECT NUMBER: 1M 091-(150)

**AS BUILT
RECORD PLANS**

BECK & BELLUCCI, INC. **TYLIN INTERNATIONAL**

FILE NAME: HW-100-WSD-900.dgn
PROJECT LEADER: Brian W. Clogston P.E.
DESIGNED BY: Phillip E. Kendall P.E.
WILLIAMS STREET DETOUR CROSS SECTIONS

PLOT DATE: 12/21/2010
DRAWN BY: J. R. Howe P.E.
CHECKED BY: J. R. Howe P.E.
SHEET HW-100-WSD-902