




14+25

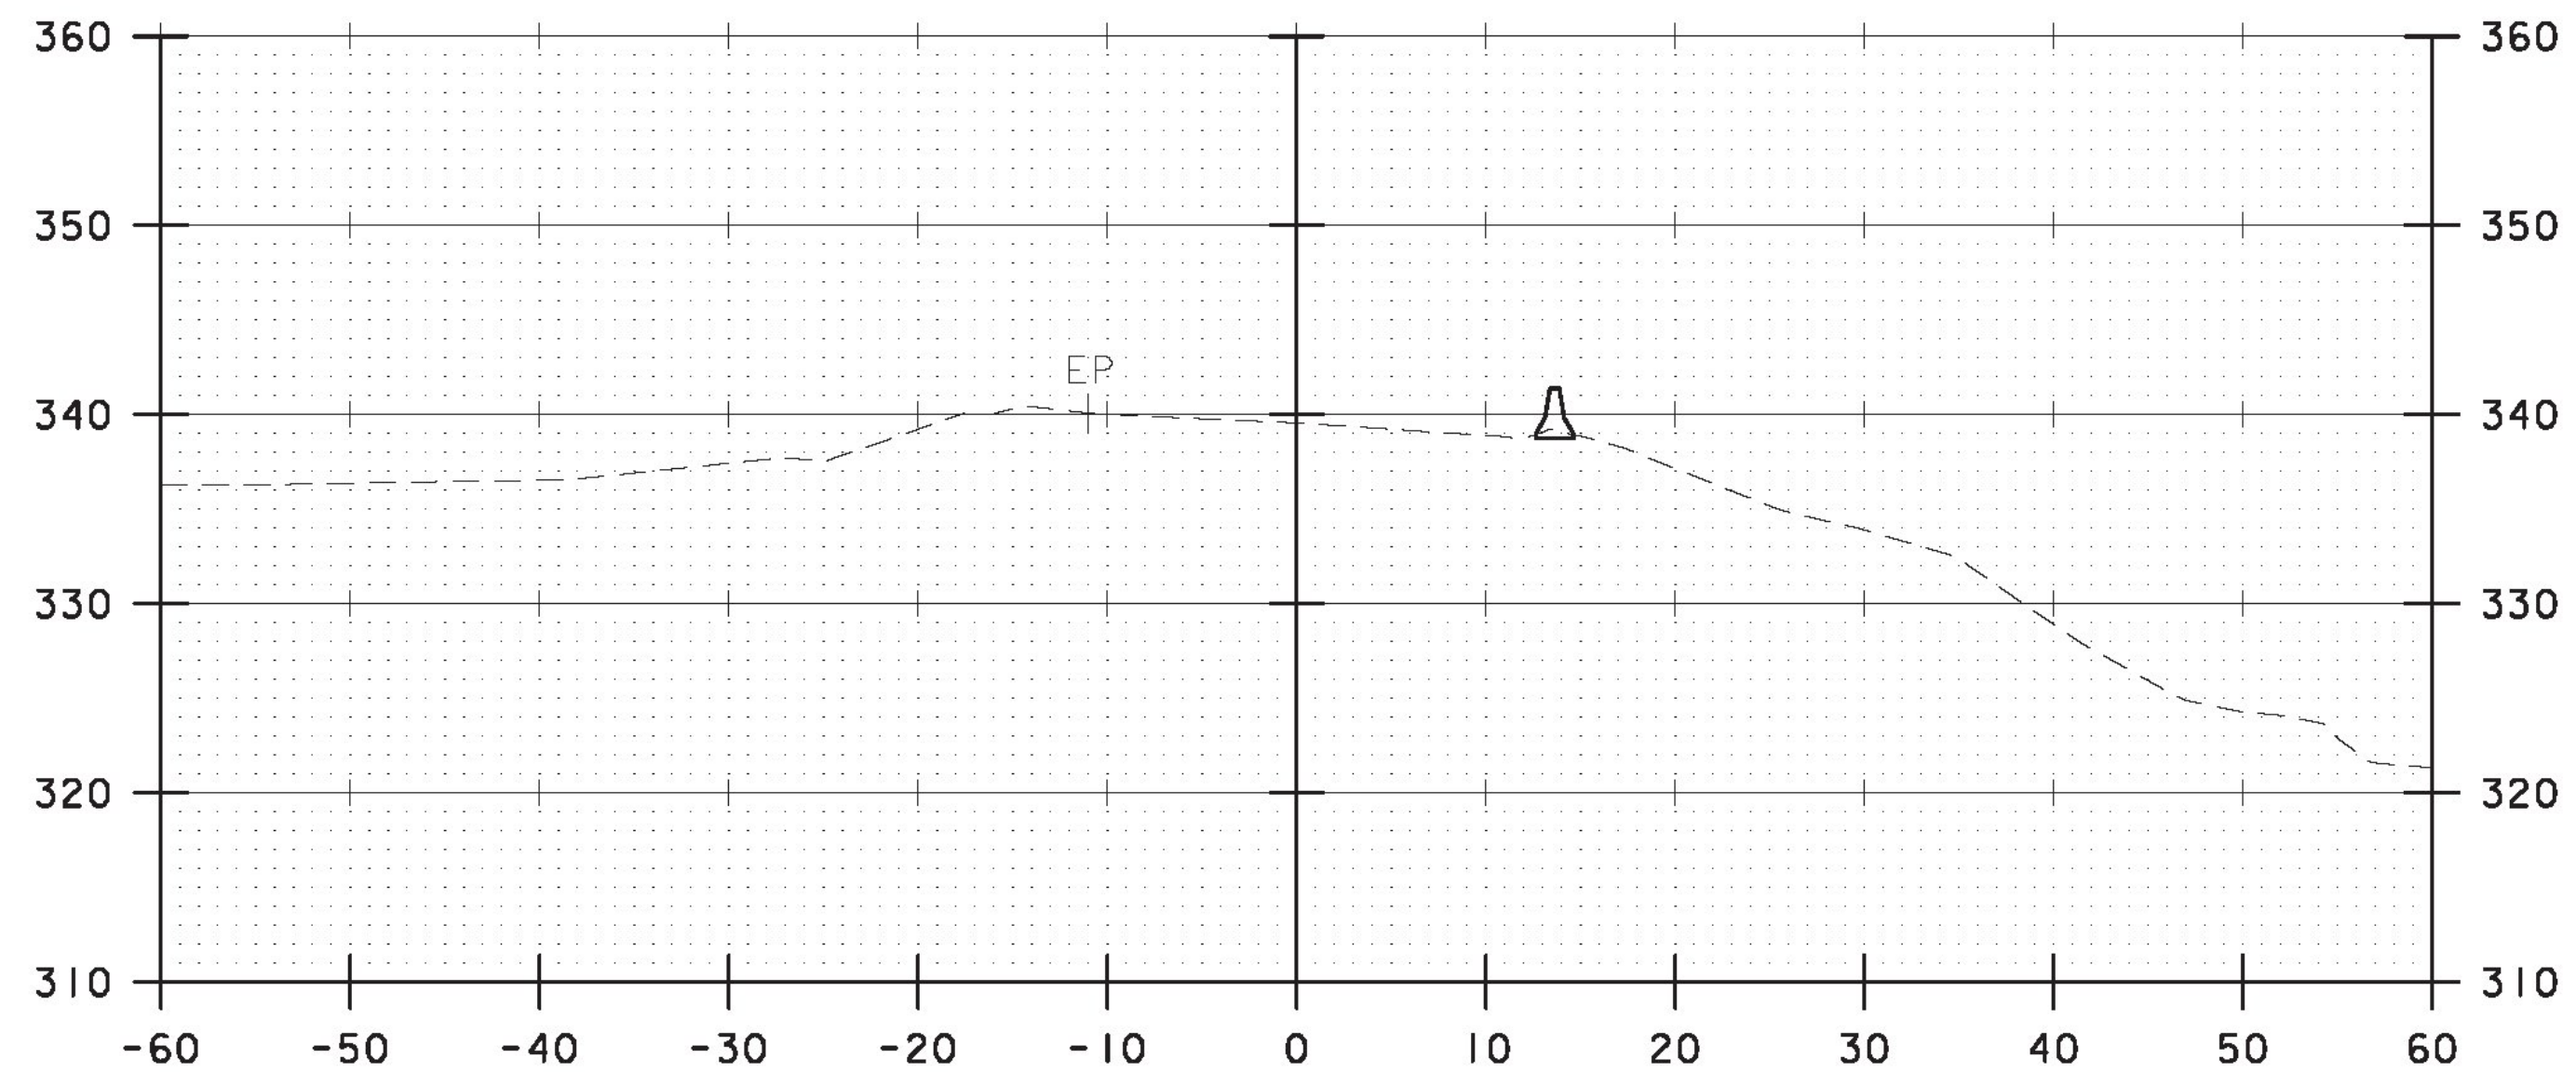


14+75

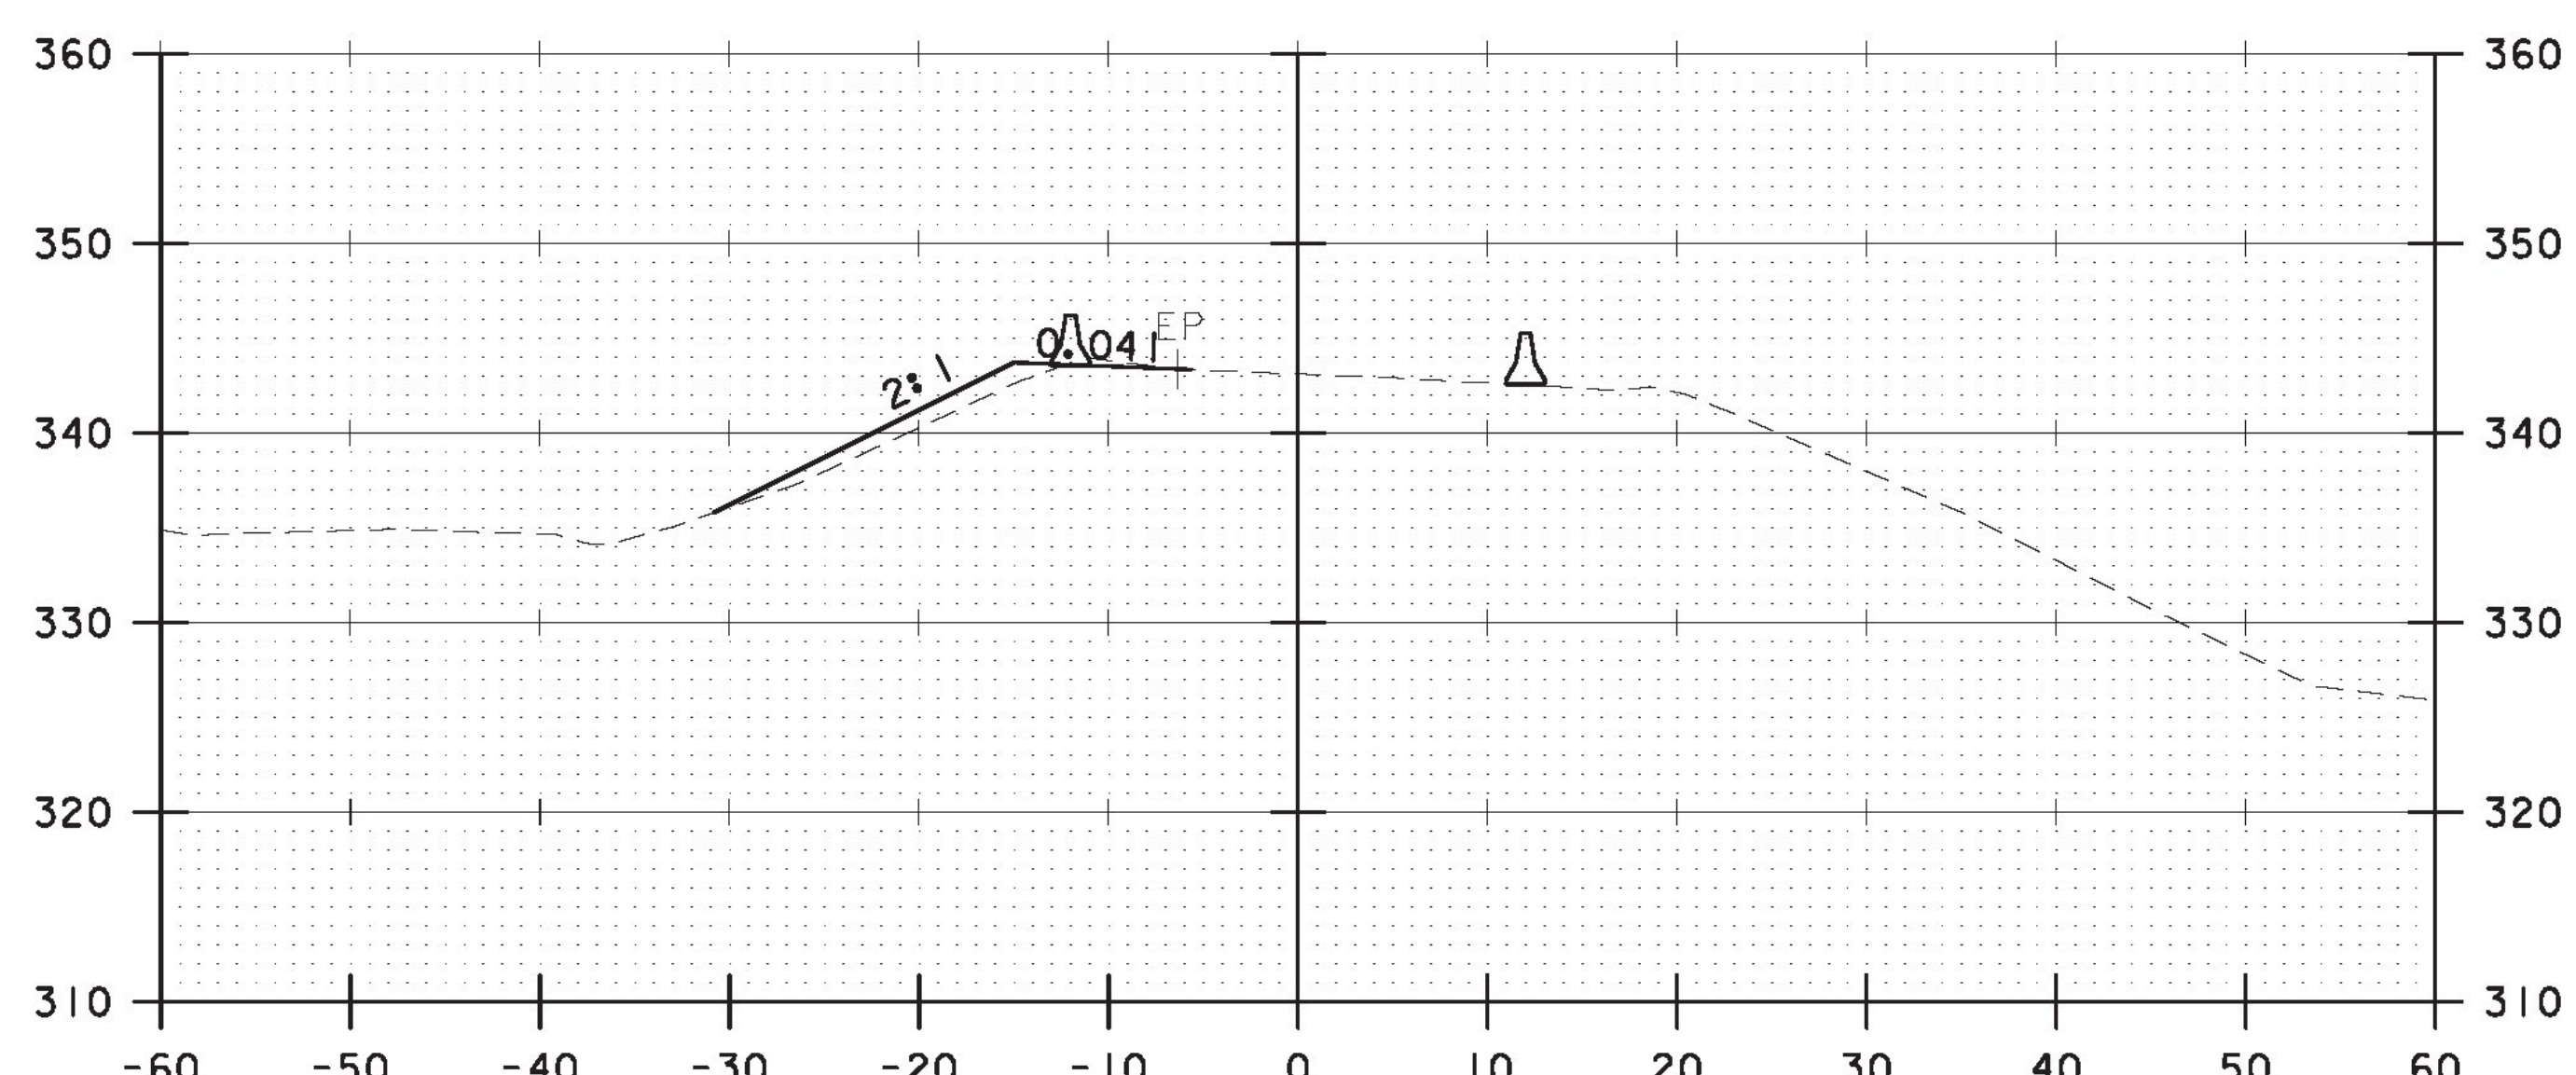

14+00

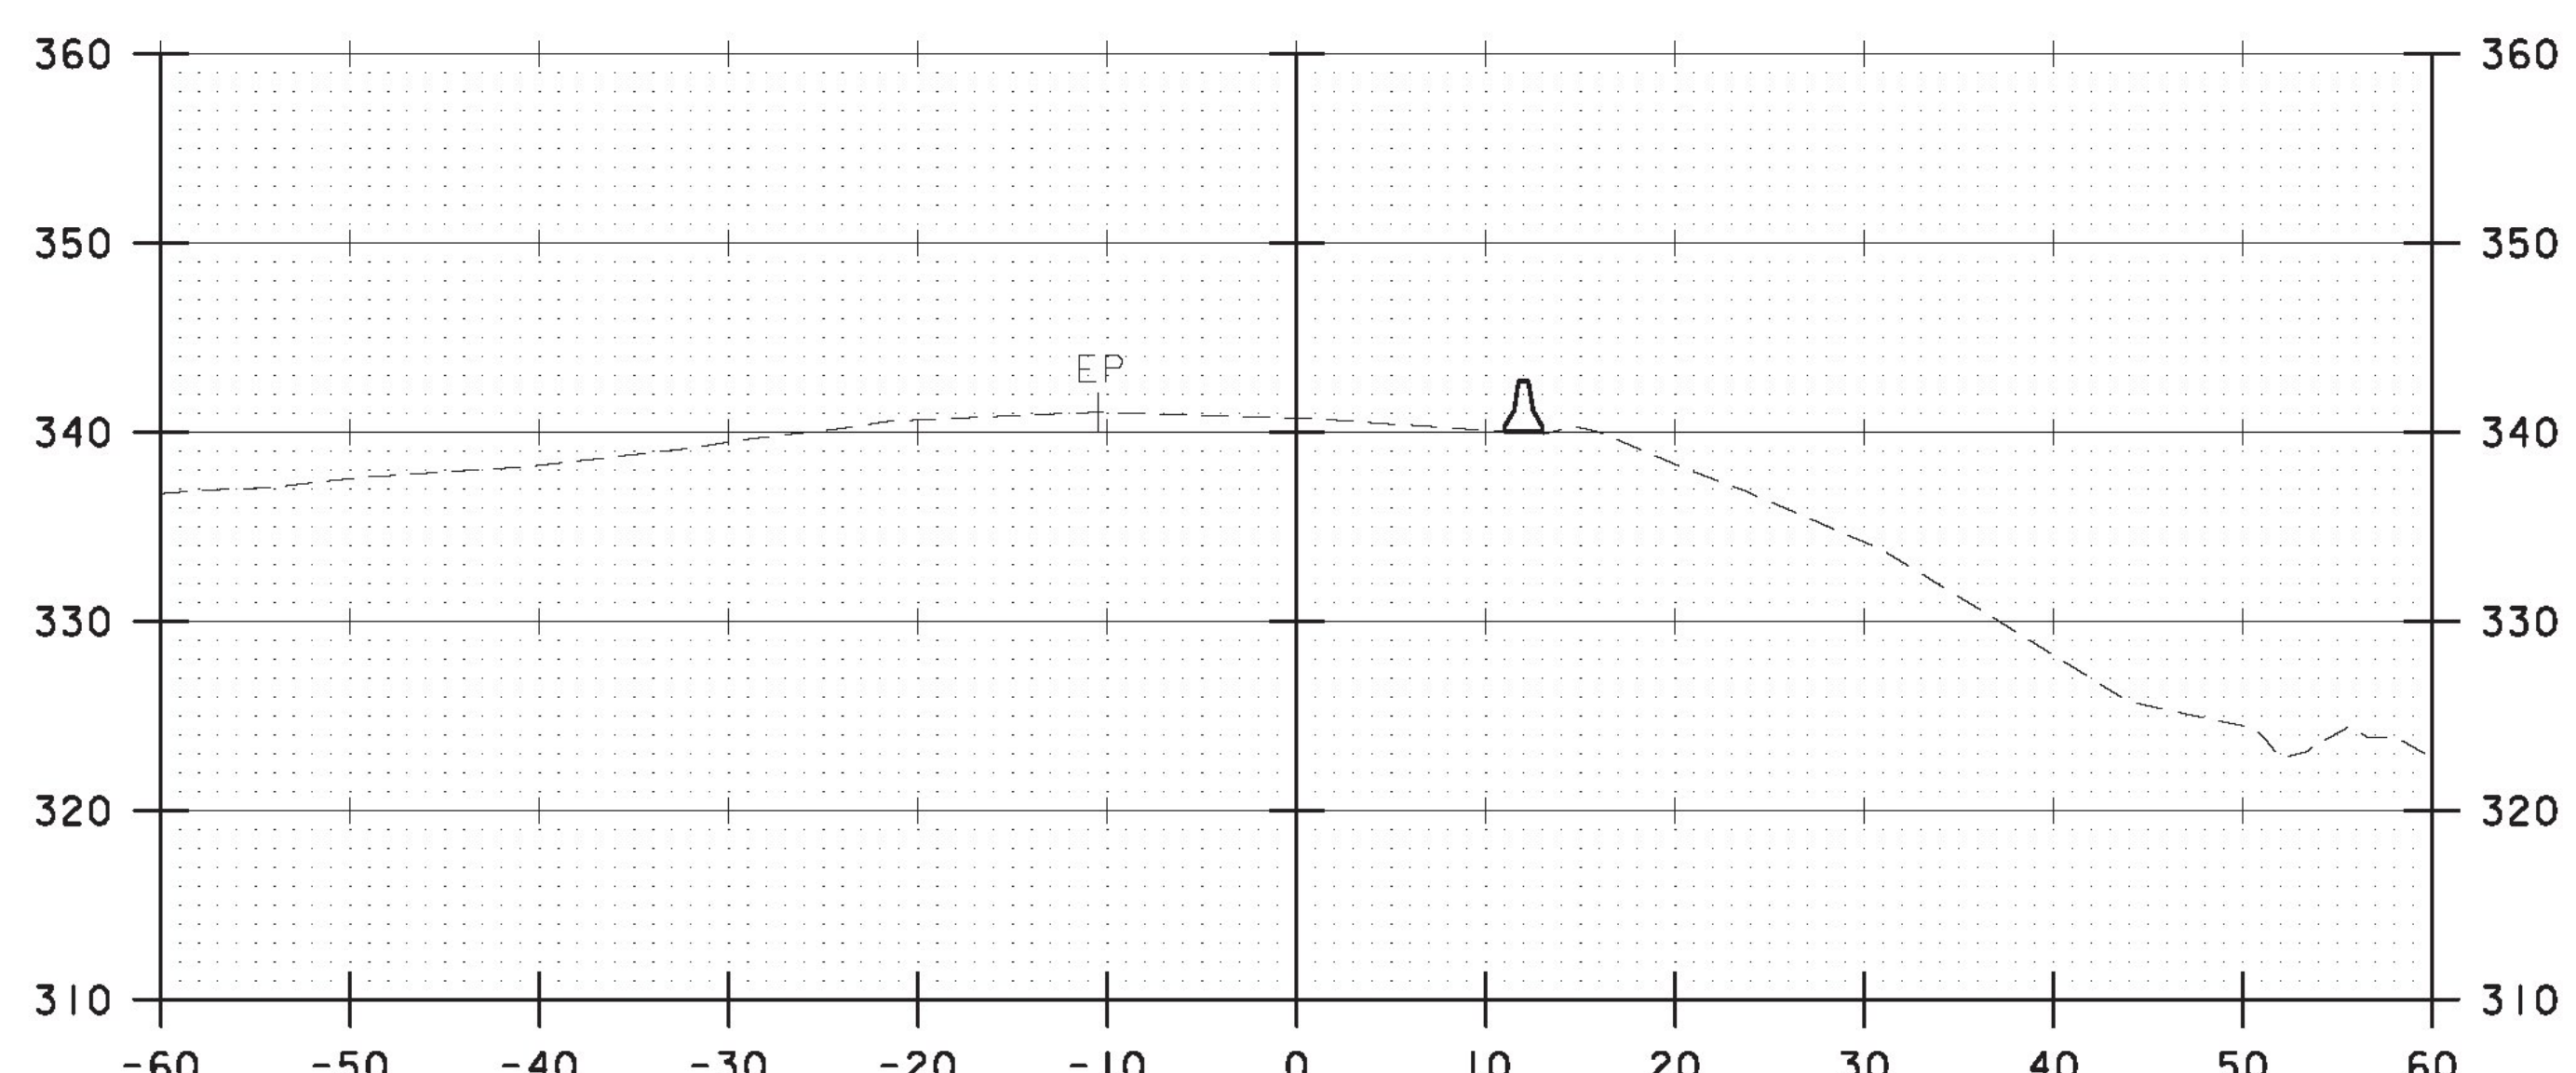

14+50

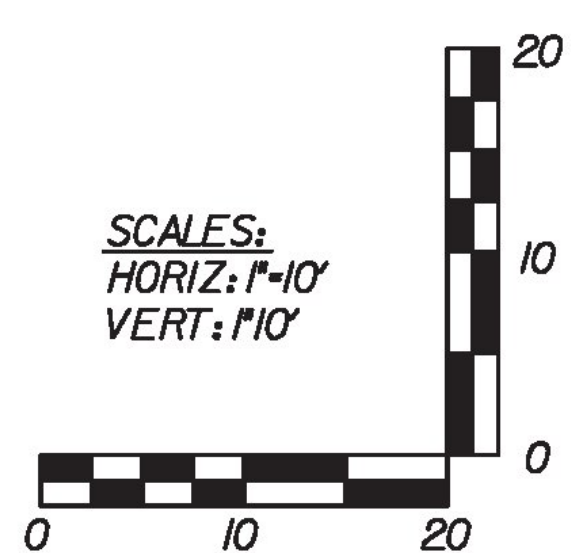

SCALES:  
HORIZ: 1"=10'  
VERT: 1"=10'

RFC - 12/21/2010  
WILLIAMS STREET DETOUR

WILLIAMS STREET  
STA. 14+00 TO STA. 14+75

PROJECT NAME: BRATTLEBORO  
PROJECT NUMBER: 1M 091-(150)

**AS BUILT  
RECORD PLANS**

**BECK & BELLUCCI, INC.** **TYLIN INTERNATIONAL**

FILE NAME: HW-100-WSD-900.dgn PLOT DATE: 12/21/2010  
PROJECT LEADER: Brian W. Clogston P.E. DRAWN BY: J. R. Howe P.E.  
DESIGNED BY: Phillip E. Kendall P.E. CHECKED BY: J. R. Howe P.E.  
WILLIAMS STREET DETOUR CROSS SECTIONS SHEET HW-100-WSD-905