


14+88

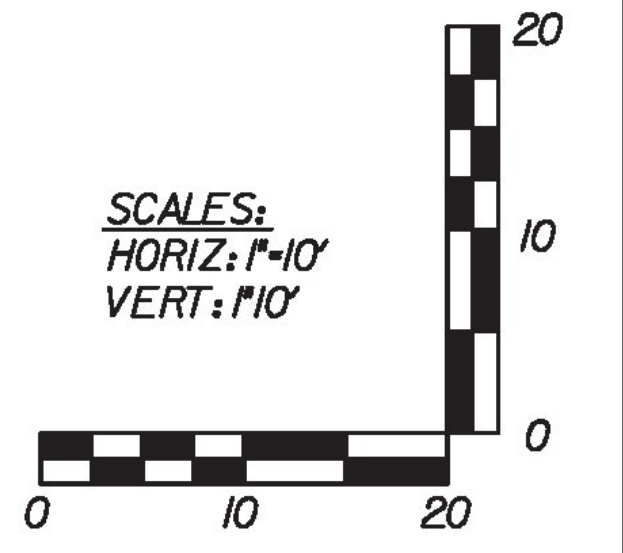

WILLIAMS STREET
 STA. 14+88 TO STA. 14+88

RFC - 12/21/2010
 WILLIAMS STREET DETOUR

PROJECT NAME: BRATTLEBORO
 PROJECT NUMBER: 1M 091-(150)

**AS BUILT
 RECORD PLANS**

BECK & BELLUCCI, INC. **TYLIN INTERNATIONAL**

FILE NAME: HW-100-WSD-900.dgn PLOT DATE: 12/21/2010
 PROJECT LEADER: Brian W. Clogston P.E. DRAWN BY: J. R. Howe P.E.
 DESIGNED BY: Phillip E. Kendall P.E. CHECKED BY: J. R. Howe P.E.
 WILLIAMS STREET DETOUR CROSS SECTIONS SHEET HW-100-WSD-906