


- NOTES:
- EXISTING DETAIL LINE WORK IN THIS WINDOW IS GRAPHICAL ONLY AND IS SHOWN TO PROVIDE PERSPECTIVE FOR SIGN PLACEMENT.
 - SEE SHEET HW-100-NC0-501 FOR LEGEND.
 - PLACE PORTABLE CHANGEABLE MESSAGE SIGN AT MILE MARKER 11.00 TO INFORM OF UPCOMING TRAFFIC PATTERN CHANGE.

**AS BUILT
RECORD PLANS**

**RFC - WORK PACKAGE #2A
MARCH 21, 2011**

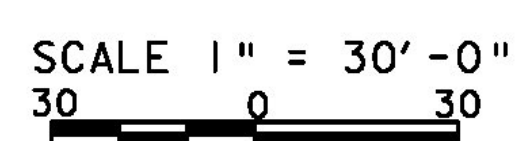

BECK & BELLUCCI, INC. **TYLIN INTERNATIONAL**

| | |
|--|----------------------------|
| PROJECT NAME: BRATTLEBORO | PLOT DATE: 3/18/2011 |
| PROJECT NUMBER: 1M 091-(150) | DRAWN BY: J. R. Howe P.E. |
| FILE NAME: HW-100-NC0-507.dgn | CHECKED BY: D. Bryant P.E. |
| PROJECT LEADER: Brian W. Clogston P.E. | SHEET HW-100-NC0-507 |
| DESIGNED BY: Phillip E. Kendall P.E. | |
| NORTHBOUND CLOSURE TCP 7 OF 7 | |