




3001+00

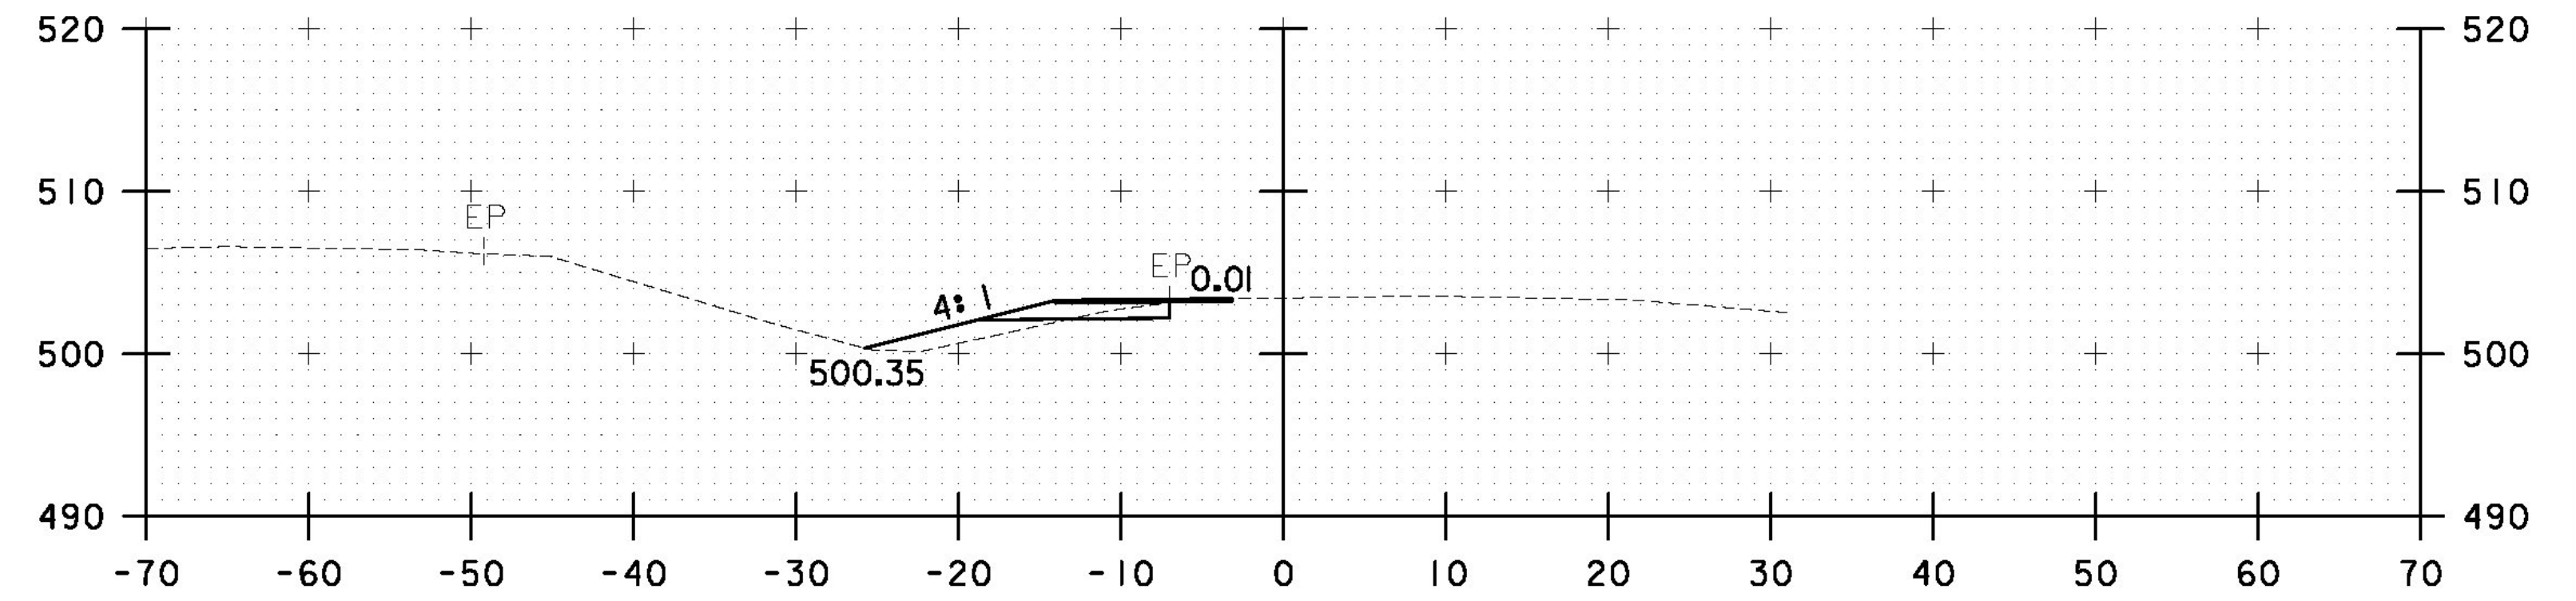


3002+50

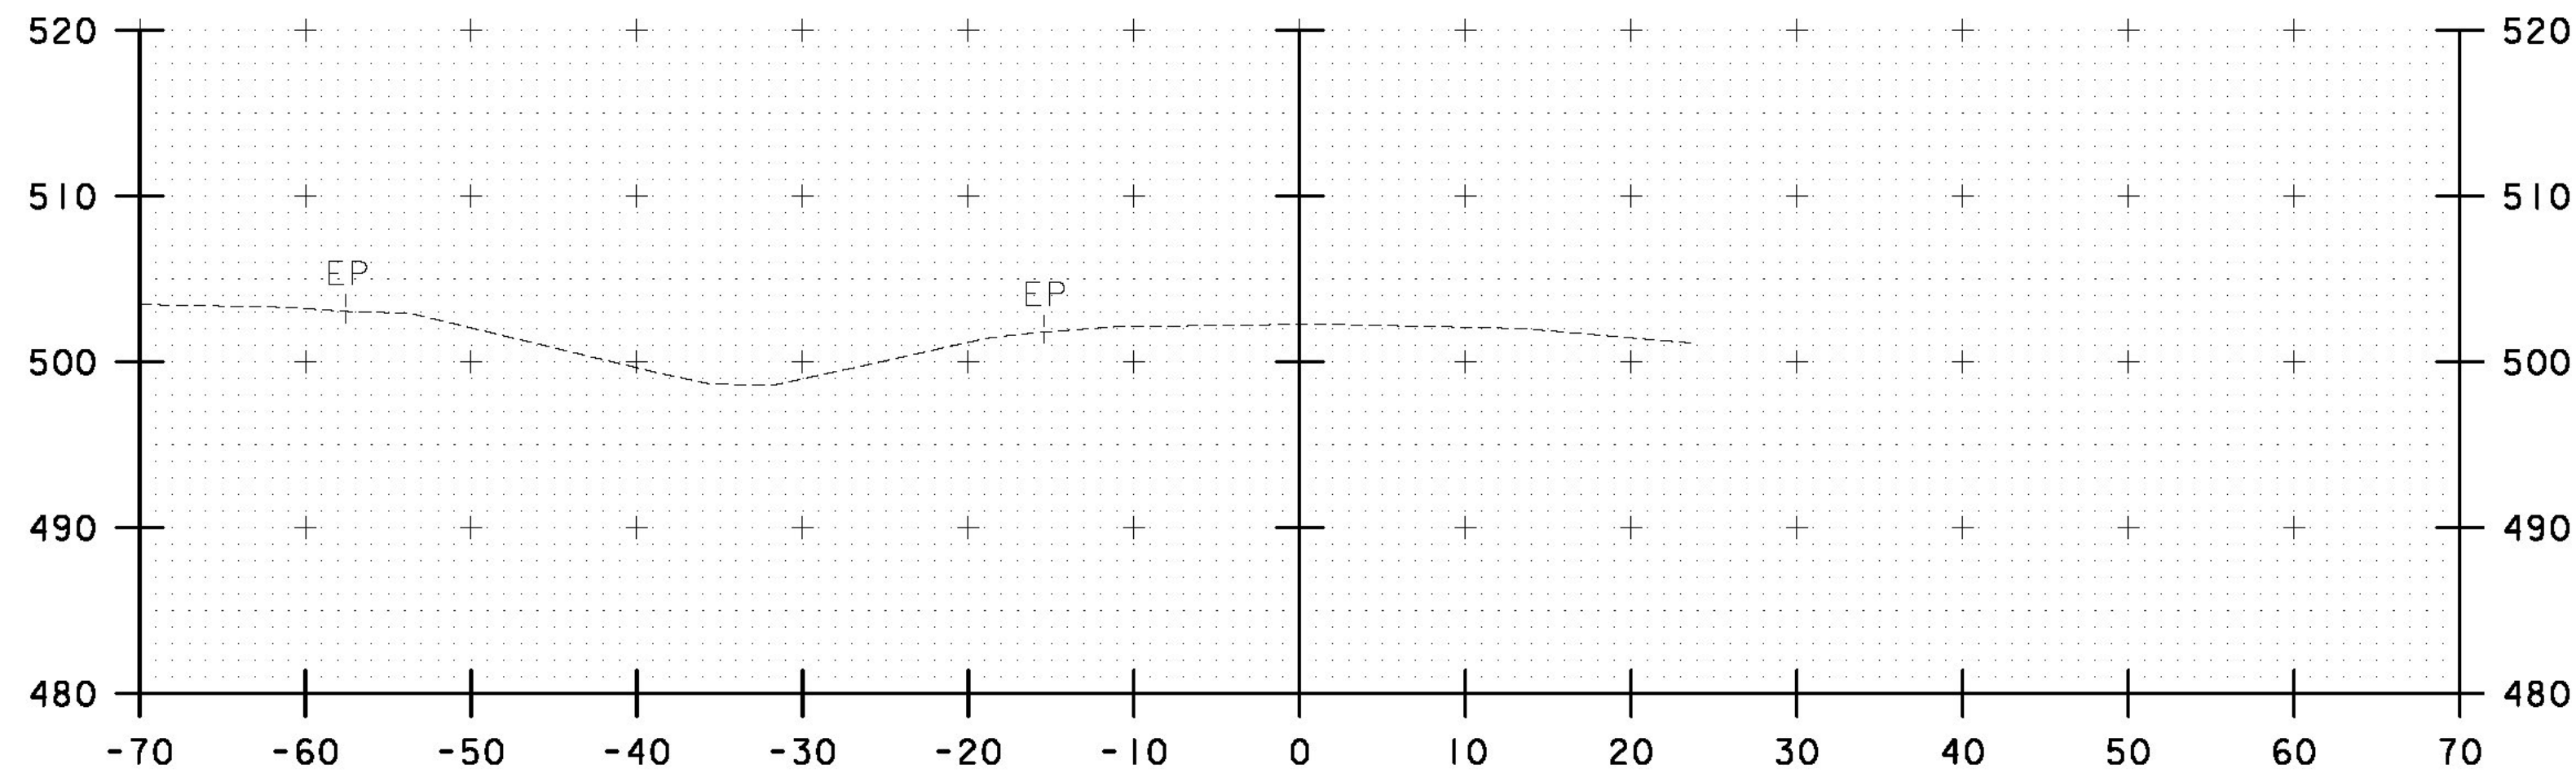


3000+50

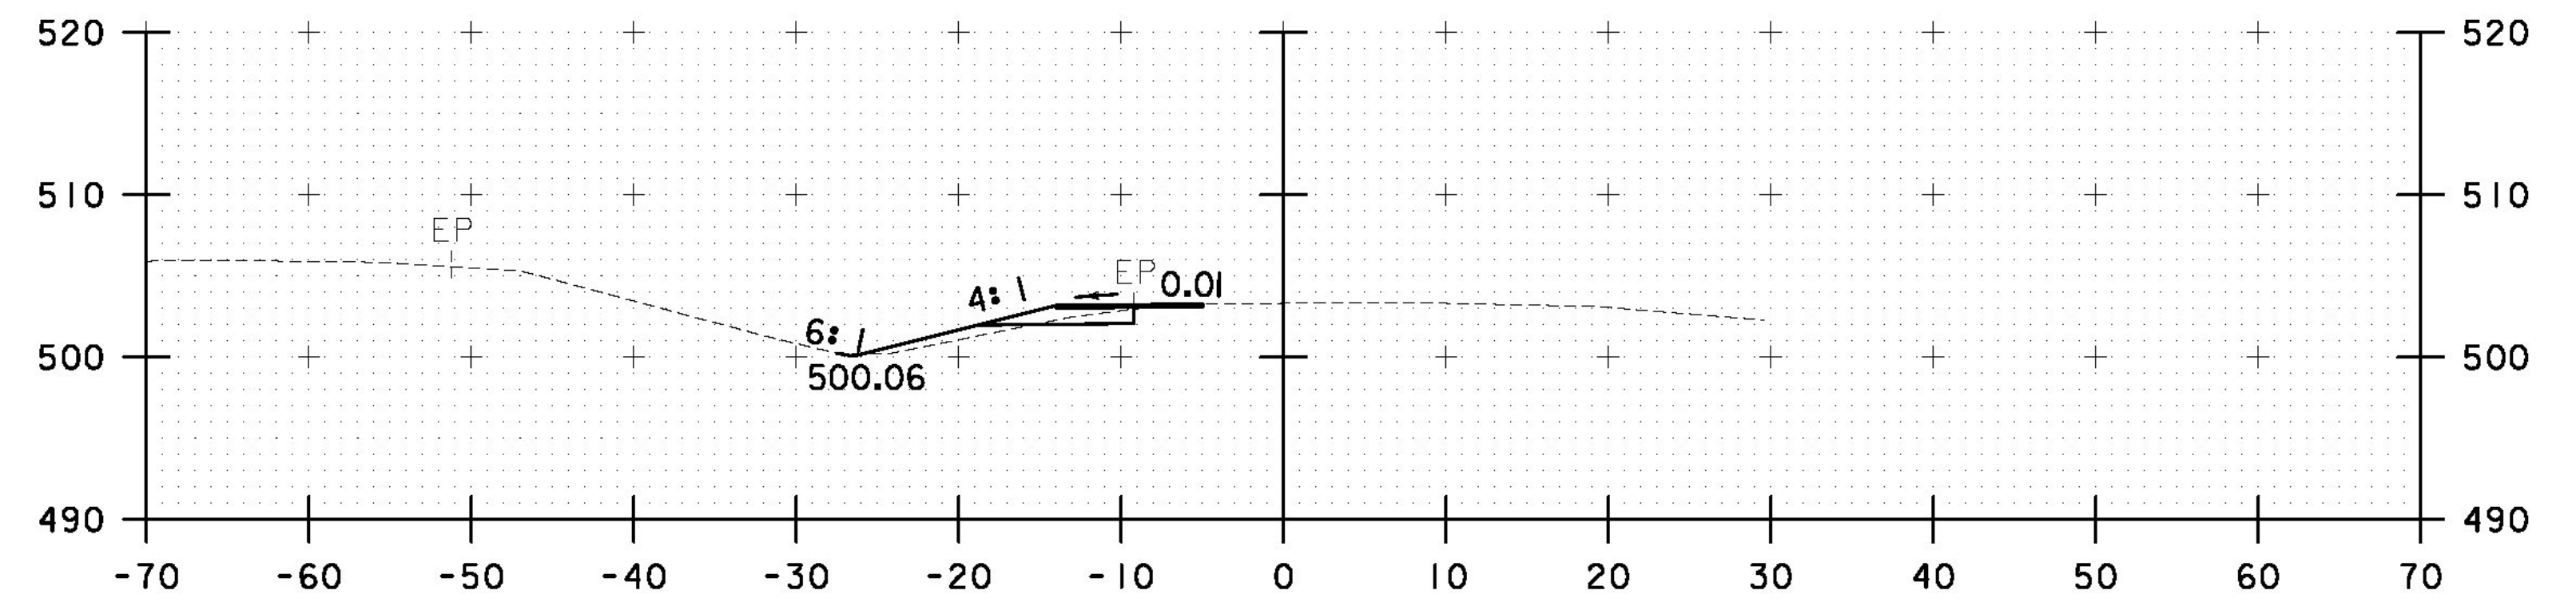


3002+00

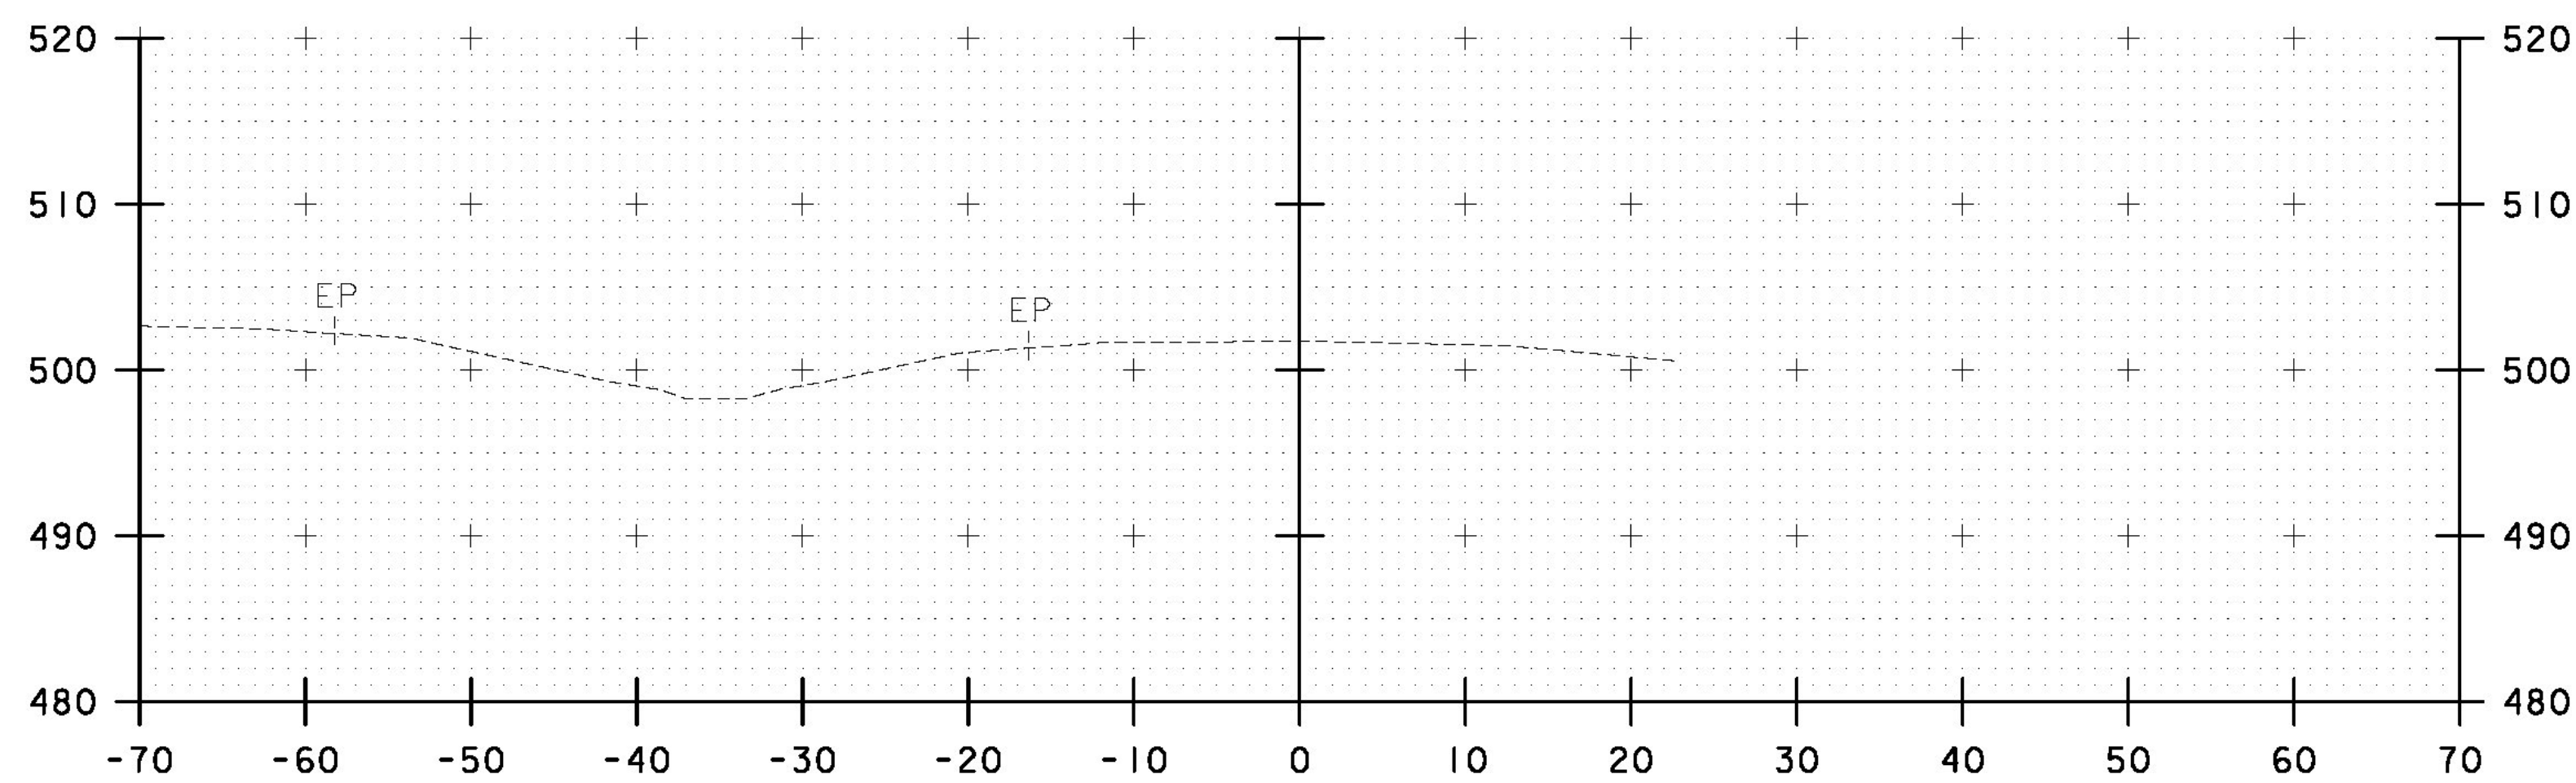

3000+00

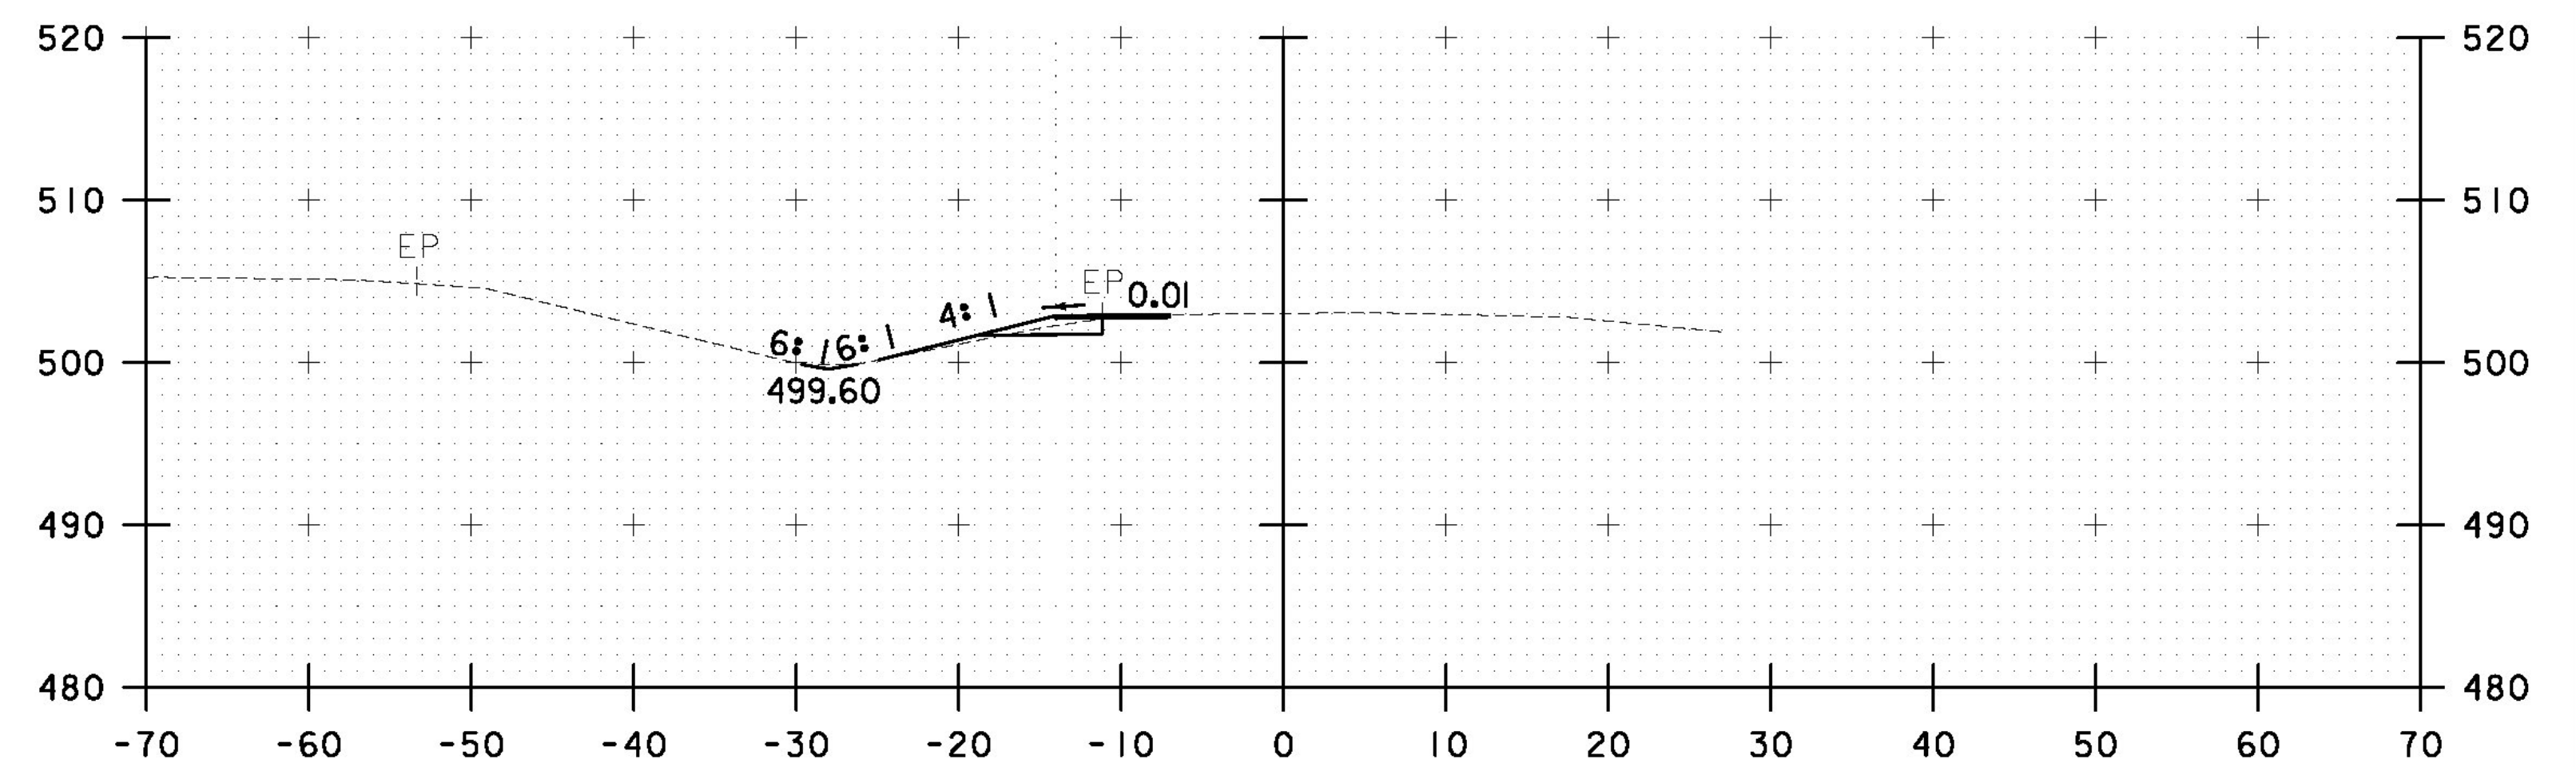

3001+50

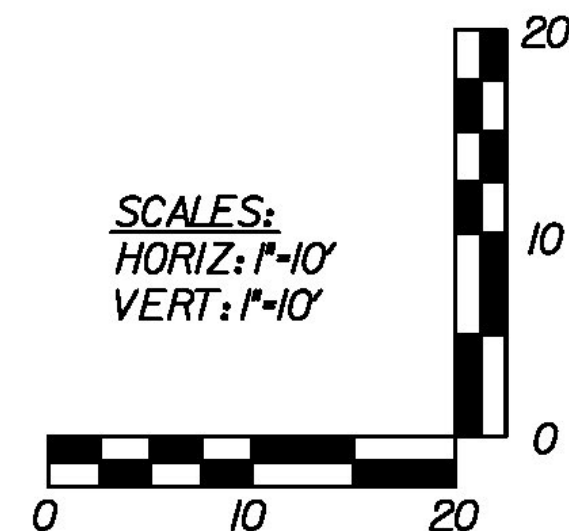

**AS BUILT
RECORD PLANS**

**RFC - WORK PACKAGE #2A
MARCH 21, 2011**

BECK & BELLUCCI, INC.

TYLIN INTERNATIONAL

SOUTH END
STA. 3000+00 TO STA. 3002+50

PROJECT NAME: BRATTLEBORO

PROJECT NUMBER: 1M 091-(50)

FILE NAME: HW-100-NC0-900.dgn

PLOT DATE: 3/18/2011

PROJECT LEADER: Brian W. Clogston P.E.

DRAWN BY: J. R. Howe P.E.

DESIGNED BY: Phillip E. Kendall P.E.

CHECKED BY: D. BRYANT P.E.

NORTHBOUND CROSSOVER CROSS SECTIONS

SHEET HW-100-NC0-901