




3004+00

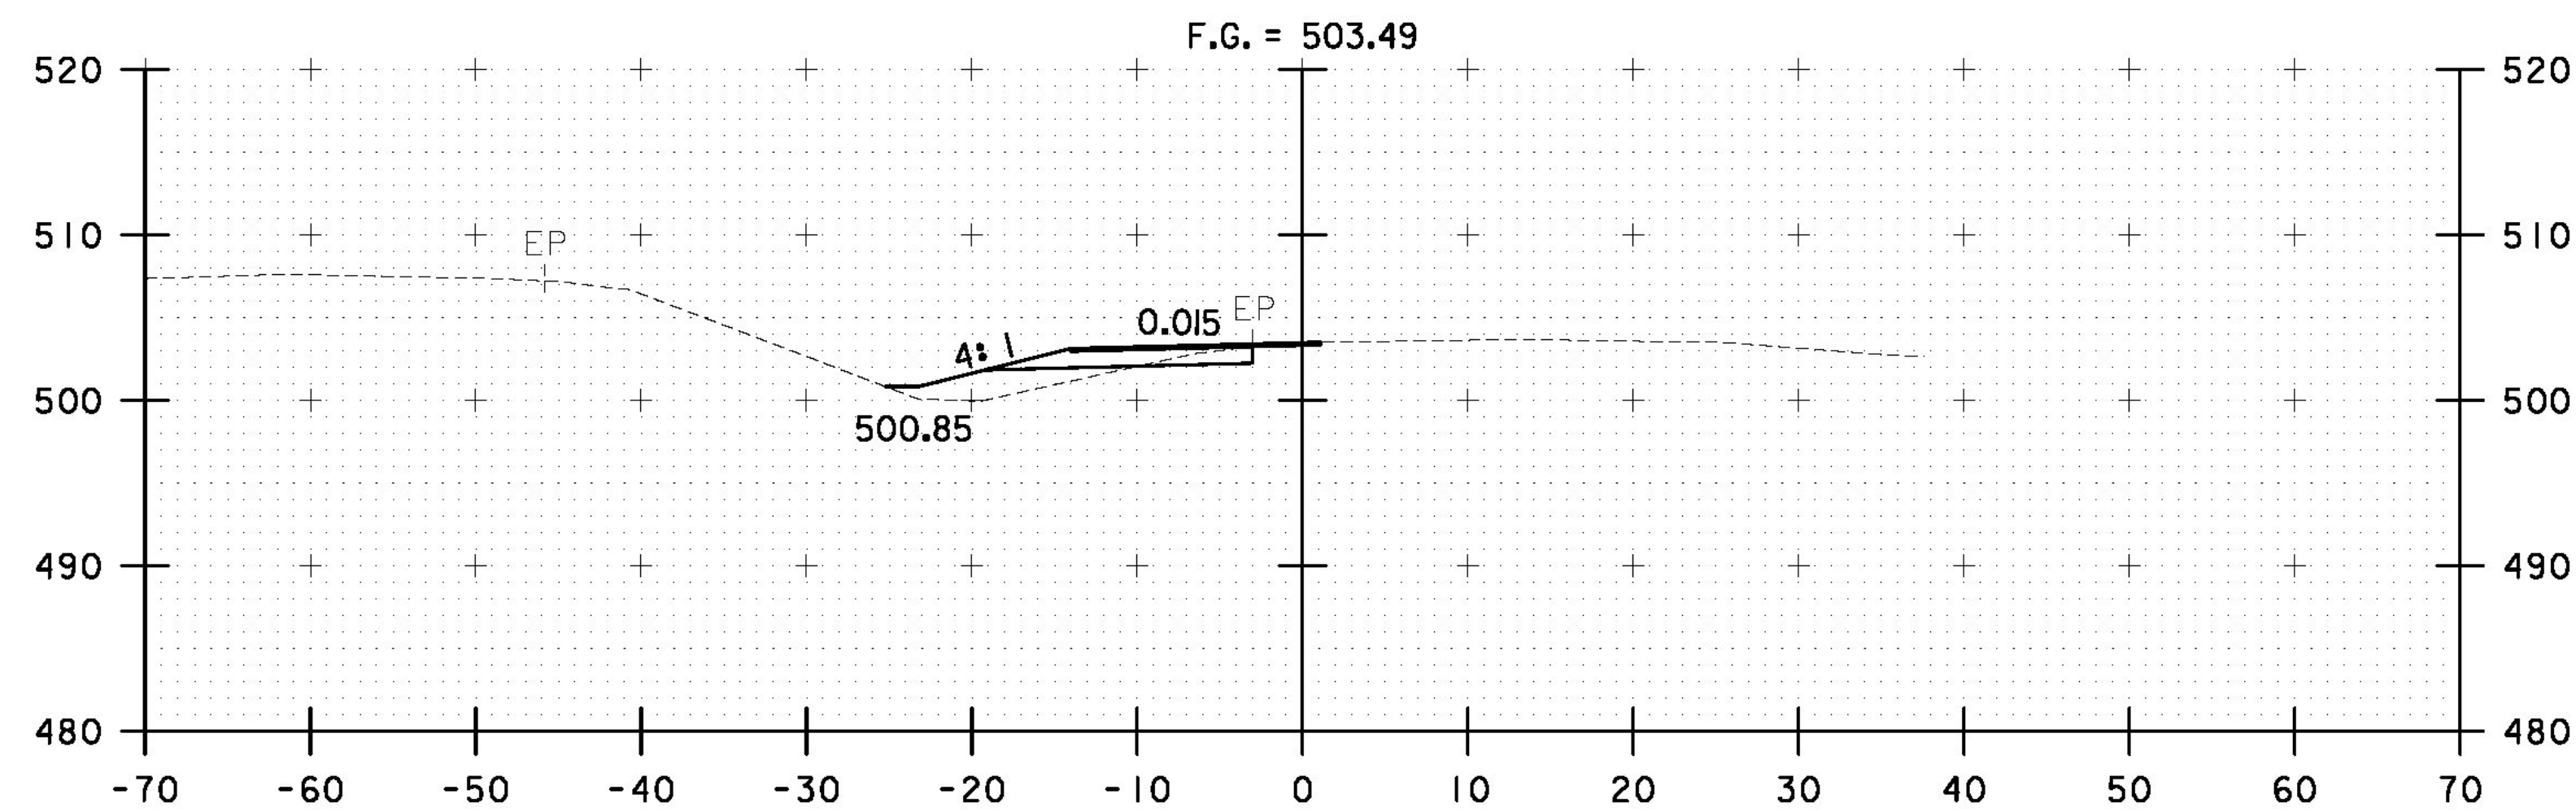


3003+50

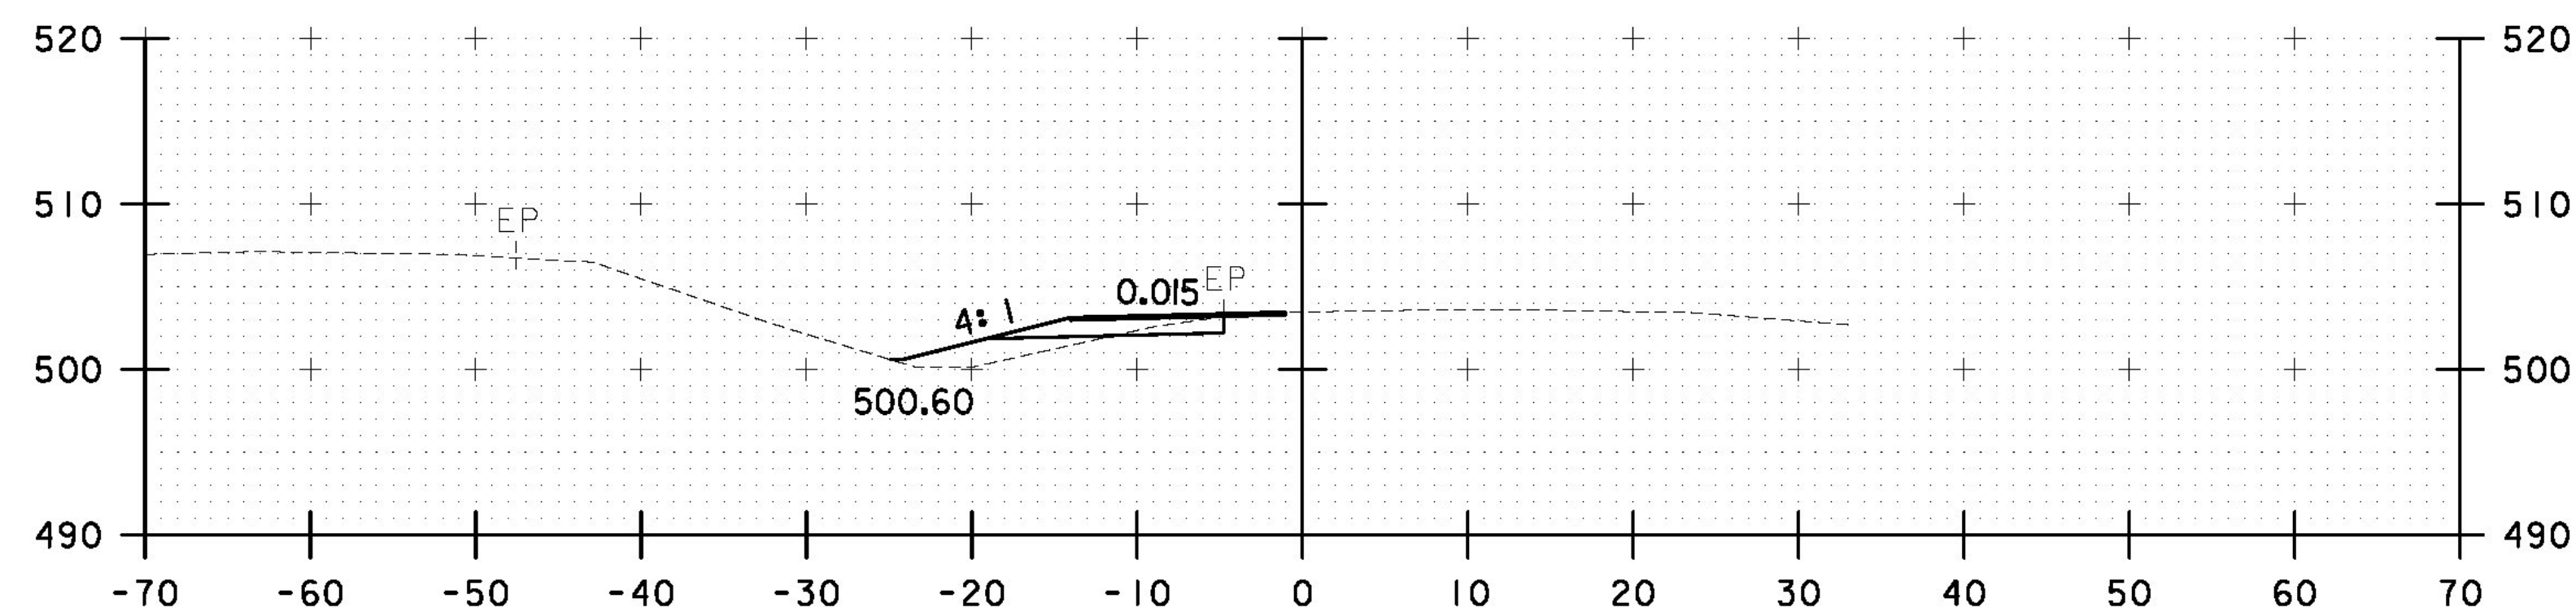


3003+00

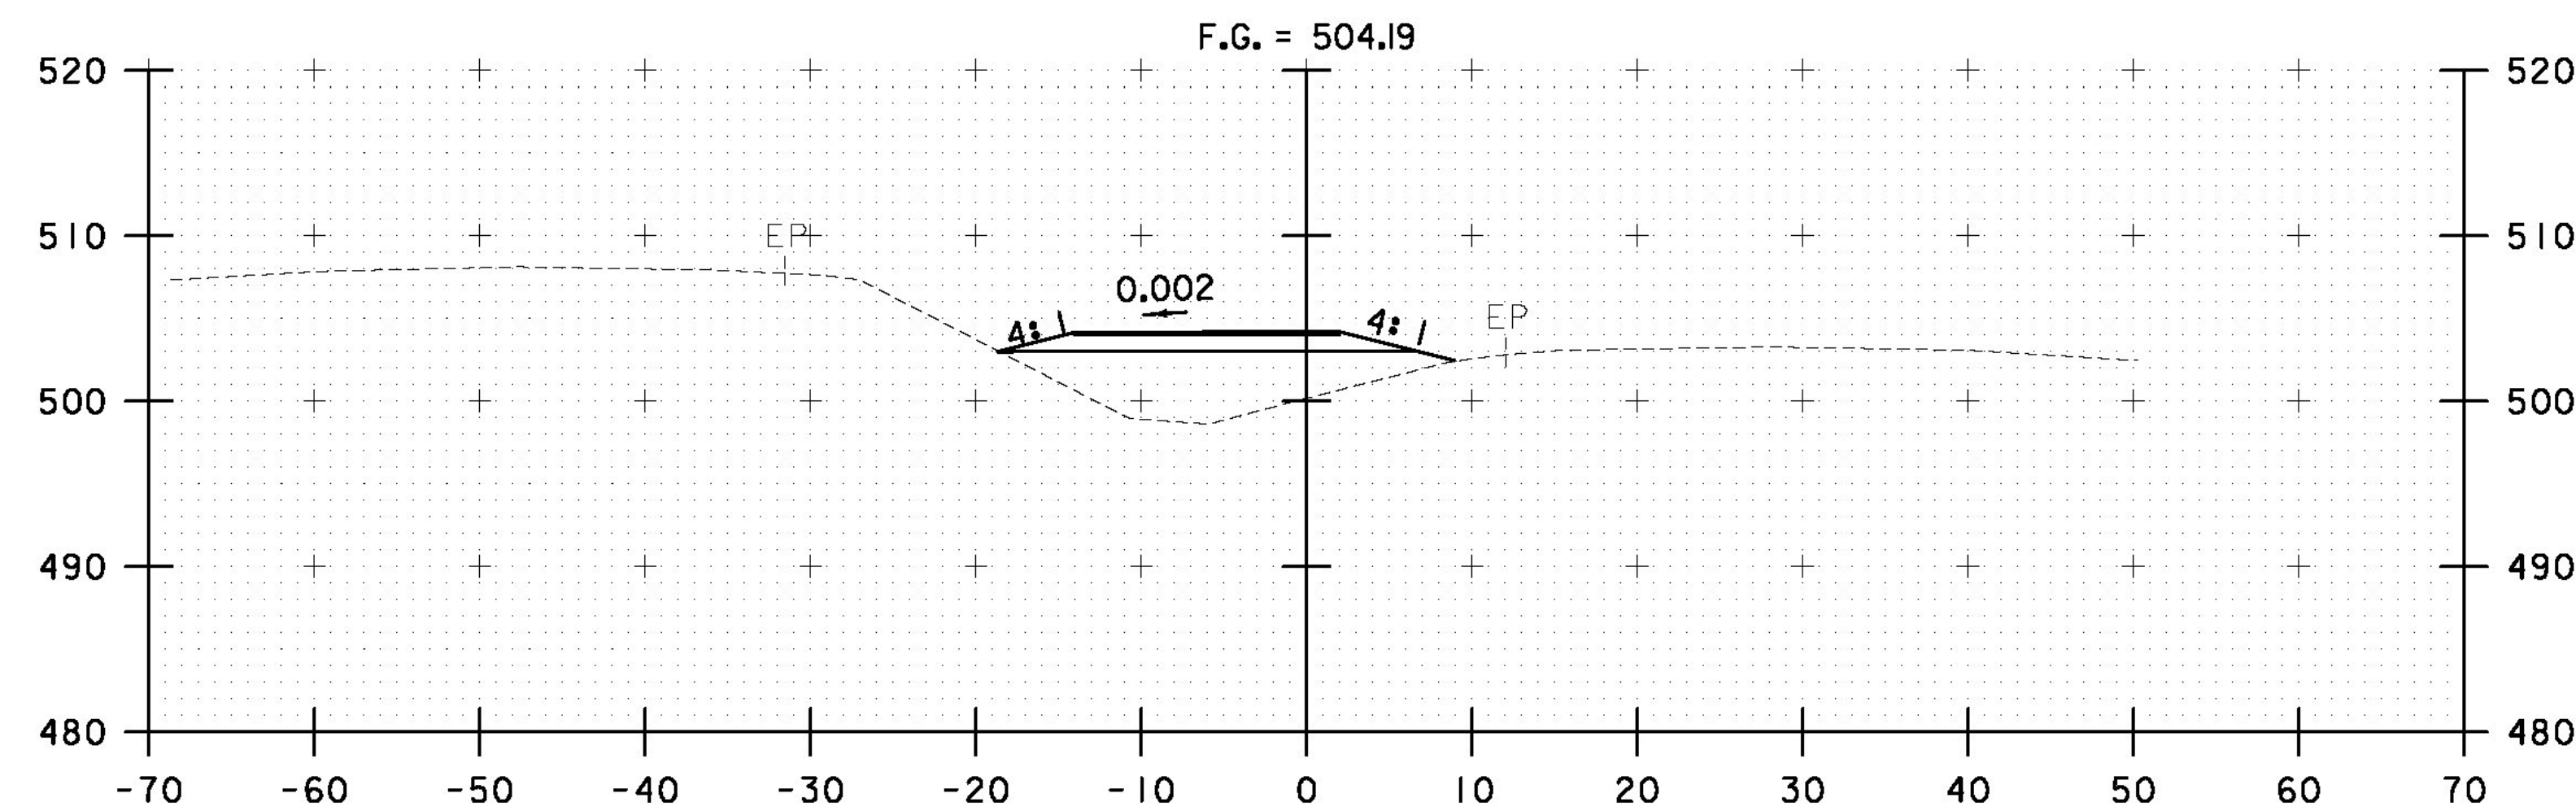


3005+50

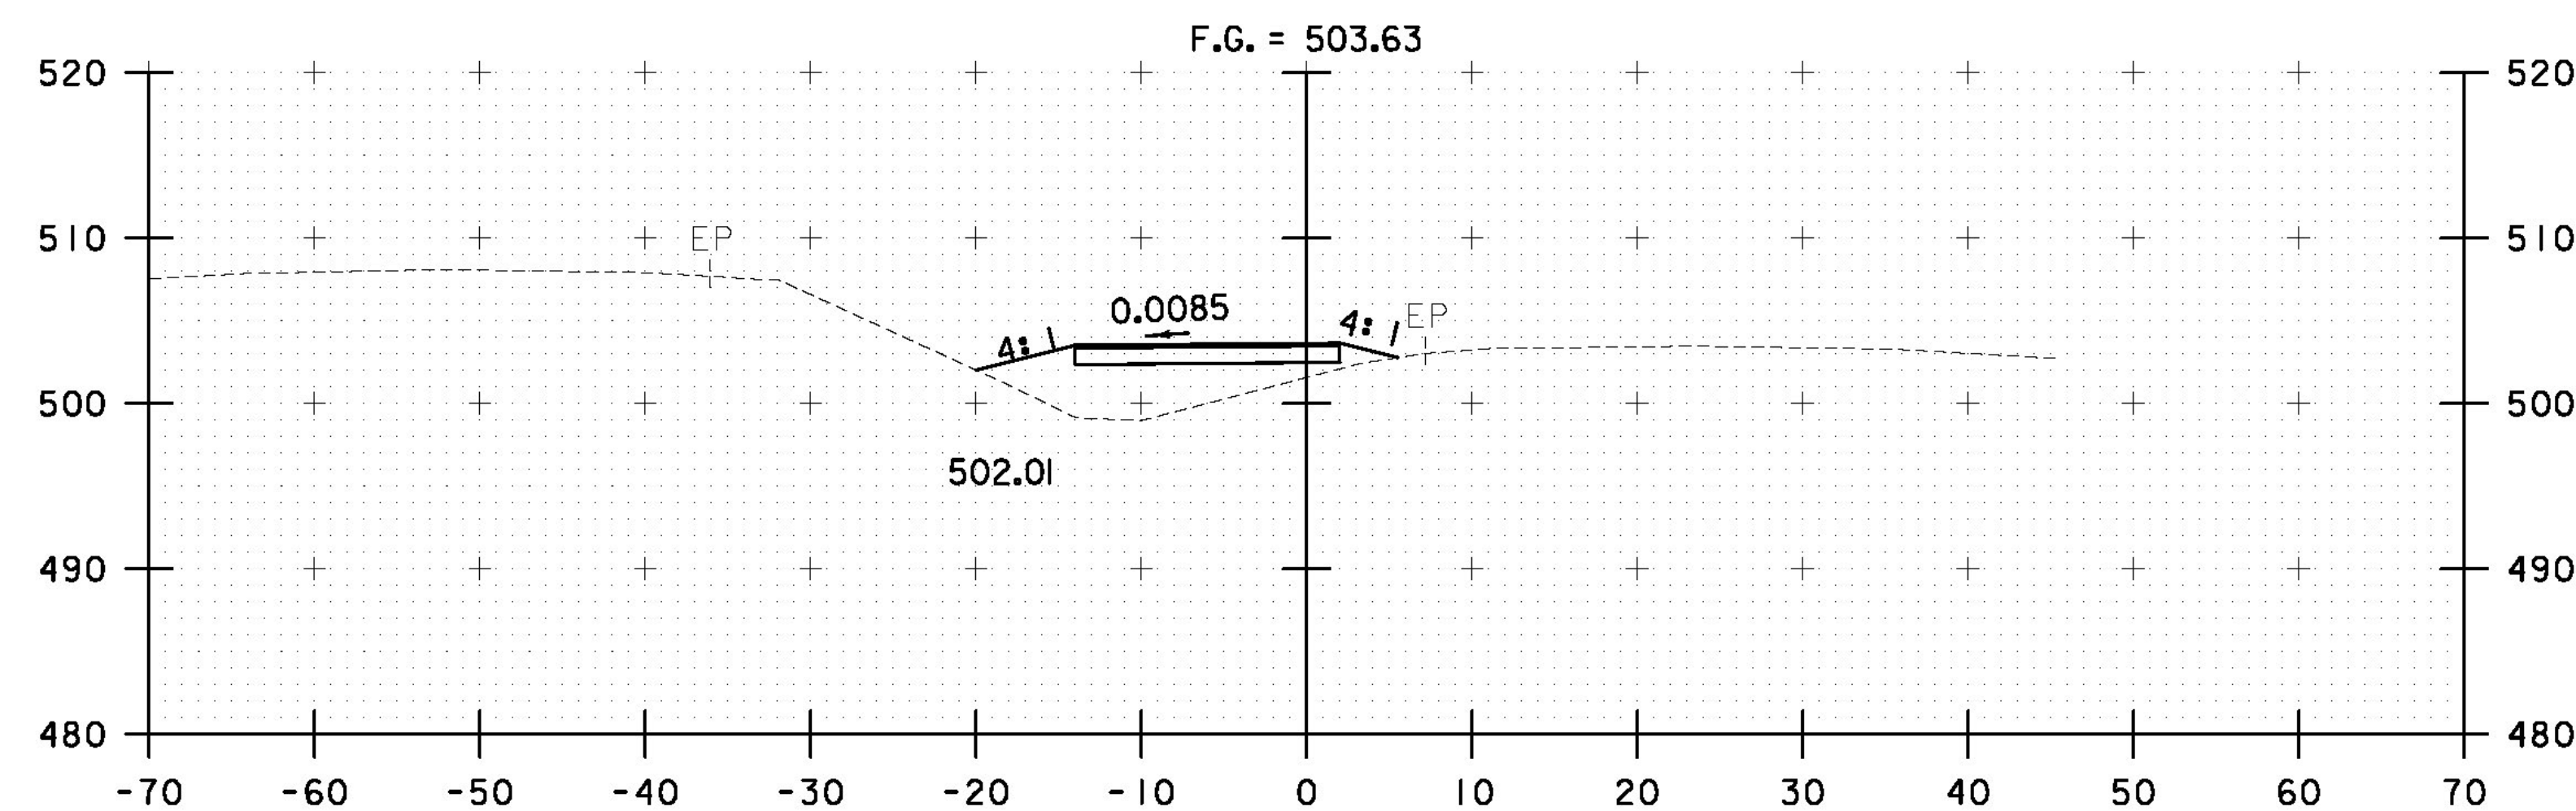

3005+00

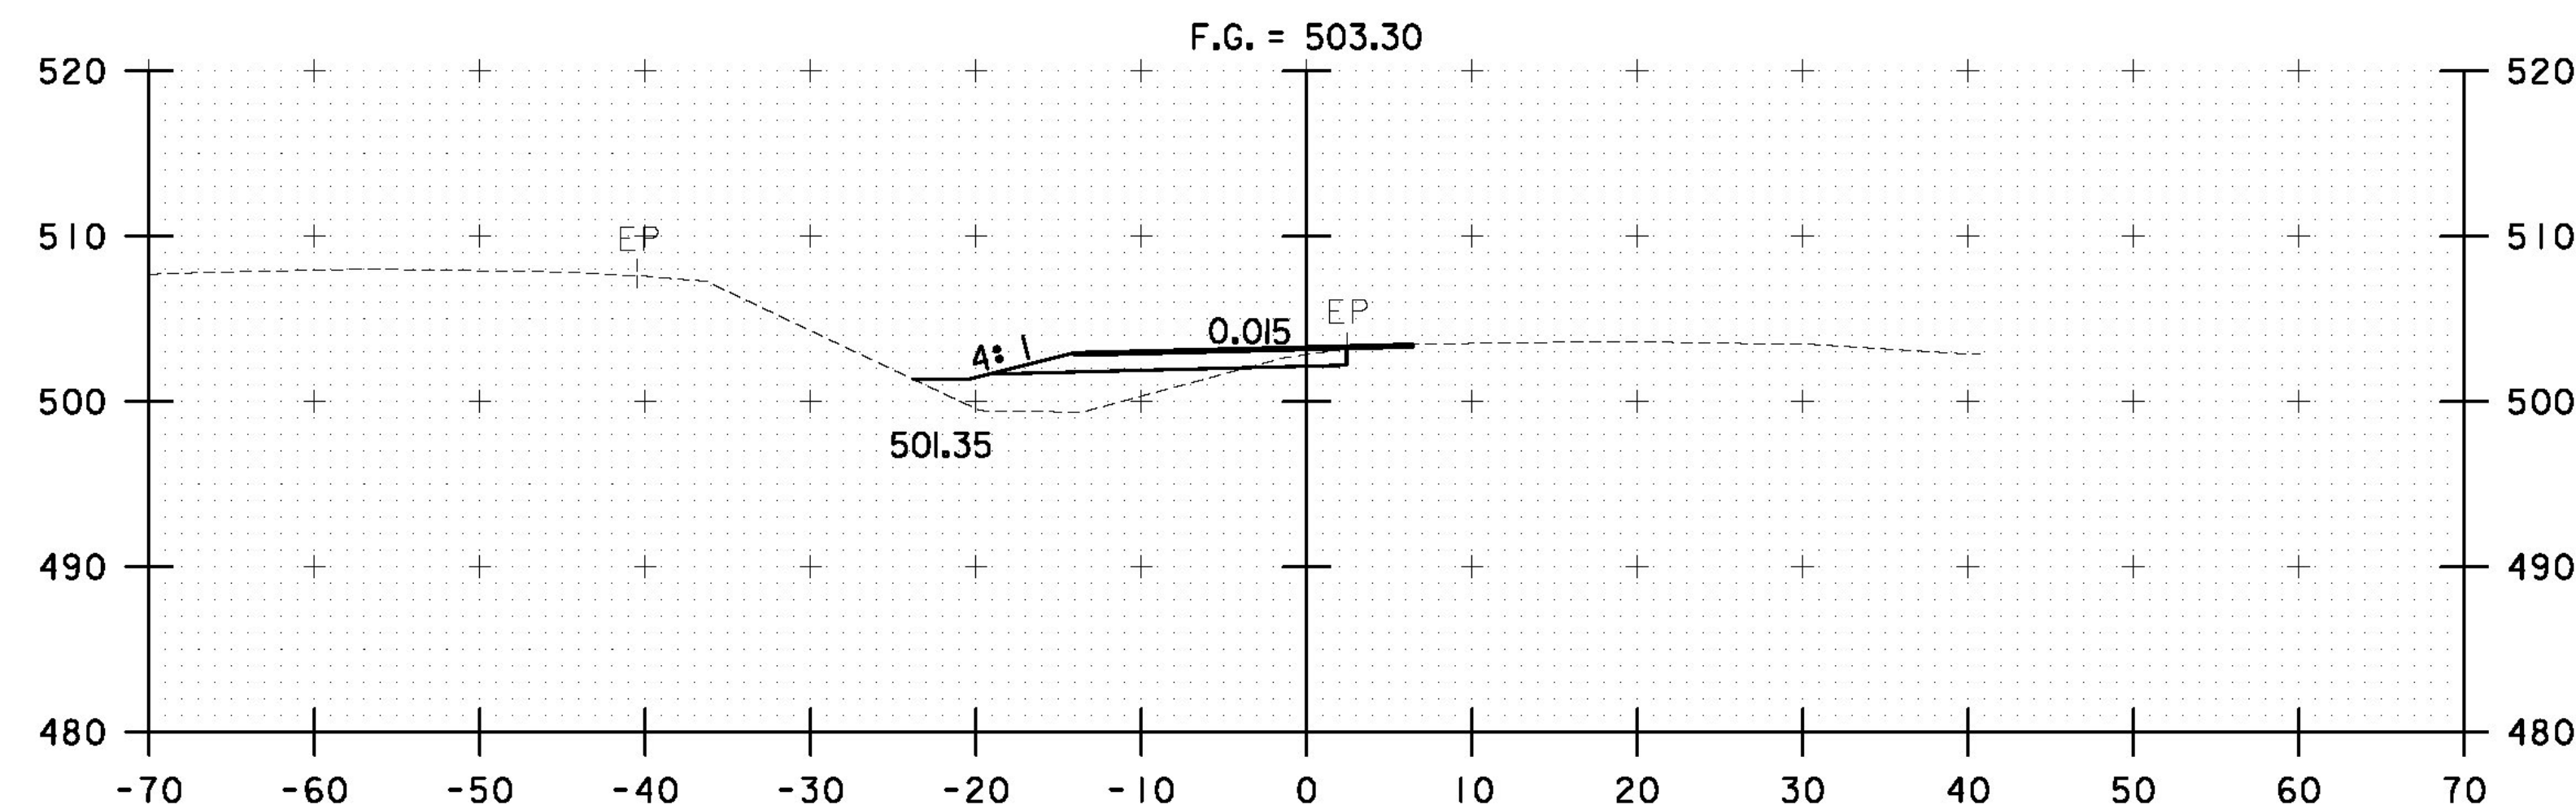

3004+50

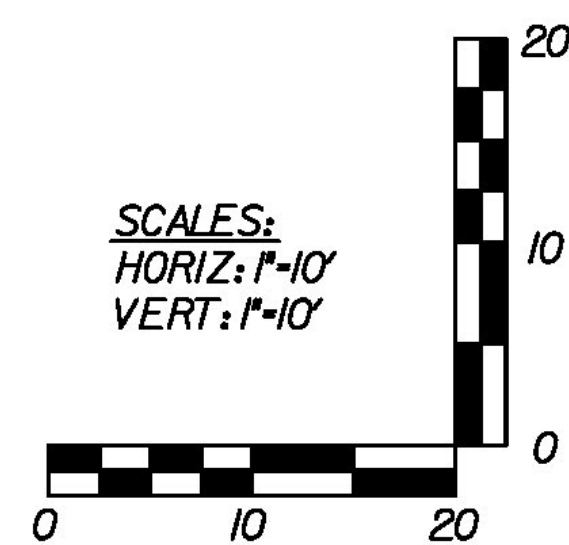

**AS BUILT
RECORD PLANS**

**RFC - WORK PACKAGE #2A
MARCH 21, 2011**

BECK & BELLUCCI, INC.

**SOUTH END
STA. 3003+00 TO STA. 3005+50**

PROJECT NAME: BRATTLEBORO

PROJECT NUMBER: 1M 091-(50)

FILE NAME: HW-100-NC0-900.dgn

PROJECT LEADER: Brian W. Clogston P.E.

DESIGNED BY: Phillip E. Kendall P.E.

NORTHBOUND CROSSOVER CROSS SECTIONS

PLOT DATE: 3/18/2011

DRAWN BY: J. R. Howe P.E.

CHECKED BY: D. BRYANT P.E.

SHEET HW-100-NC0-902