




3007+00

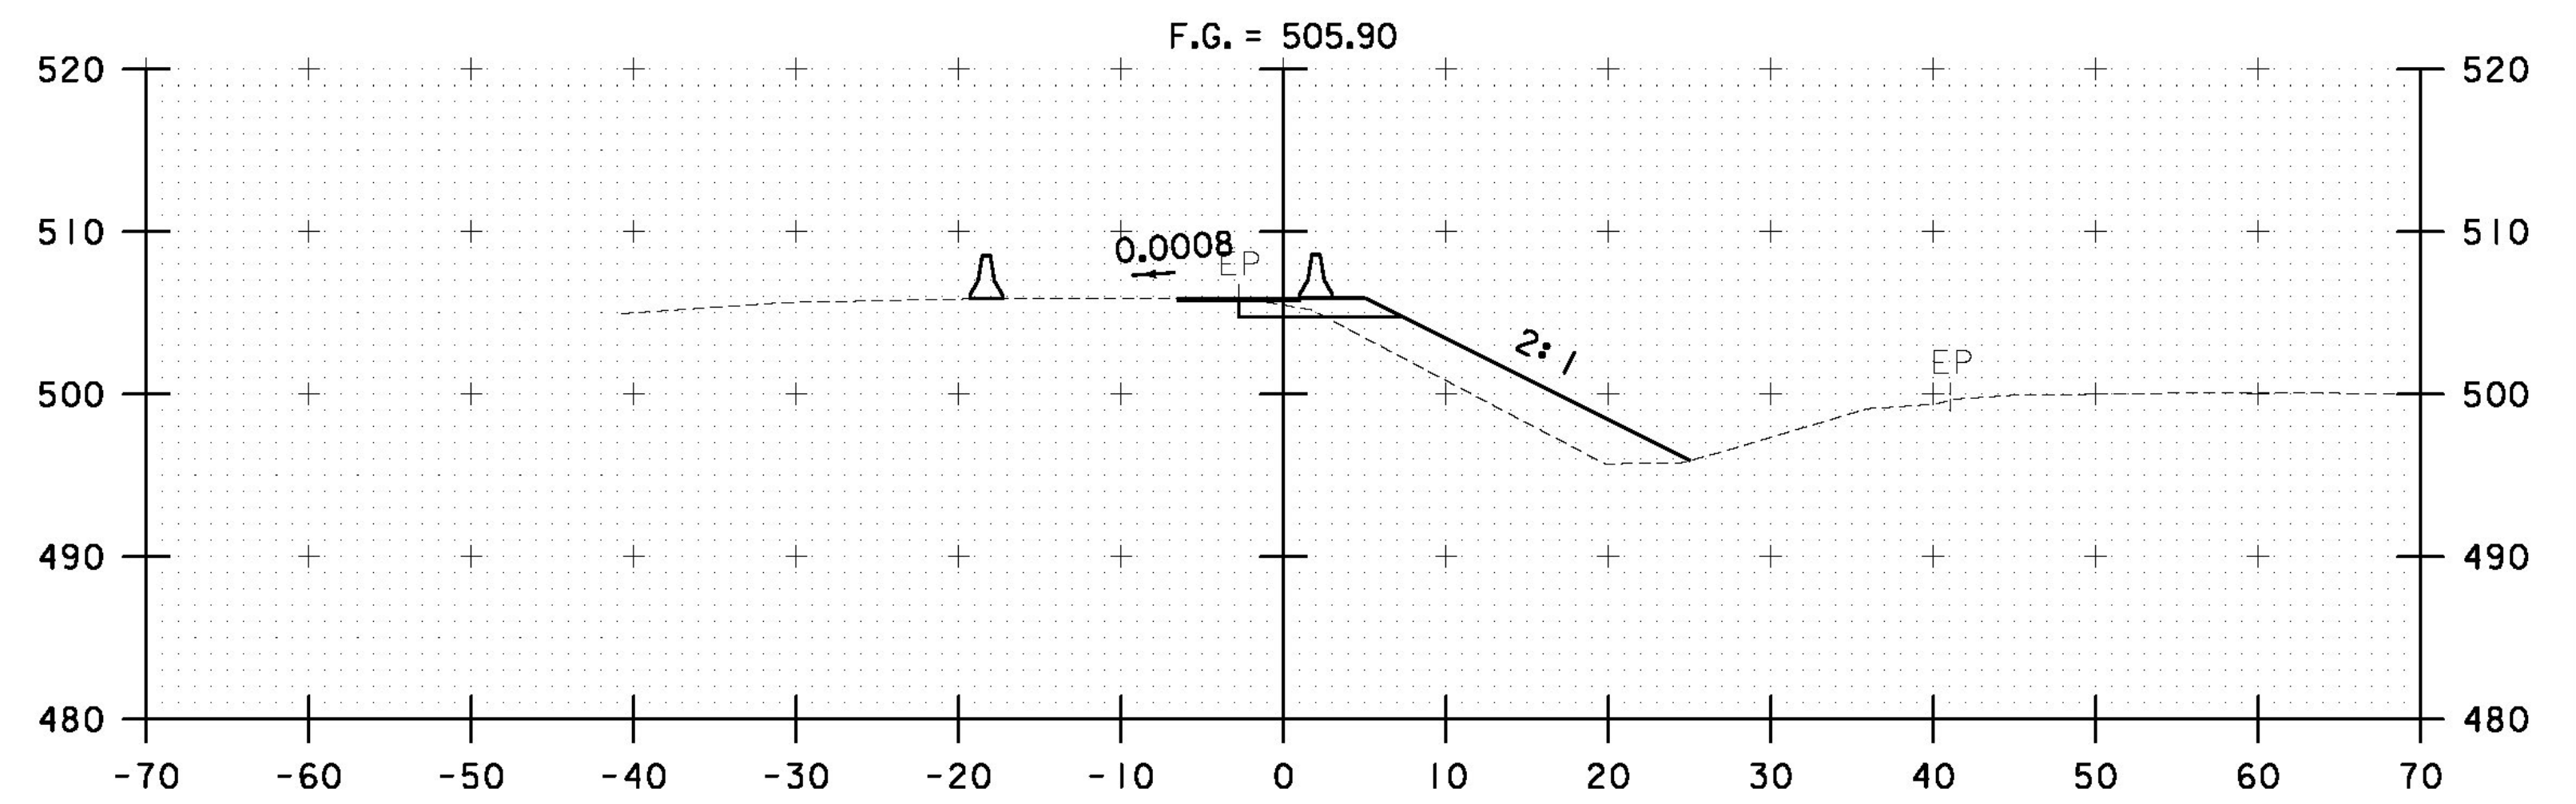


3008+50

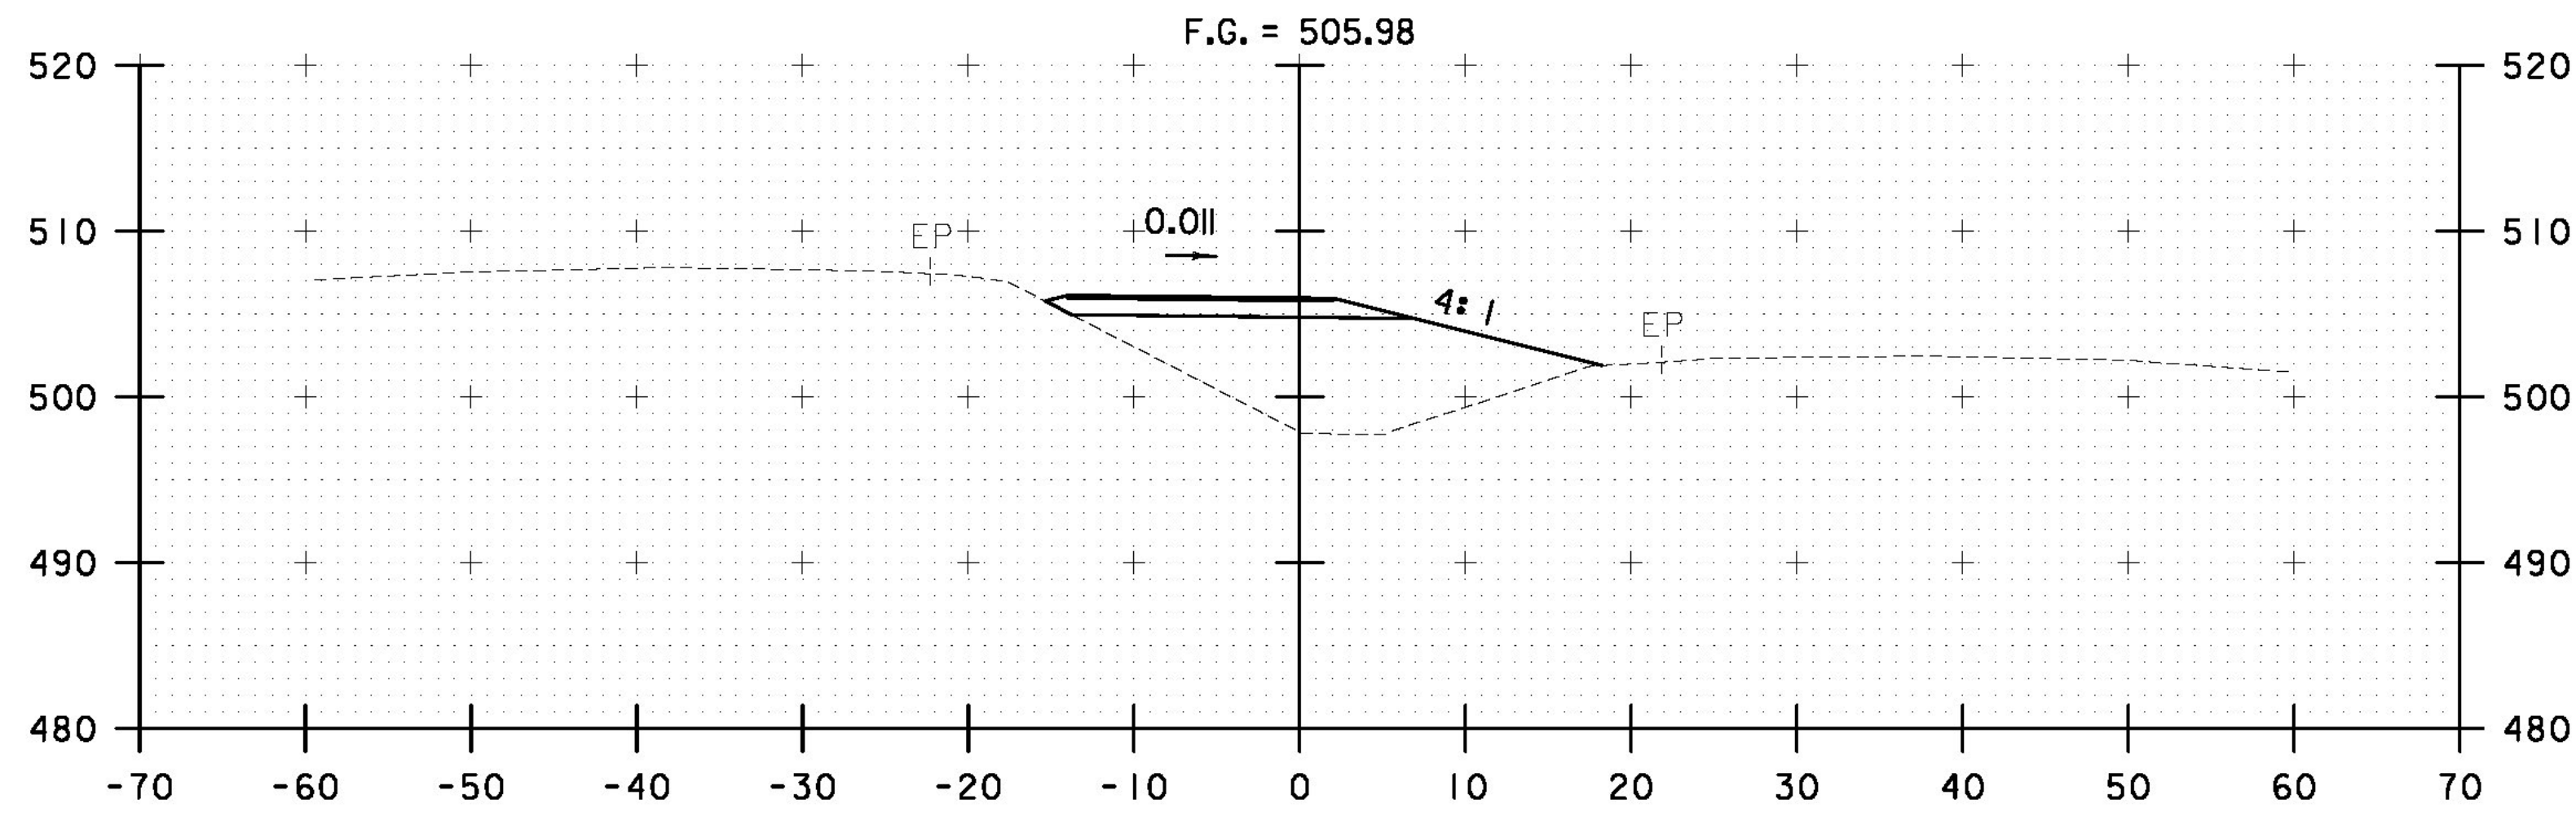


3006+50

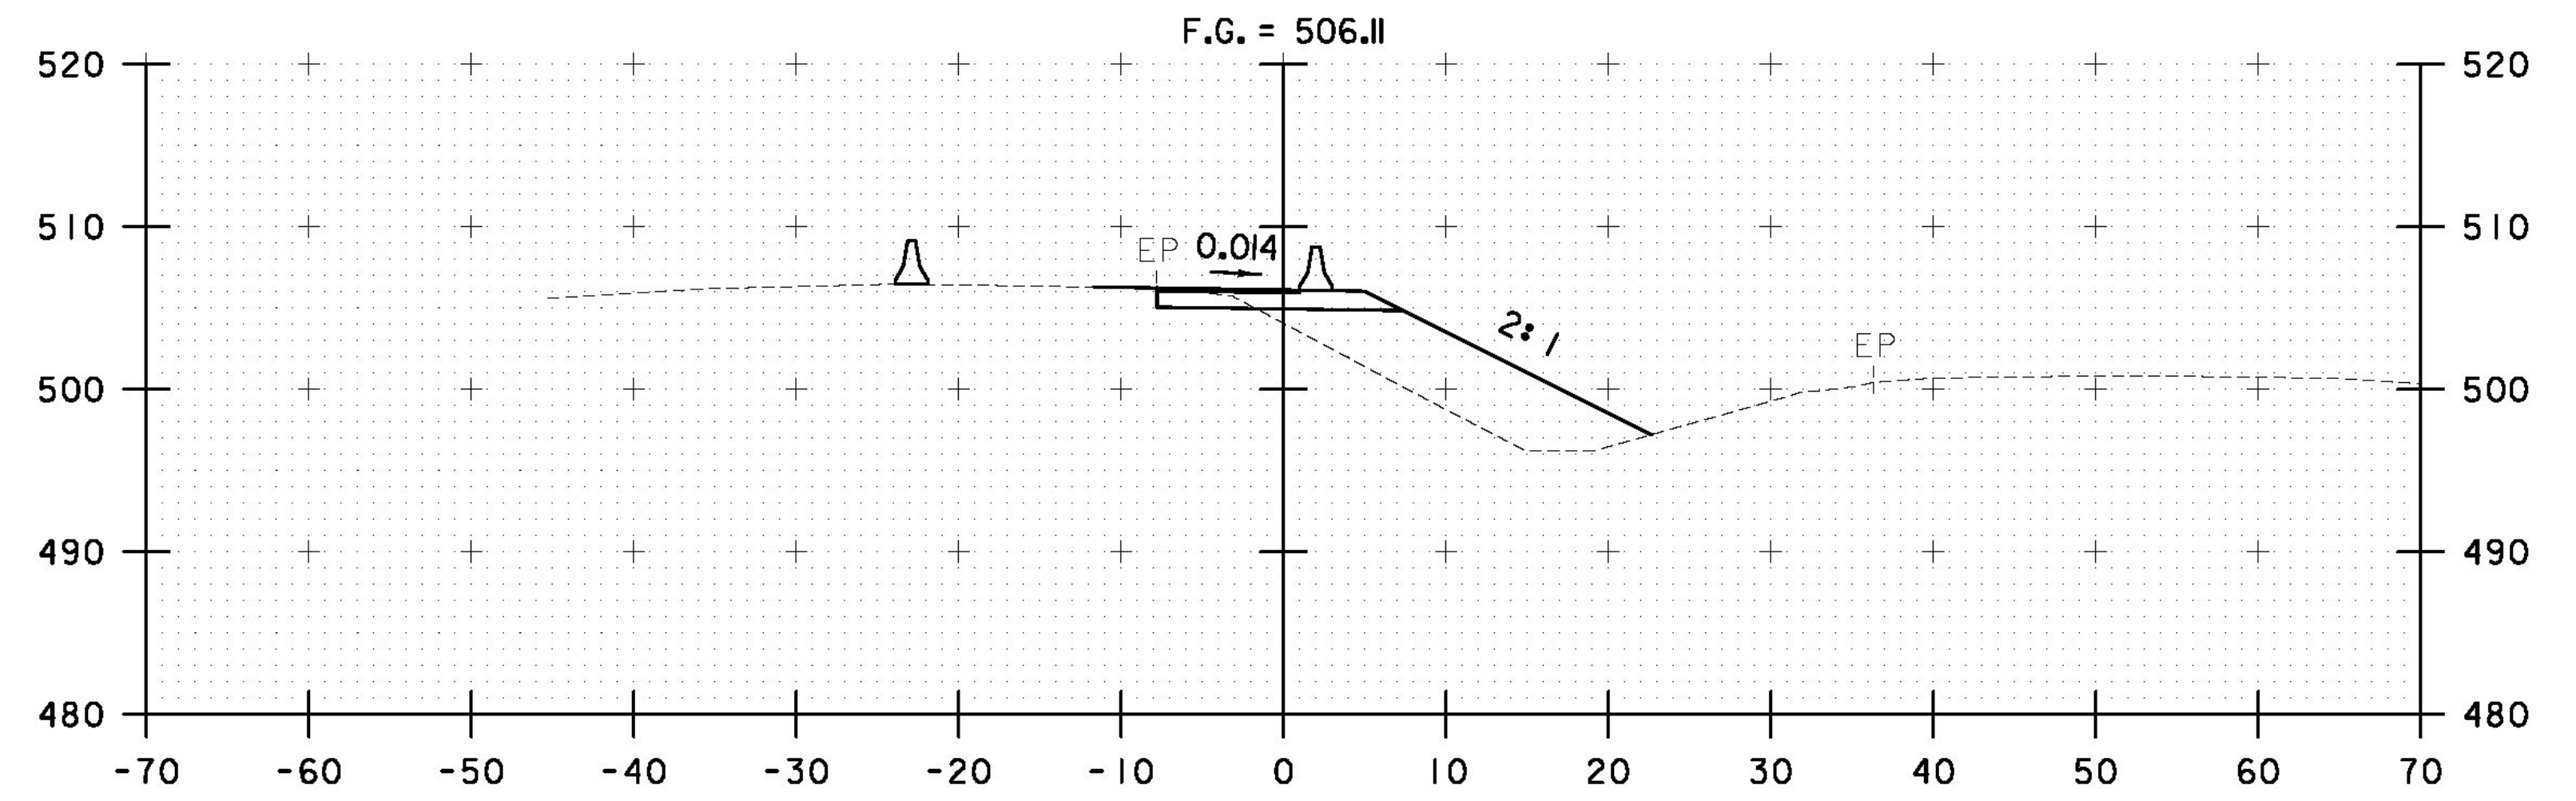


3008+00

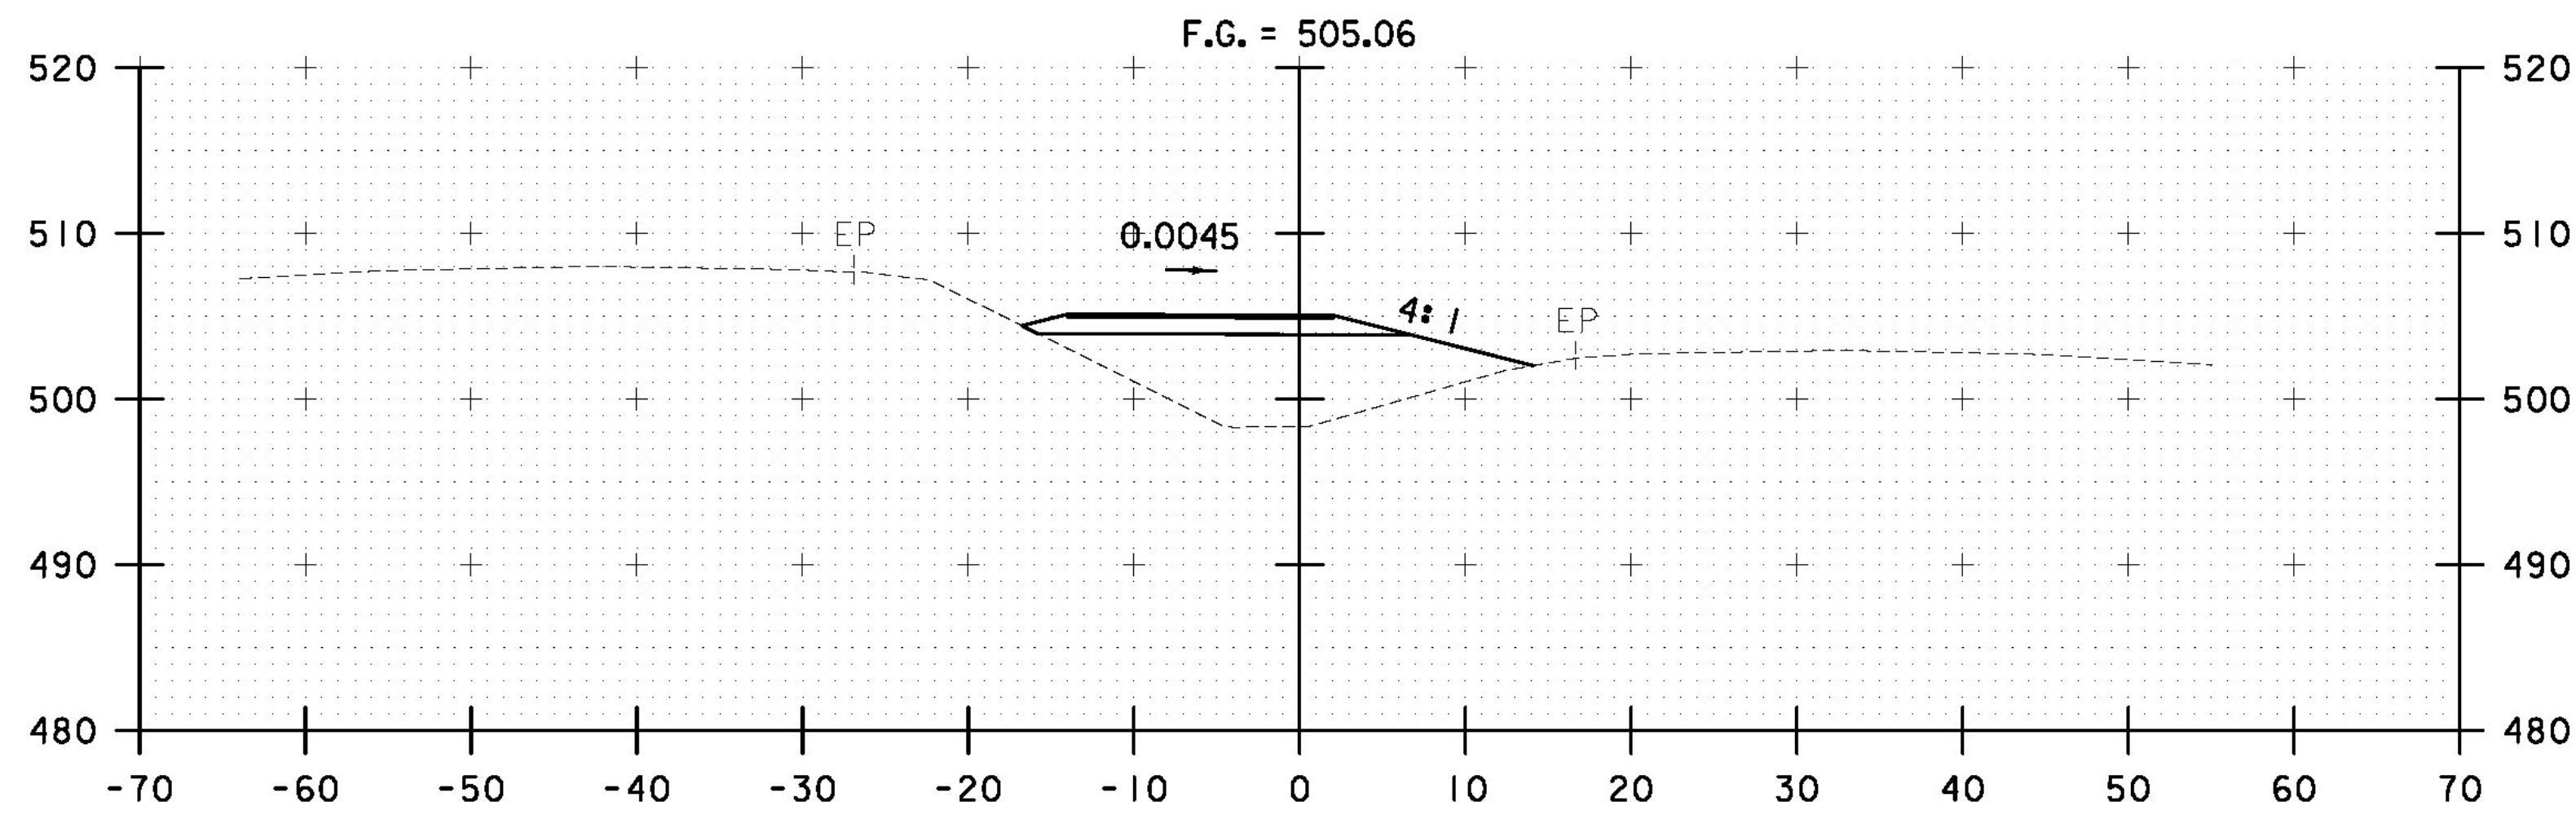

3006+00

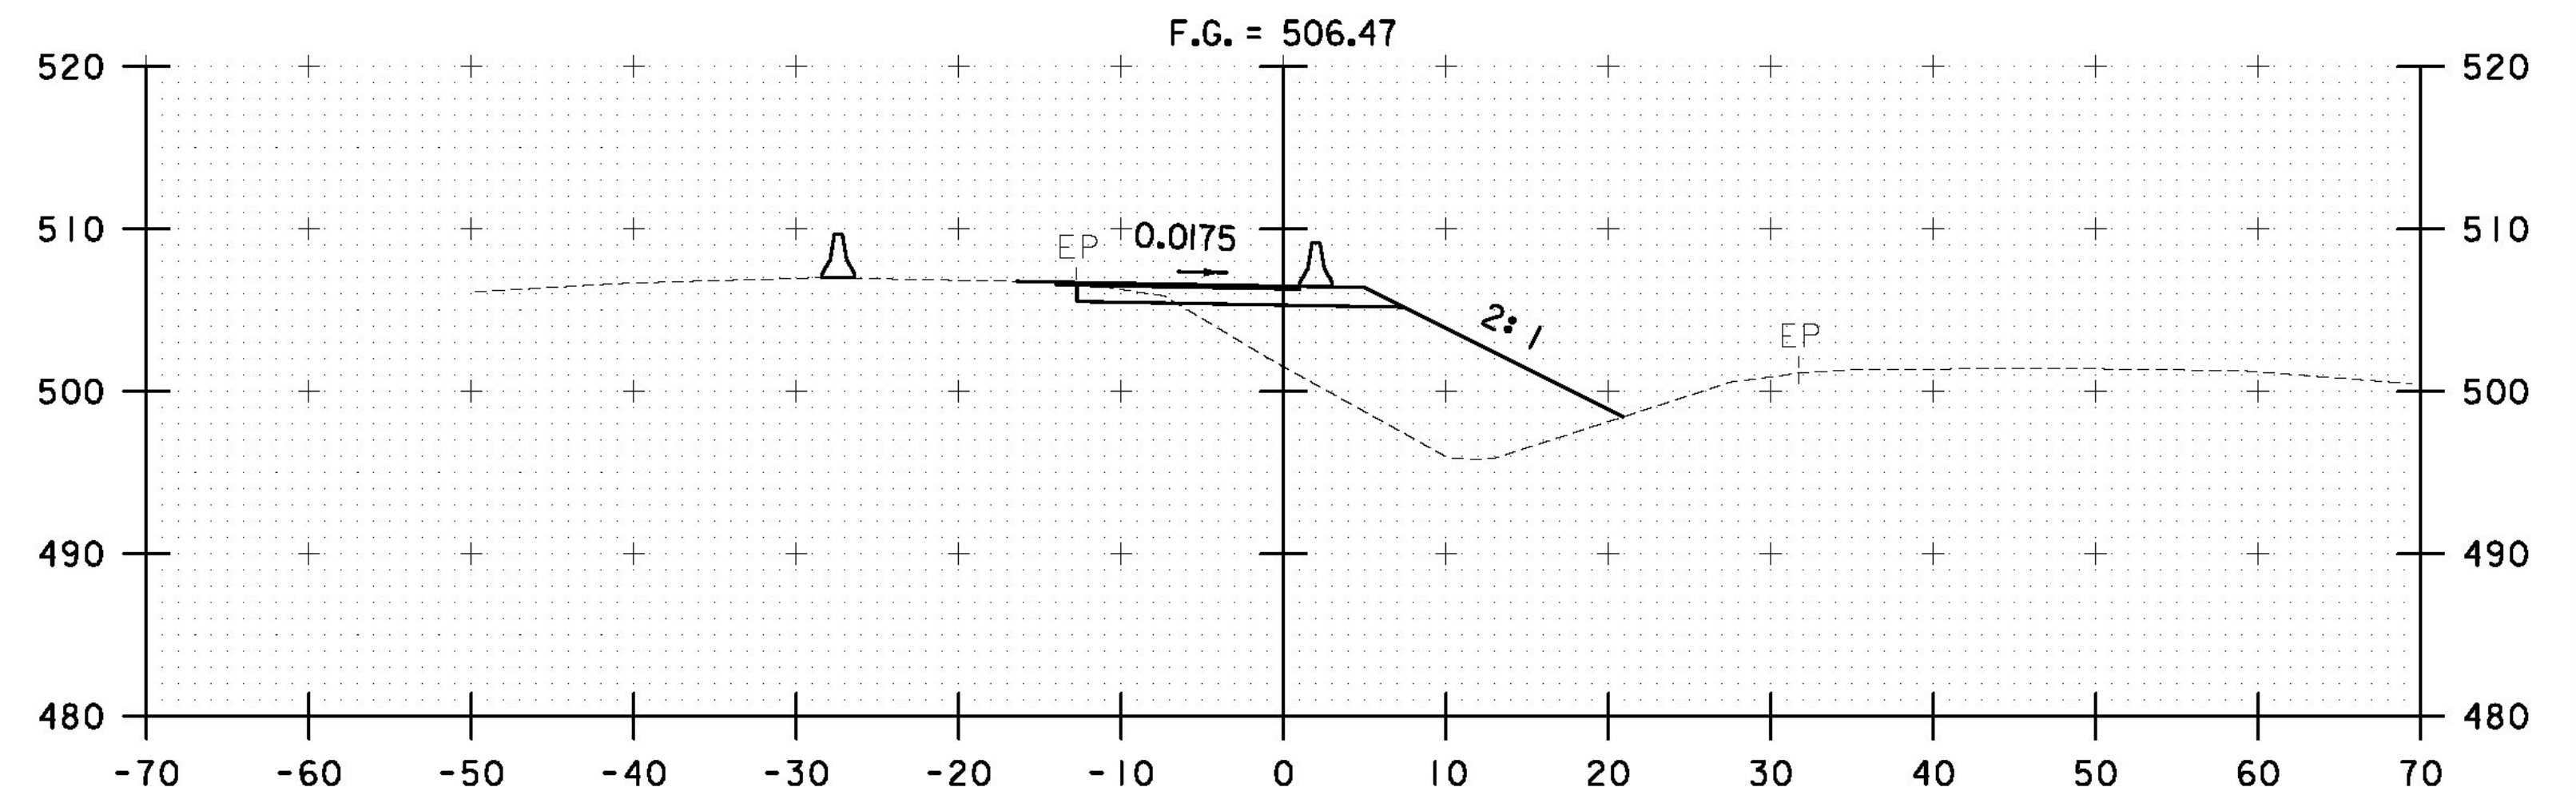

3007+50

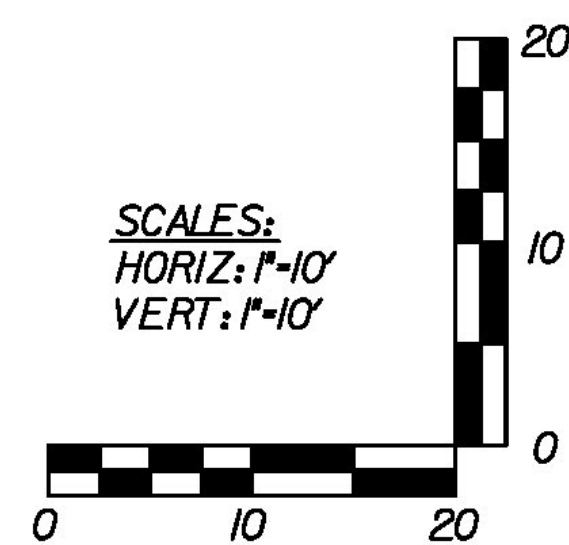

**AS BUILT
RECORD PLANS**

**RFC - WORK PACKAGE #2A
MARCH 21, 2011**

BECK & BELLUCCI, INC.

SOUTH END
STA. 3006+00 TO STA. 3008+50

PROJECT NAME: BRATTLEBORO

PROJECT NUMBER: 1M 091-(150)

FILE NAME: HW-100-NC0-900.dgn

PROJECT LEADER: Brian W. Clogston P.E.

DESIGNED BY: Phillip E. Kendall P.E.

NORTHBOUND CROSSOVER CROSS SECTIONS

PLOT DATE: 3/18/2011

DRAWN BY: J. R. Howe P.E.

CHECKED BY: D. BRYANT P.E.

SHEET HW-100-NC0-903