



3009+43

F.G. = 505.32

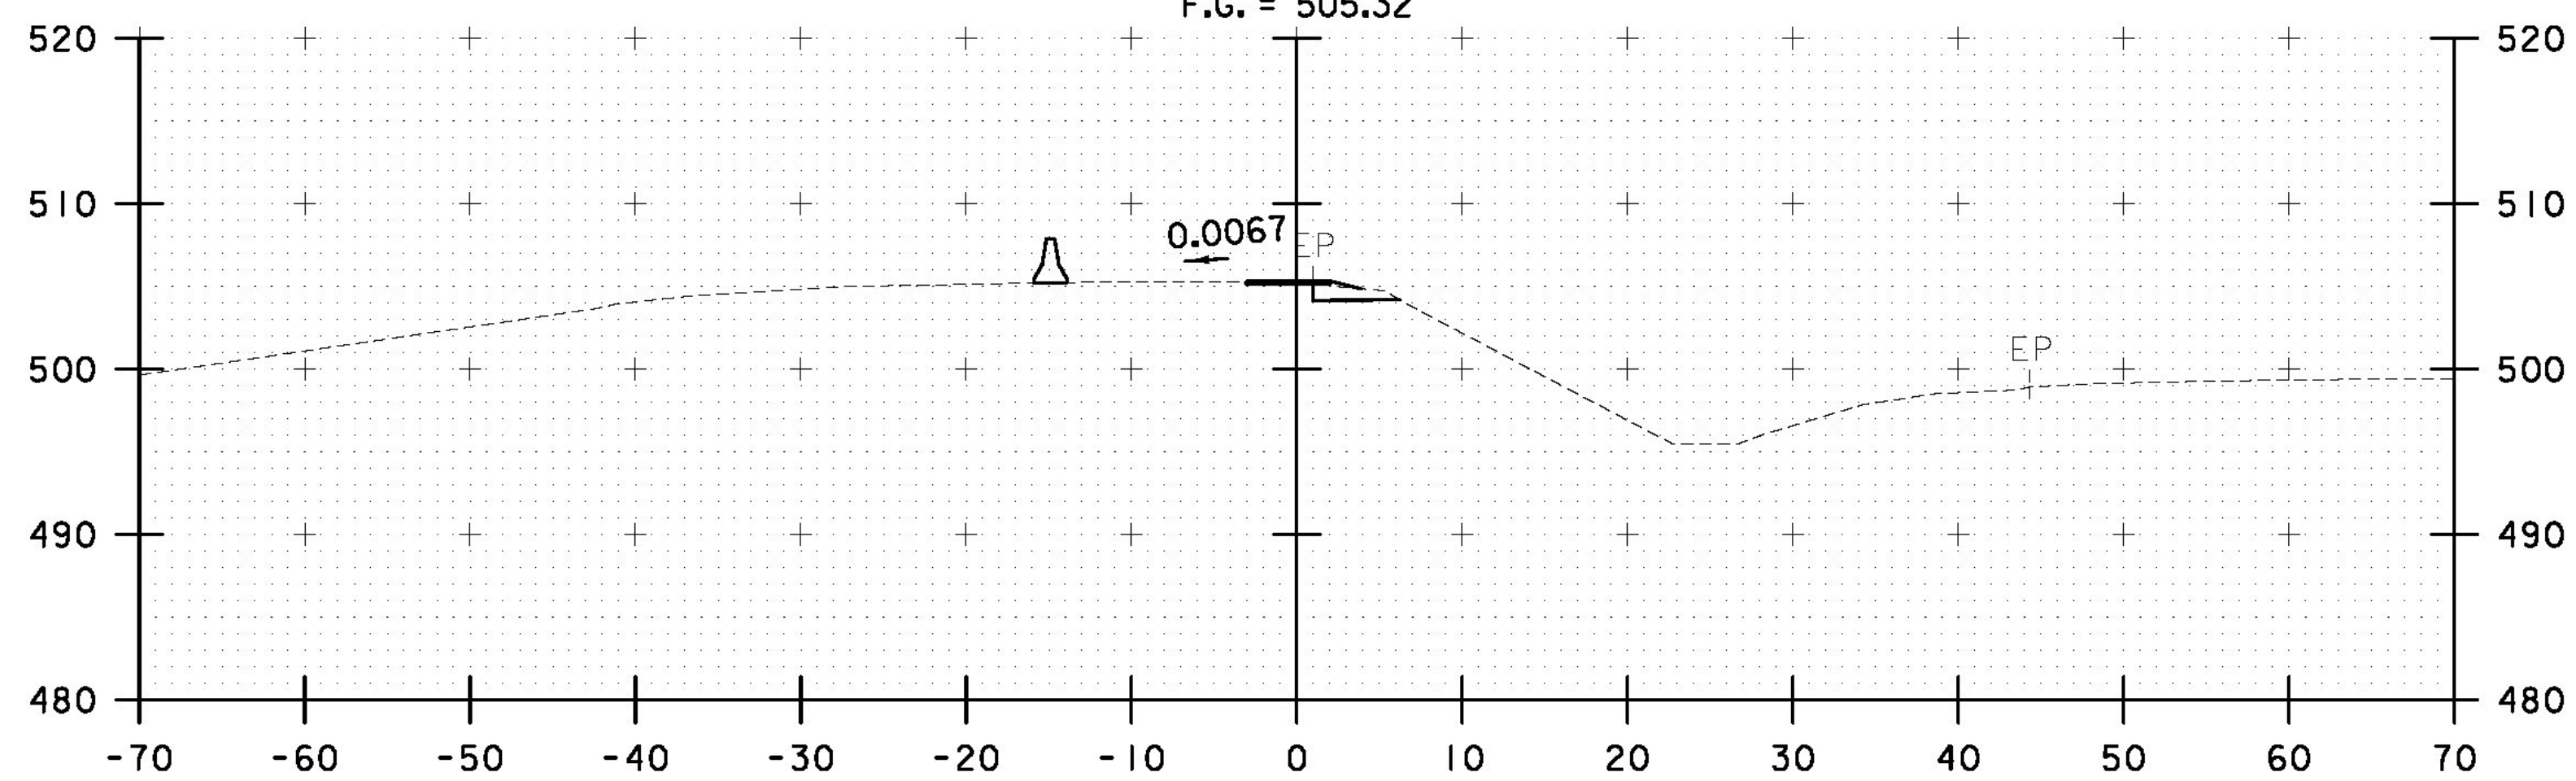

3009+00

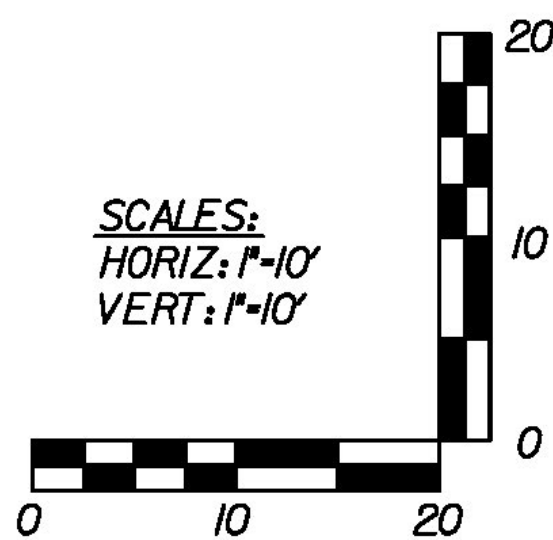

SCALES:
HORIZ: 1"=10'
VERT: 1"=10'

**AS BUILT
RECORD PLANS**

**RFC - WORK PACKAGE #2A
MARCH 21, 2011**

BECK & BELLUCCI, INC.

SOUTH END
STA. 3009+00 TO STA. 3009+43

PROJECT NAME: BRATTLEBORO

PROJECT NUMBER: IM 091-(150)

FILE NAME: HW-100-NC0-900.dgn

PLOT DATE: 3/18/2011

PROJECT LEADER: Brian W. Clogston P.E.

DRAWN BY: J. R. Howe P.E.

DESIGNED BY: Phillip E. Kendall P.E.

CHECKED BY: D. BRYANT P.E.

NORTHBOUND CROSSOVER CROSS SECTIONS

SHEET HW-100-NC0-904