




4001+00

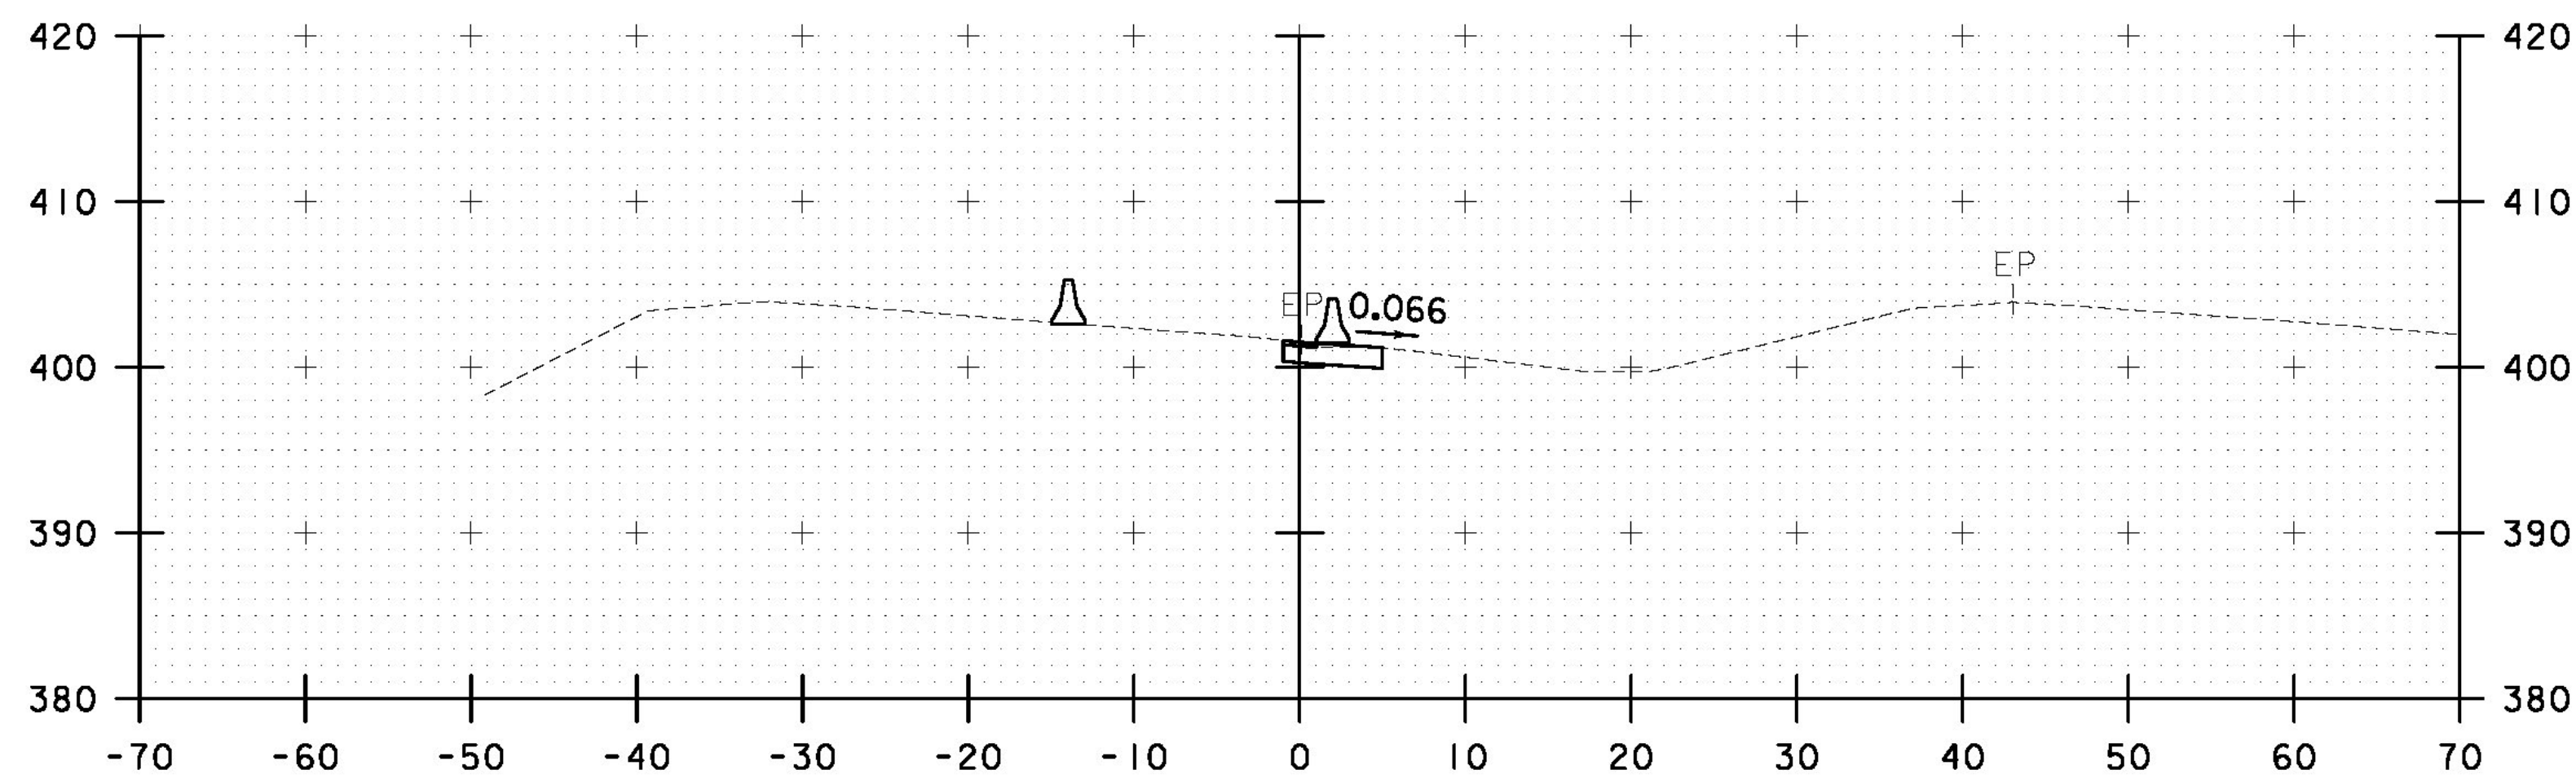


4000+50

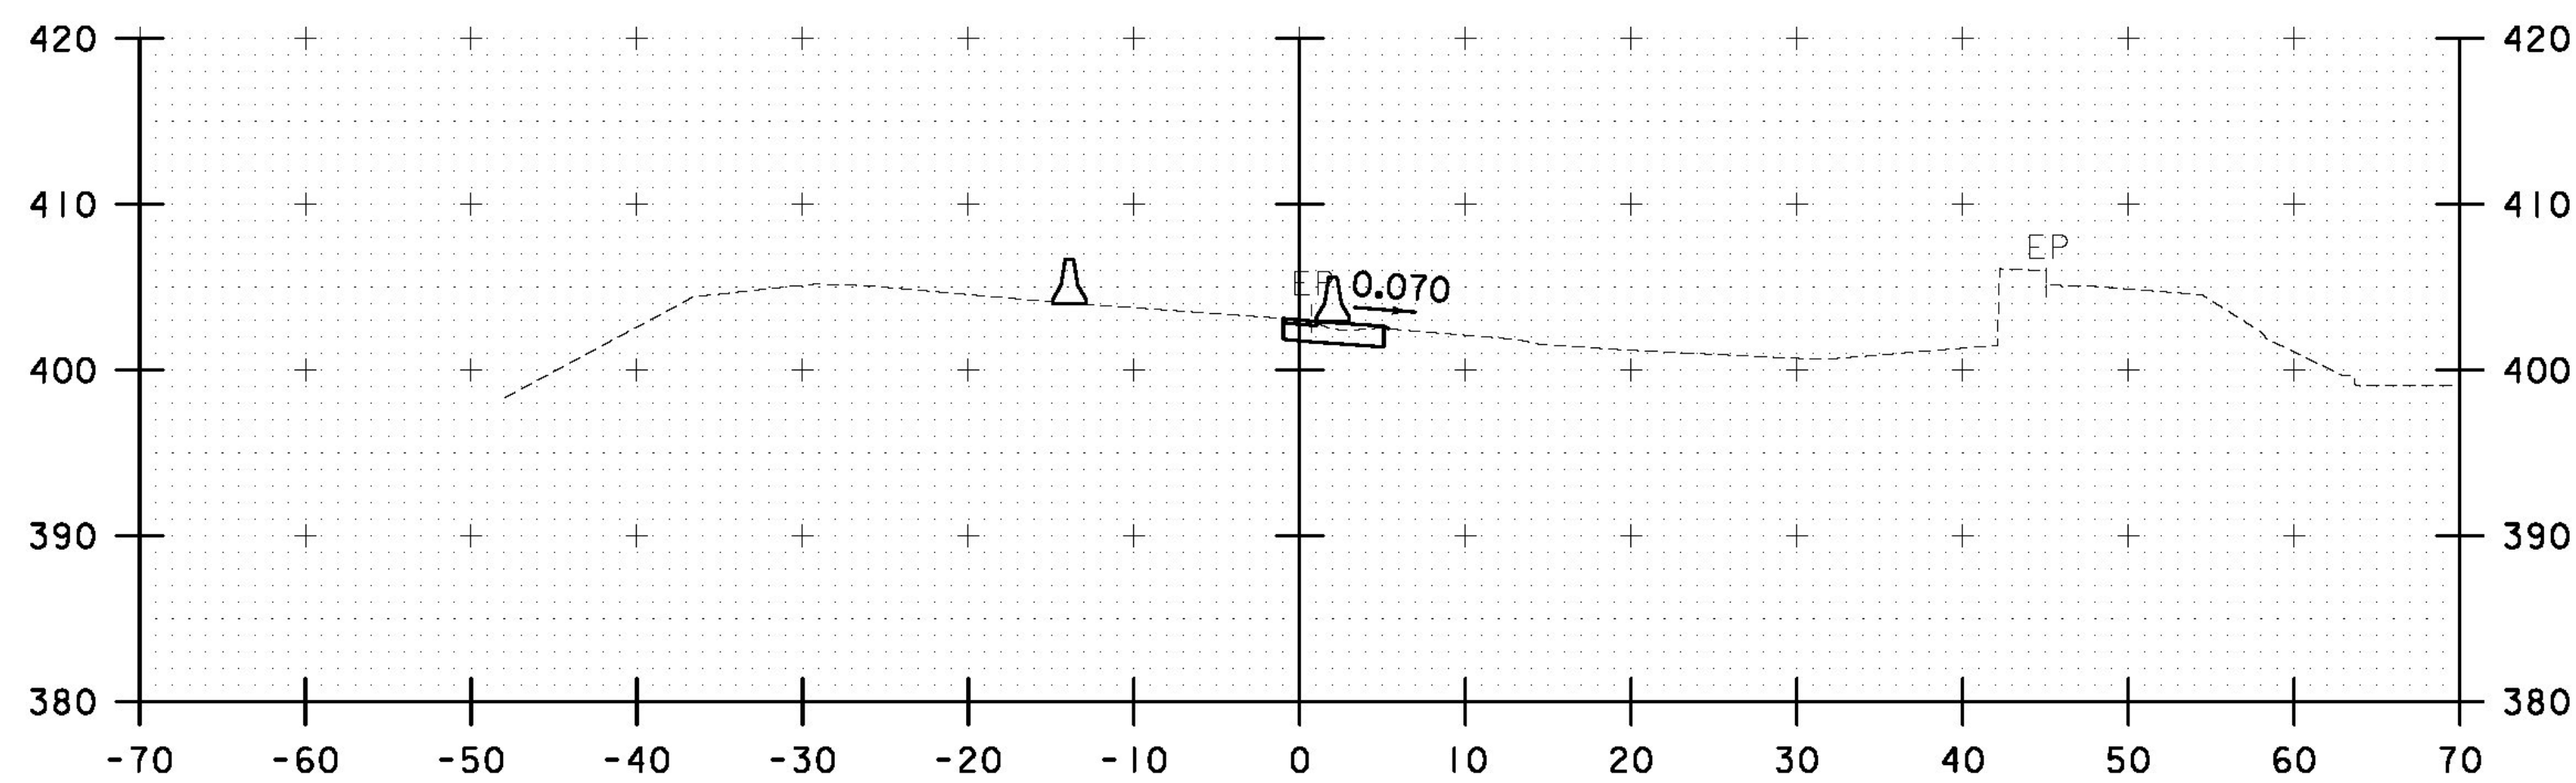


4000+00

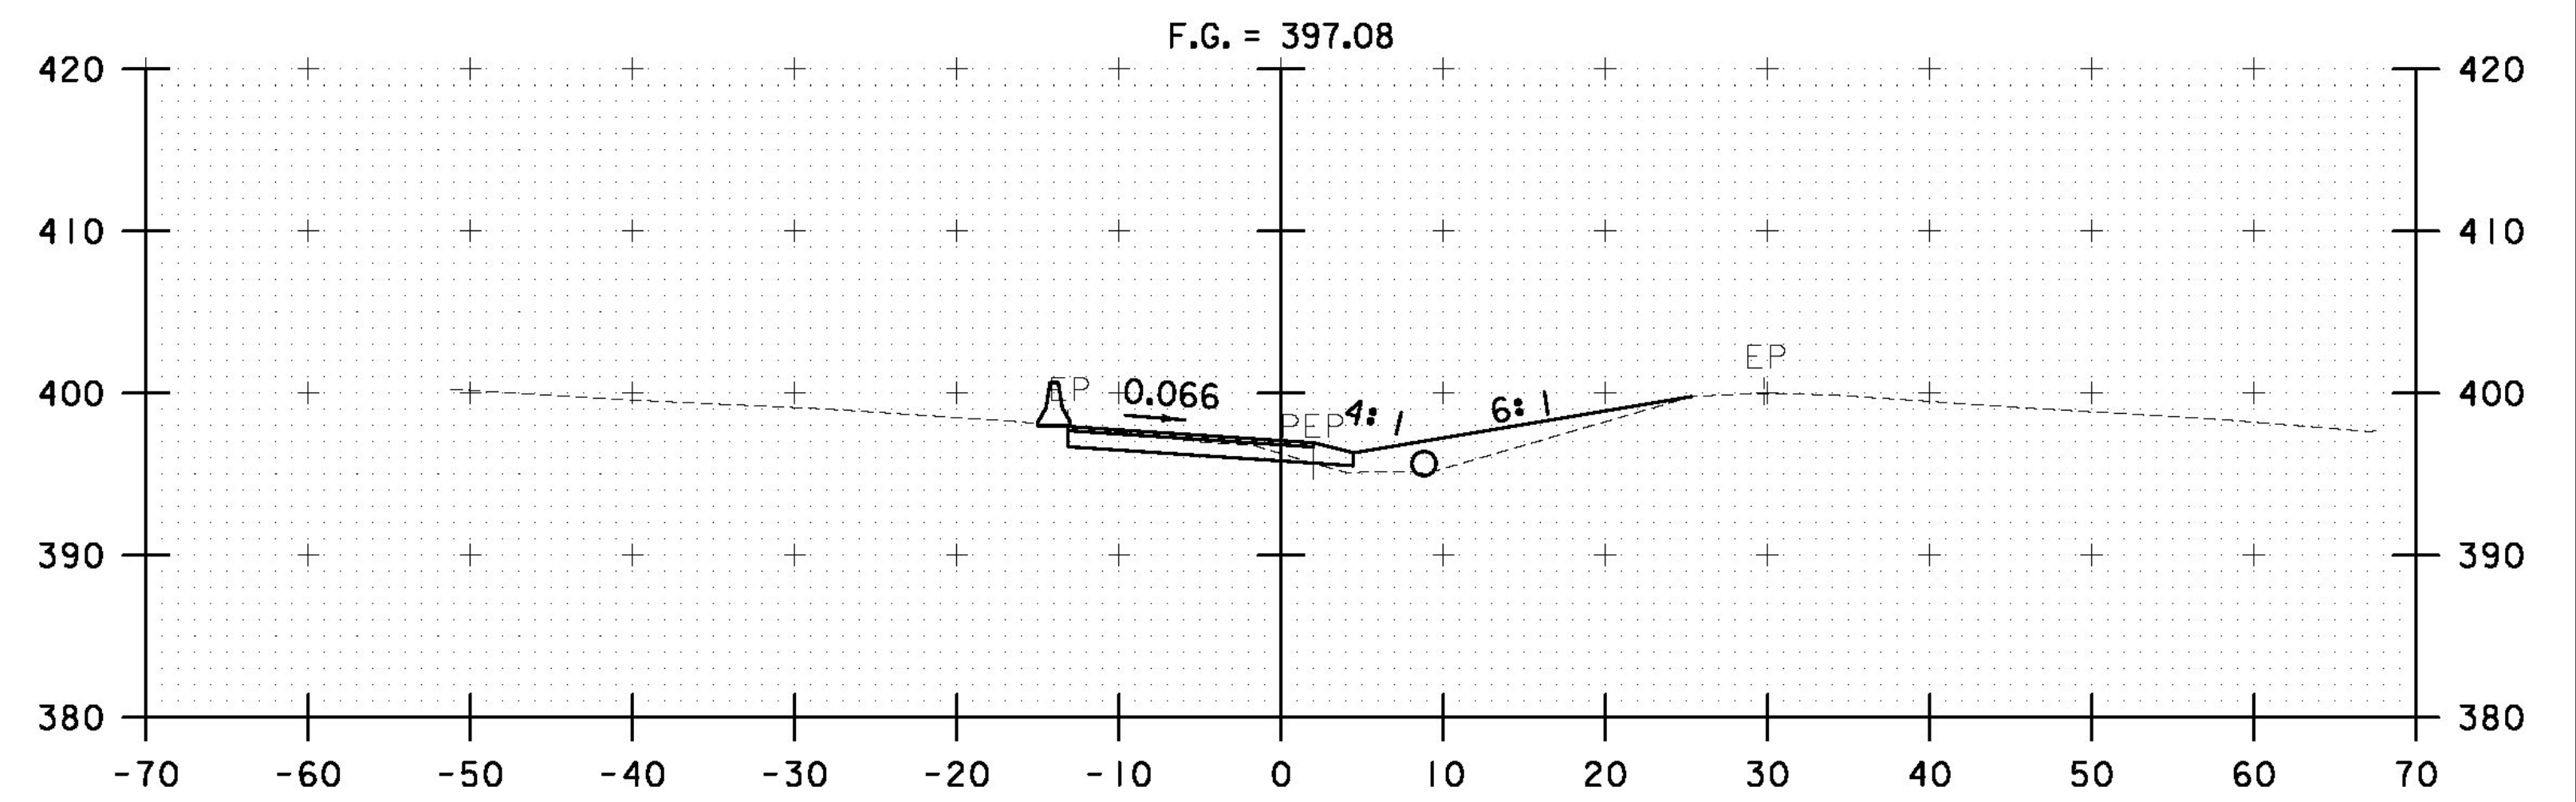


4002+50

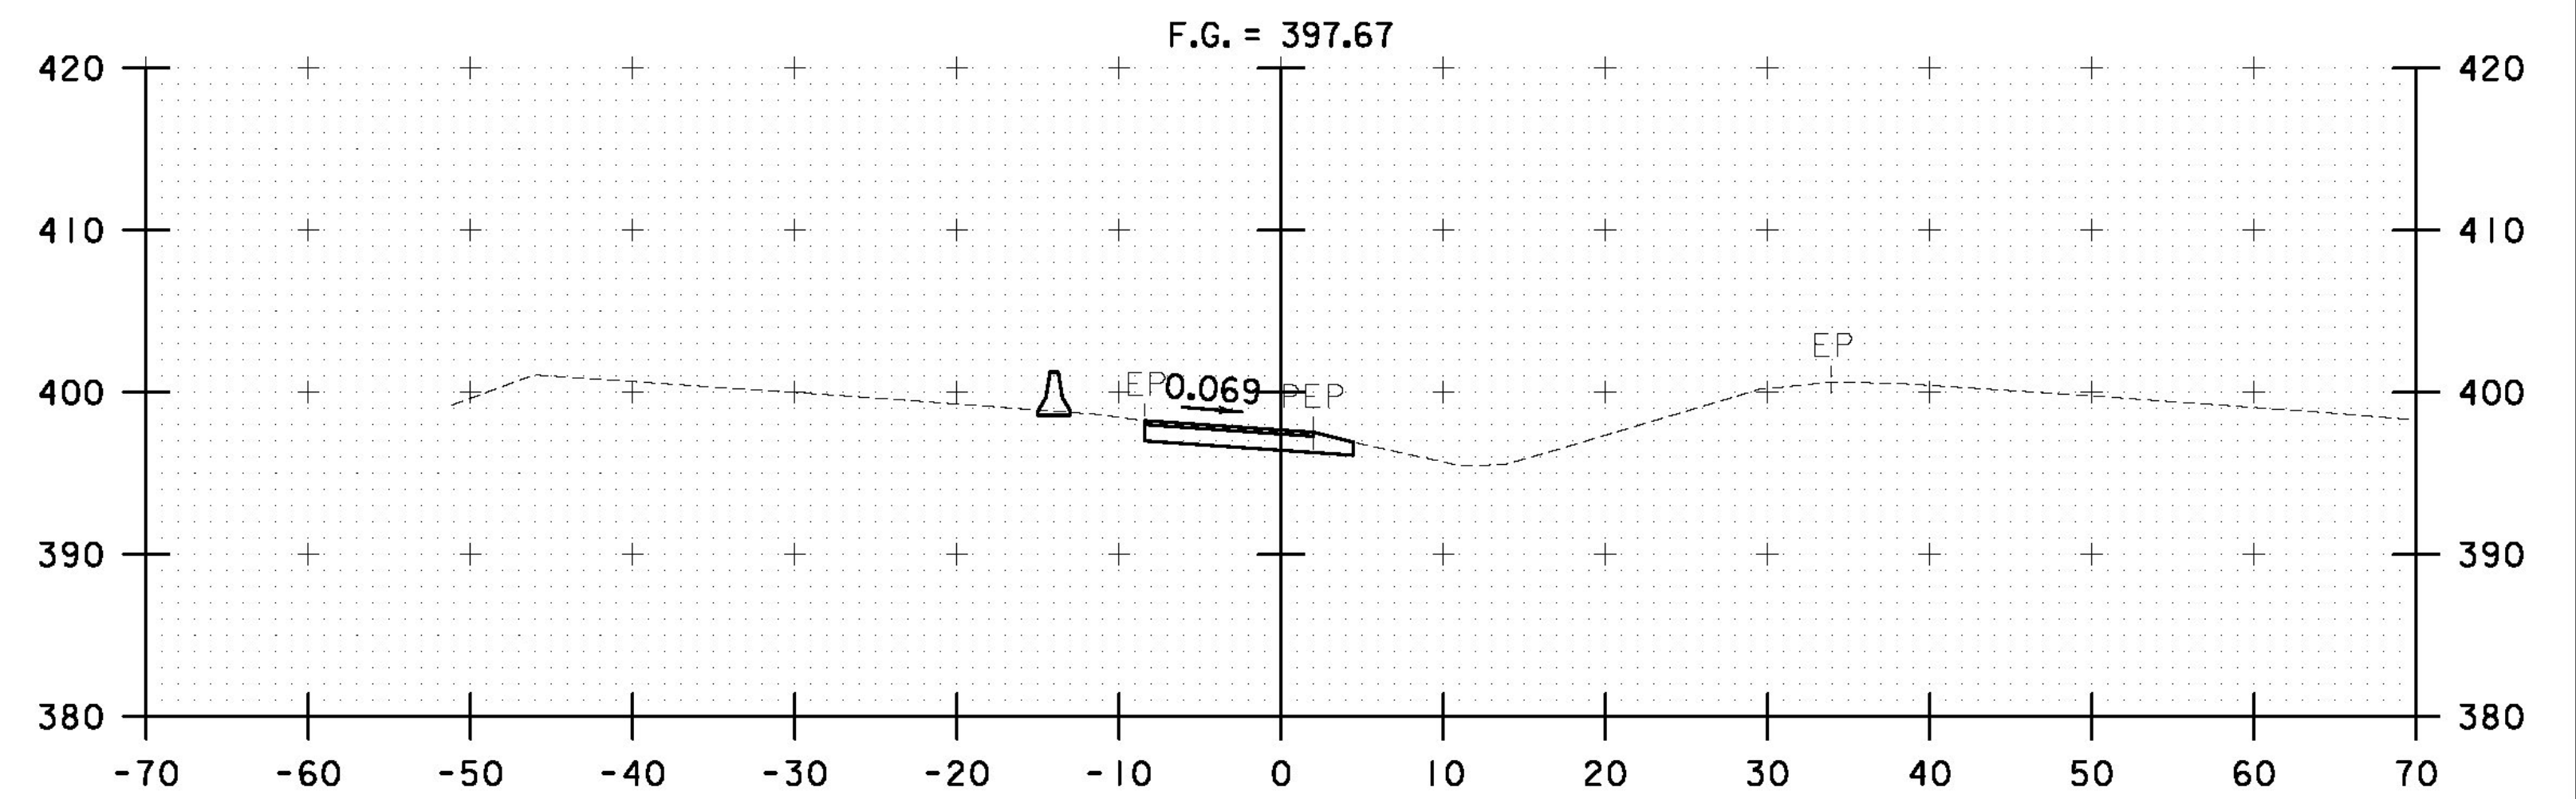

4002+00

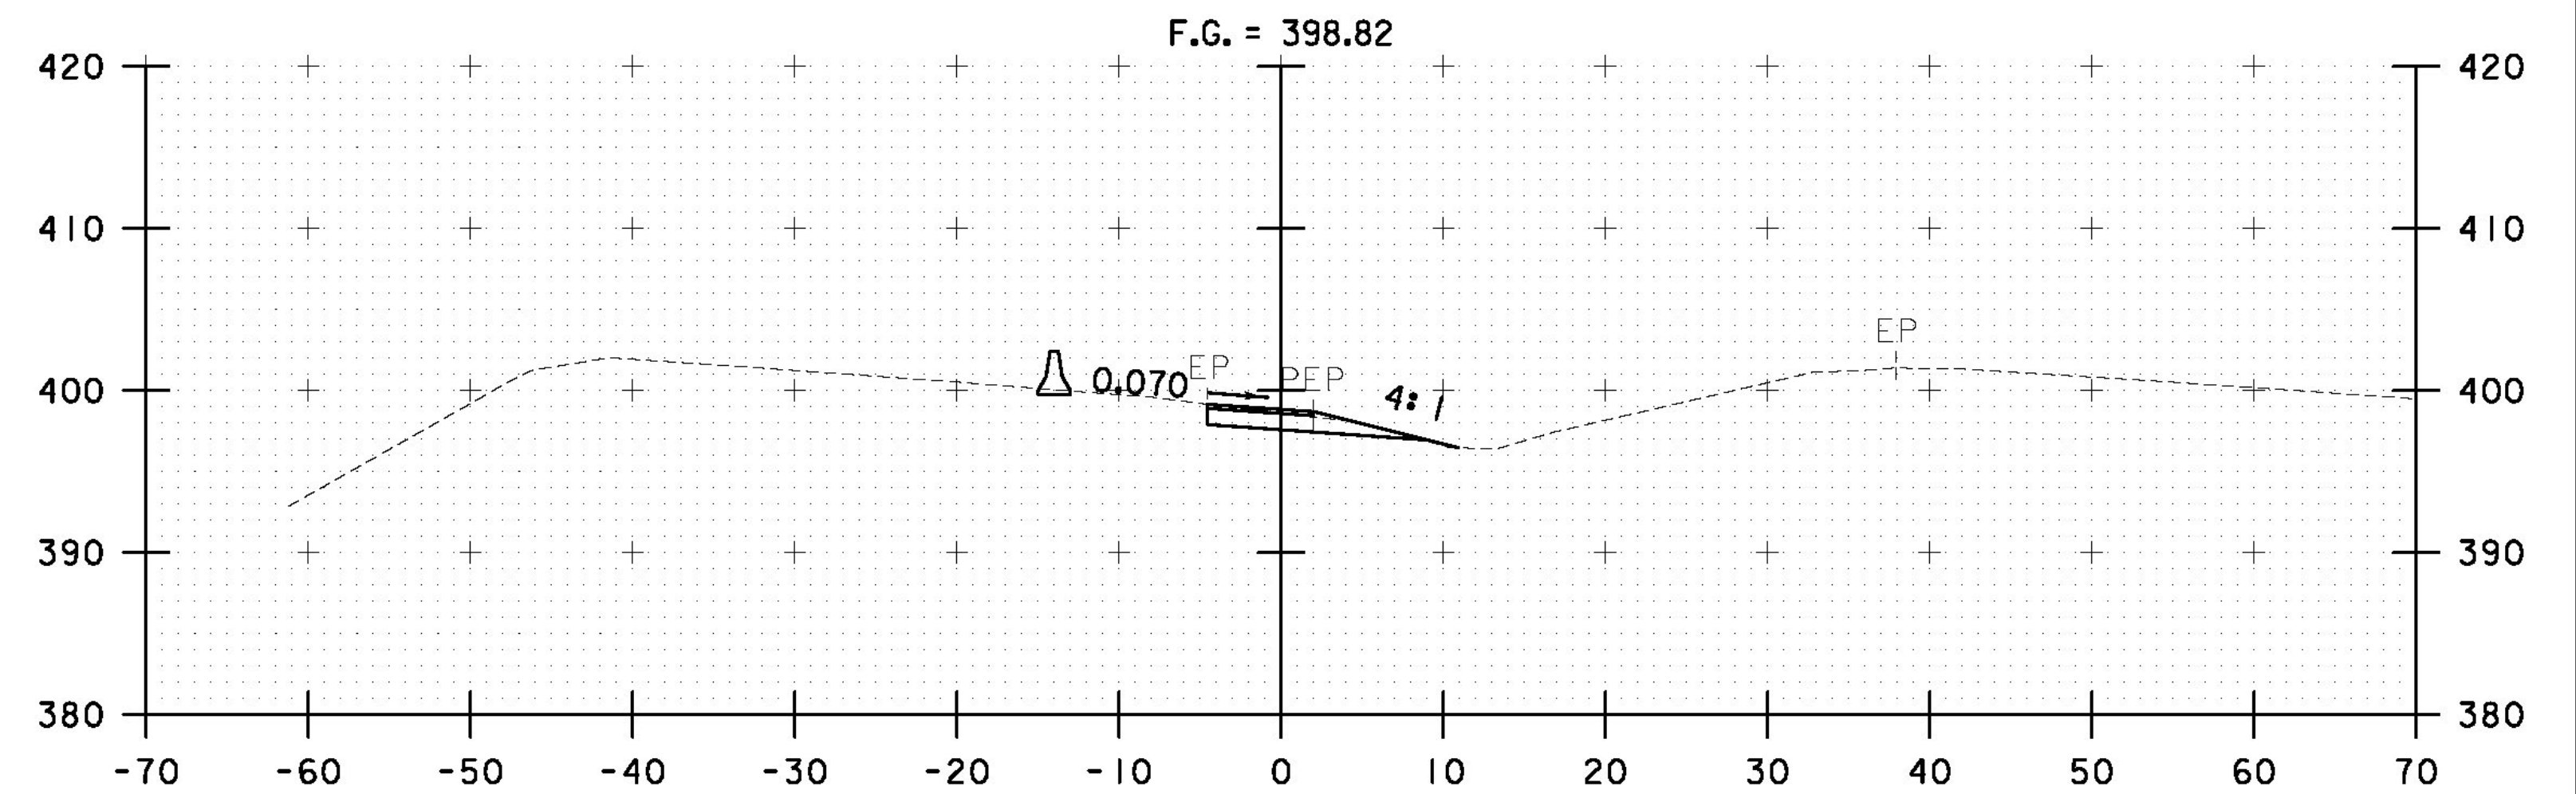

4001+50

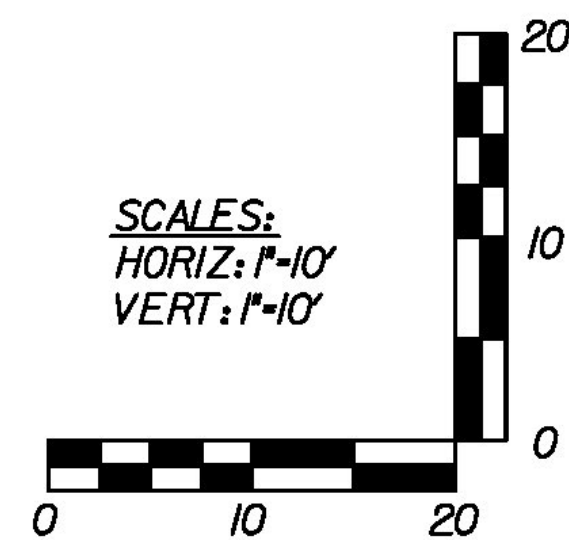

**AS BUILT  
RECORD PLANS**

**RFC - WORK PACKAGE #2A  
MARCH 21, 2011**

**BECK & BELLUCCI, INC.**

NORTH END  
STA. 4000+00 TO STA. 4002+50

PROJECT NAME: BRATTLEBORO

PROJECT NUMBER: 1M 091-(150)

FILE NAME: HW-100-NC0-900.dgn

PLOT DATE: 3/18/2011

PROJECT LEADER: Brian W. Clogston P.E.

DRAWN BY: J. R. Howe P.E.

DESIGNED BY: Phillip E. Kendall P.E.

CHECKED BY: D. BRYANT P.E.

NORTHBOUND CROSSOVER CROSS SECTIONS

SHEET HW-100-NC0-905