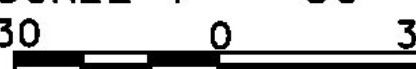


**AS BUILT
RECORD PLANS**

SCALE 1" = 30'-0"


RFC PLANS - WORK PACKAGE #10
 SOUTHBOUND APPROACH
 MARCH 1, 2012

BECK & BELLUCCI, INC. **TYLIN INTERNATIONAL**

PROJECT NAME: BRATTLEBORO

PROJECT NUMBER: IM 091-(150)

FILE NAME: HW-100-SC0-505.dgn
 PROJECT LEADER: Phillip E. Kendall P.E.
 DESIGNED BY: Phillip E. Kendall P.E.
 SOUTHBOUND CLOSURE TCP 5 of 7

PLOT DATE: 3/1/2012
 DRAWN BY: J. R. Howe P.E.
 CHECKED BY: D. Bryant P.E.
 SHEET HW-100-SC0-505

NOTE:
 SEE SHEET HW-100-SC0-501 FOR LEGEND.