


- NOTES:
- EXISTING DETAIL LINE WORK IN THIS WINDOW IS GRAPHICAL ONLY AND IS SHOWN TO PROVIDE PERSPECTIVE FOR SIGN PLACEMENT.
  - SEE SHEET HW-100-SCO-501 FOR LEGEND.
  - PLACE PORTABLE CHANGEABLE MESSAGE SIGN AT MILE MARKER 11.00 TO INFORM OF UPCOMING TRAFFIC PATTERN CHANGE.

**AS BUILT  
RECORD PLANS**

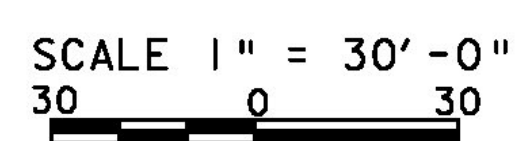

RFC PLANS - WORK PACKAGE #10  
SOUTHBOUND APPROACH  
MARCH 1, 2012

BECK & BELLUCCI, INC. TYLIN INTERNATIONAL

PROJECT NAME: BRATTLEBORO  
PROJECT NUMBER: IM 091-(K50)

FILE NAME: HW-100-SCO-507.dgn  
PROJECT LEADER: Phillip E. Kendall P.E.  
DESIGNED BY: Phillip E. Kendall P.E.  
SOUTHBOUND CLOSURE TCP 7 OF 7

PLOT DATE: 3/1/2012  
DRAWN BY: J. R. Howe P.E.  
CHECKED BY: D. Bryant P.E.  
SHEET HW-100-SCO-507