


SOUTHBOUND CROSSOVER

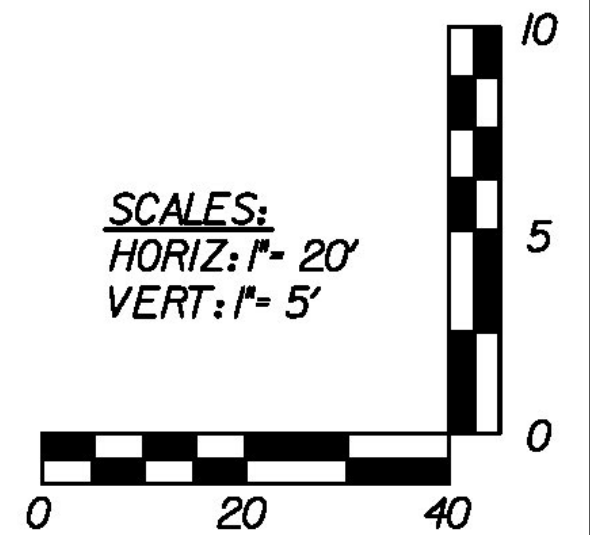

**AS BUILT
 RECORD PLANS**

RFC PLANS - WORK PACKAGE #10
 SOUTHBOUND APPROACH
 MARCH 1, 2012

BECK & BELLUCCI, INC.

TYLIN INTERNATIONAL

PROJECT NAME: <u>BRATTLEBORO</u>	FILE NAME: <u>HW-100-SC0-602.dgn</u>	PLOT DATE: <u>3/1/2012</u>
PROJECT NUMBER: <u>1M_091-1(50)</u>	PROJECT LEADER: <u>Phillip E. Kendall P.E.</u>	DRAWN BY: <u>J. R. Howe P.E.</u>
	DESIGNED BY: <u>Phillip E. Kendall P.E.</u>	CHECKED BY: <u>D. Bryant P.E.</u>
	<u>SOUTHBOUND CROSSOVER PROFILE 2_0E_4</u>	SHEET <u>HW-100-SC0-602</u>