


SOUTHBOUND CROSSOVER

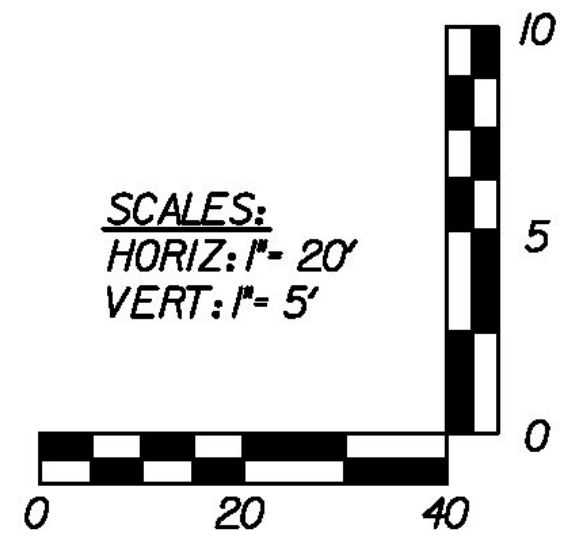

**AS BUILT  
 RECORD PLANS**

RFC PLANS - WORK PACKAGE #10  
 SOUTHBOUND APPROACH  
 MARCH 1, 2012

**BECK & BELLUCCI, INC.** **TYLIN INTERNATIONAL**

PROJECT NAME: BRATTLEBORO

PROJECT NUMBER: 1M\_091-(150)

FILE NAME: HW-100-SC0-603.dgn PLOT DATE: 3/1/2012

PROJECT LEADER: Phillip E. Kendall P.E. DRAWN BY: J.R. Howe P.E.

DESIGNED BY: Phillip E. Kendall P.E. CHECKED BY: D. Bryant P.E.

SOUTHBOUND CROSSOVER PROFILE 3 OF 4 SHEET HW-100-SC0-603