


SOUTHBOUND CROSSOVER

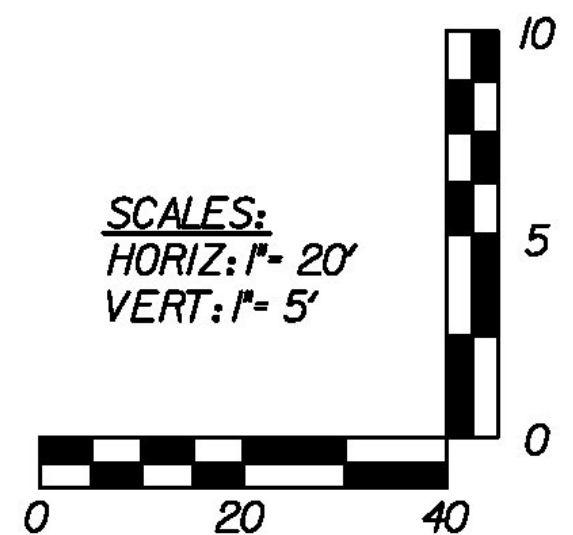

**AS BUILT  
RECORD PLANS**

RFC PLANS - WORK PACKAGE #10  
SOUTHBOUND APPROACH  
MARCH 1, 2012

BECK & BELLUCCI, INC.

TYLIN INTERNATIONAL

PROJECT NAME: BRATTLEBORO

PROJECT NUMBER: 1M\_091-(150)

FILE NAME: HW-100-SCQ-604.dgn

PLOT DATE: 3/1/2012

PROJECT LEADER: Phillip E. Kendall P.E.

DRAWN BY: J.R. Howe P.E.

DESIGNED BY: Phillip E. Kendall P.E.

CHECKED BY: D. Bryant P.E.

SOUTHBOUND CROSSOVER PROFILE 4 OF 4

SHEET HW-100-SCQ-604