




1001+00

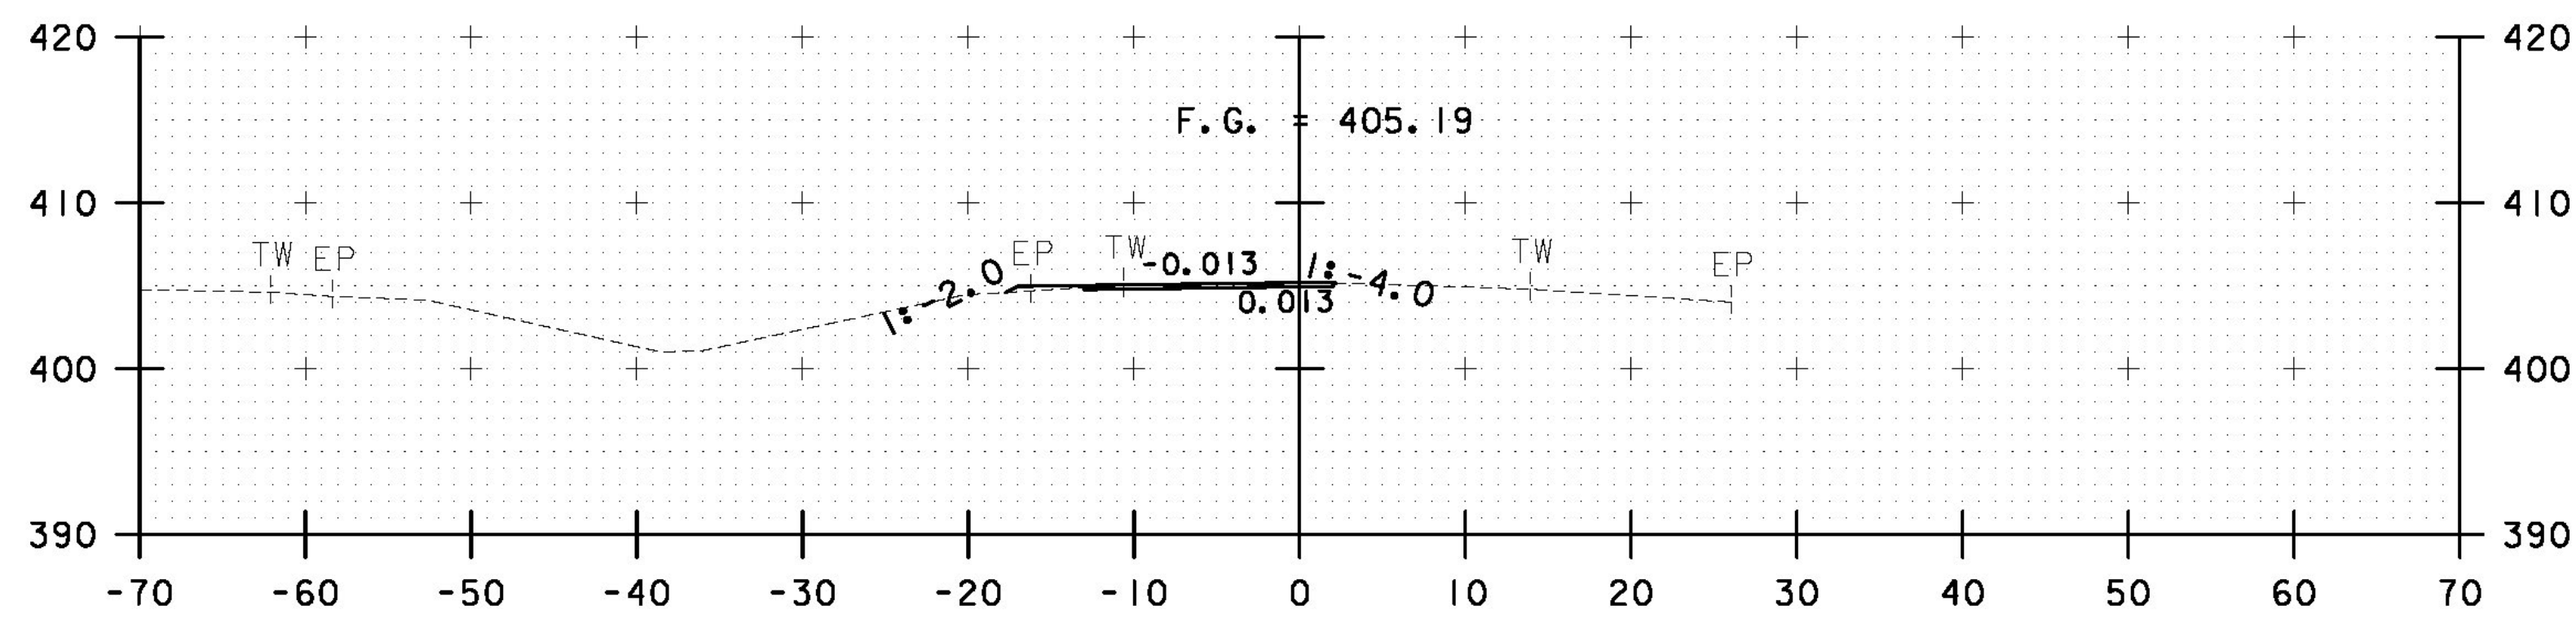


1000+50

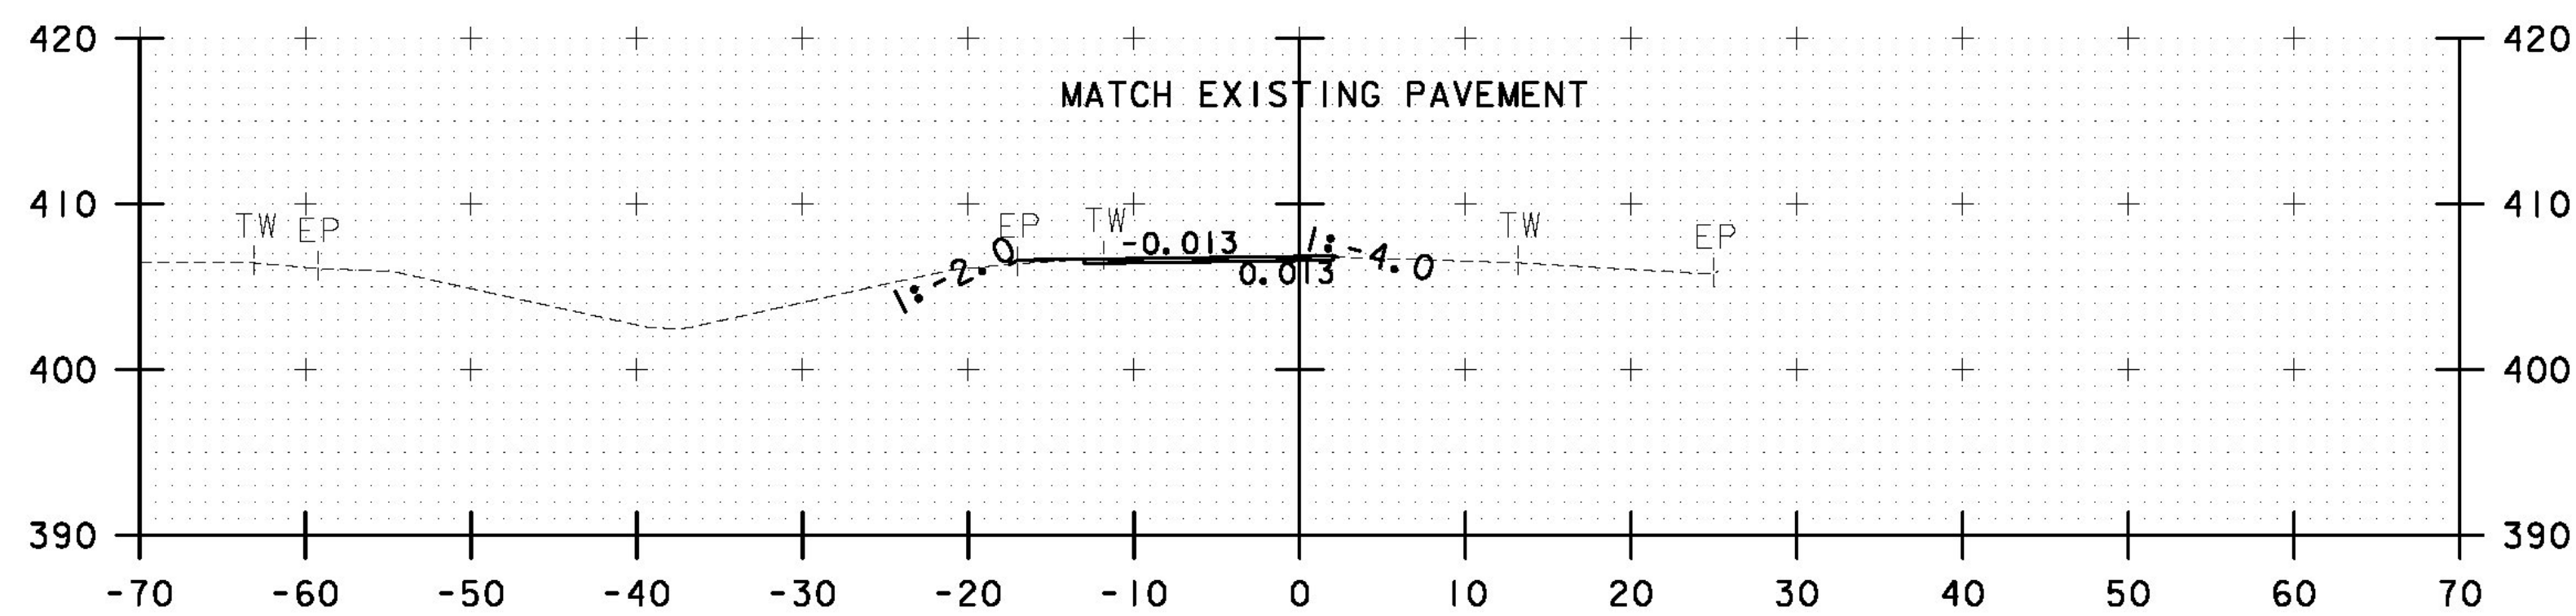


1000+00

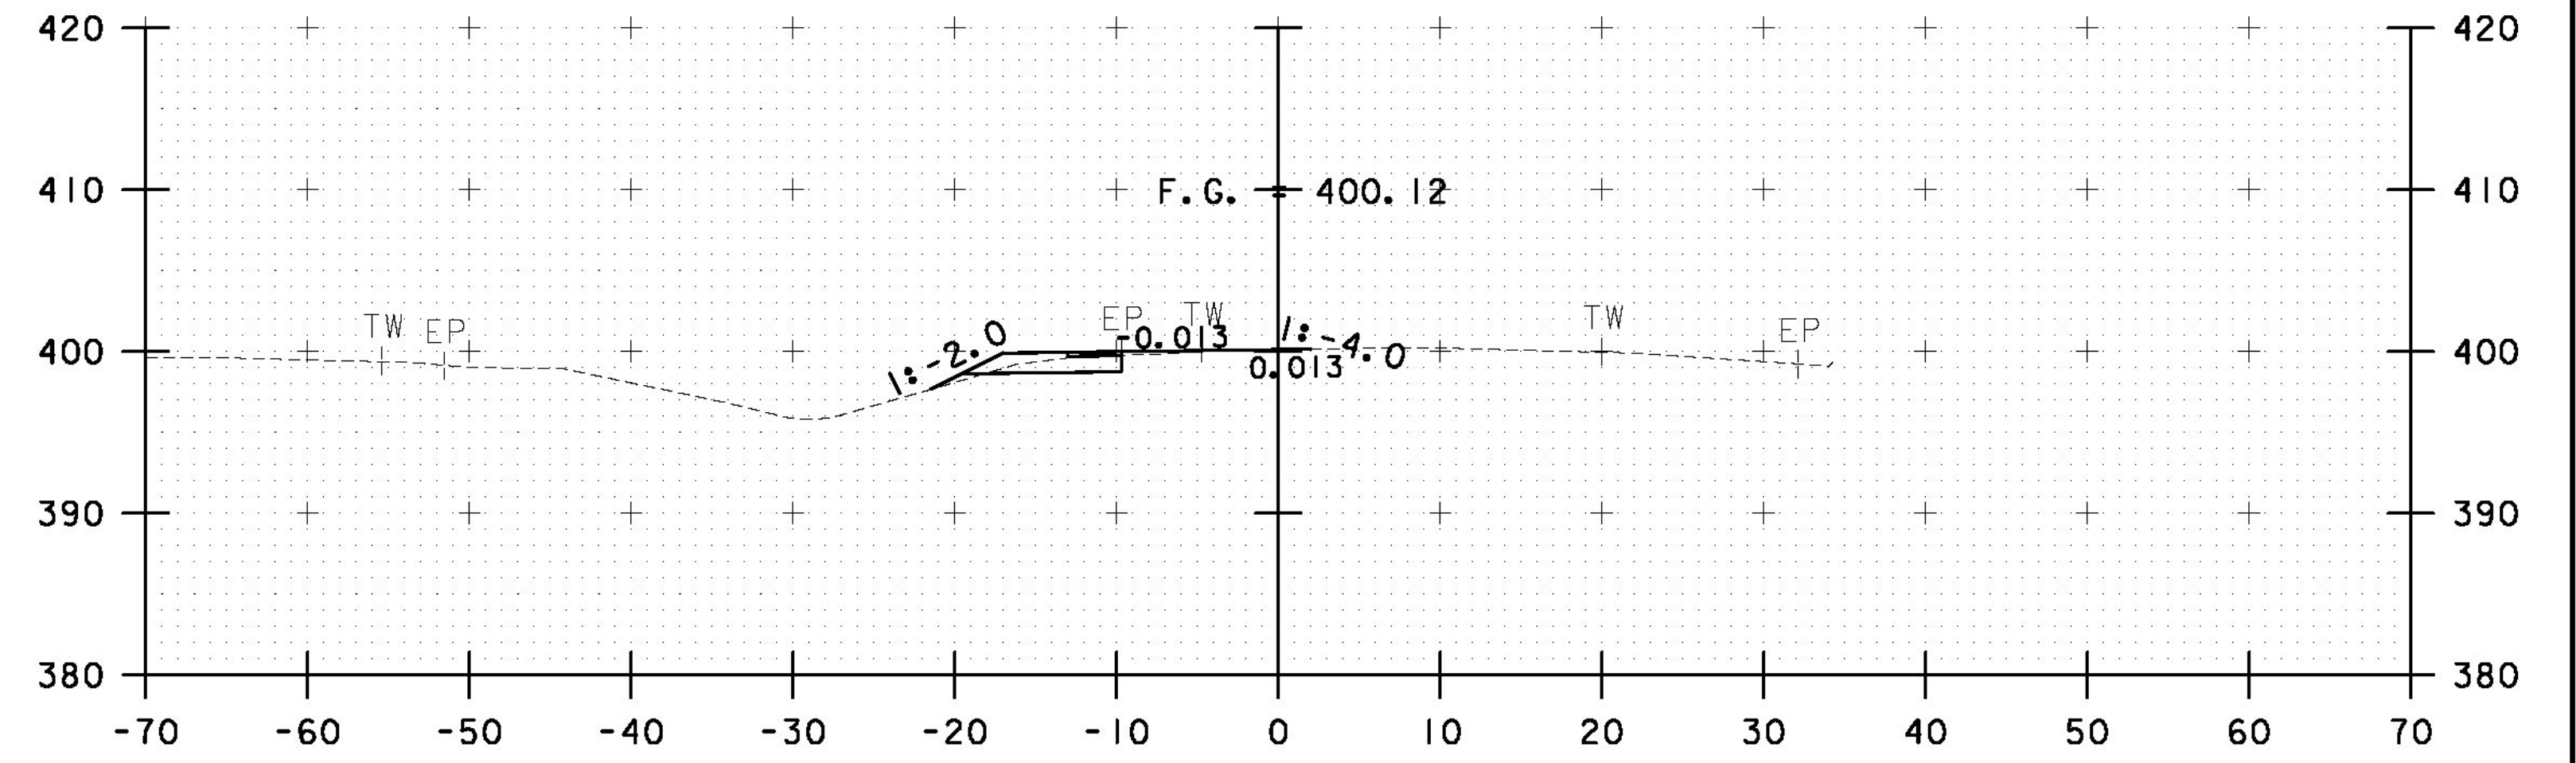


1002+50

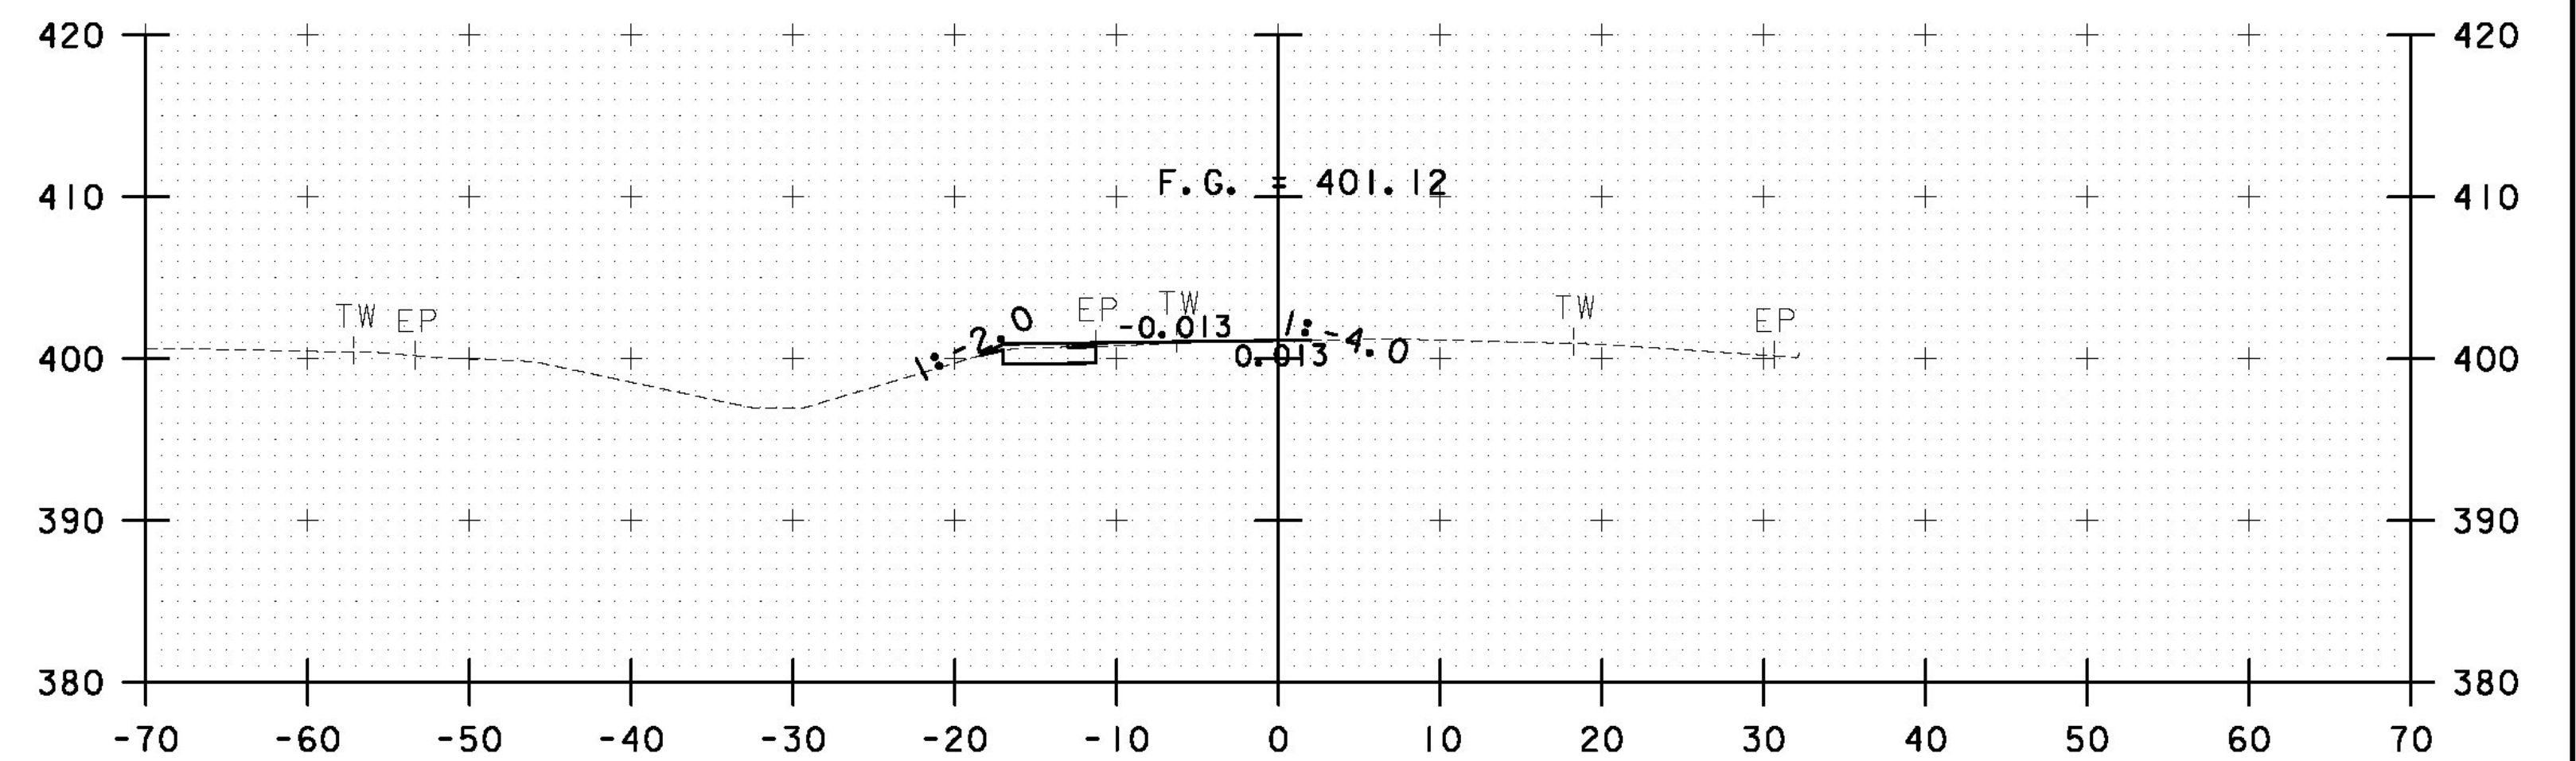

1002+00

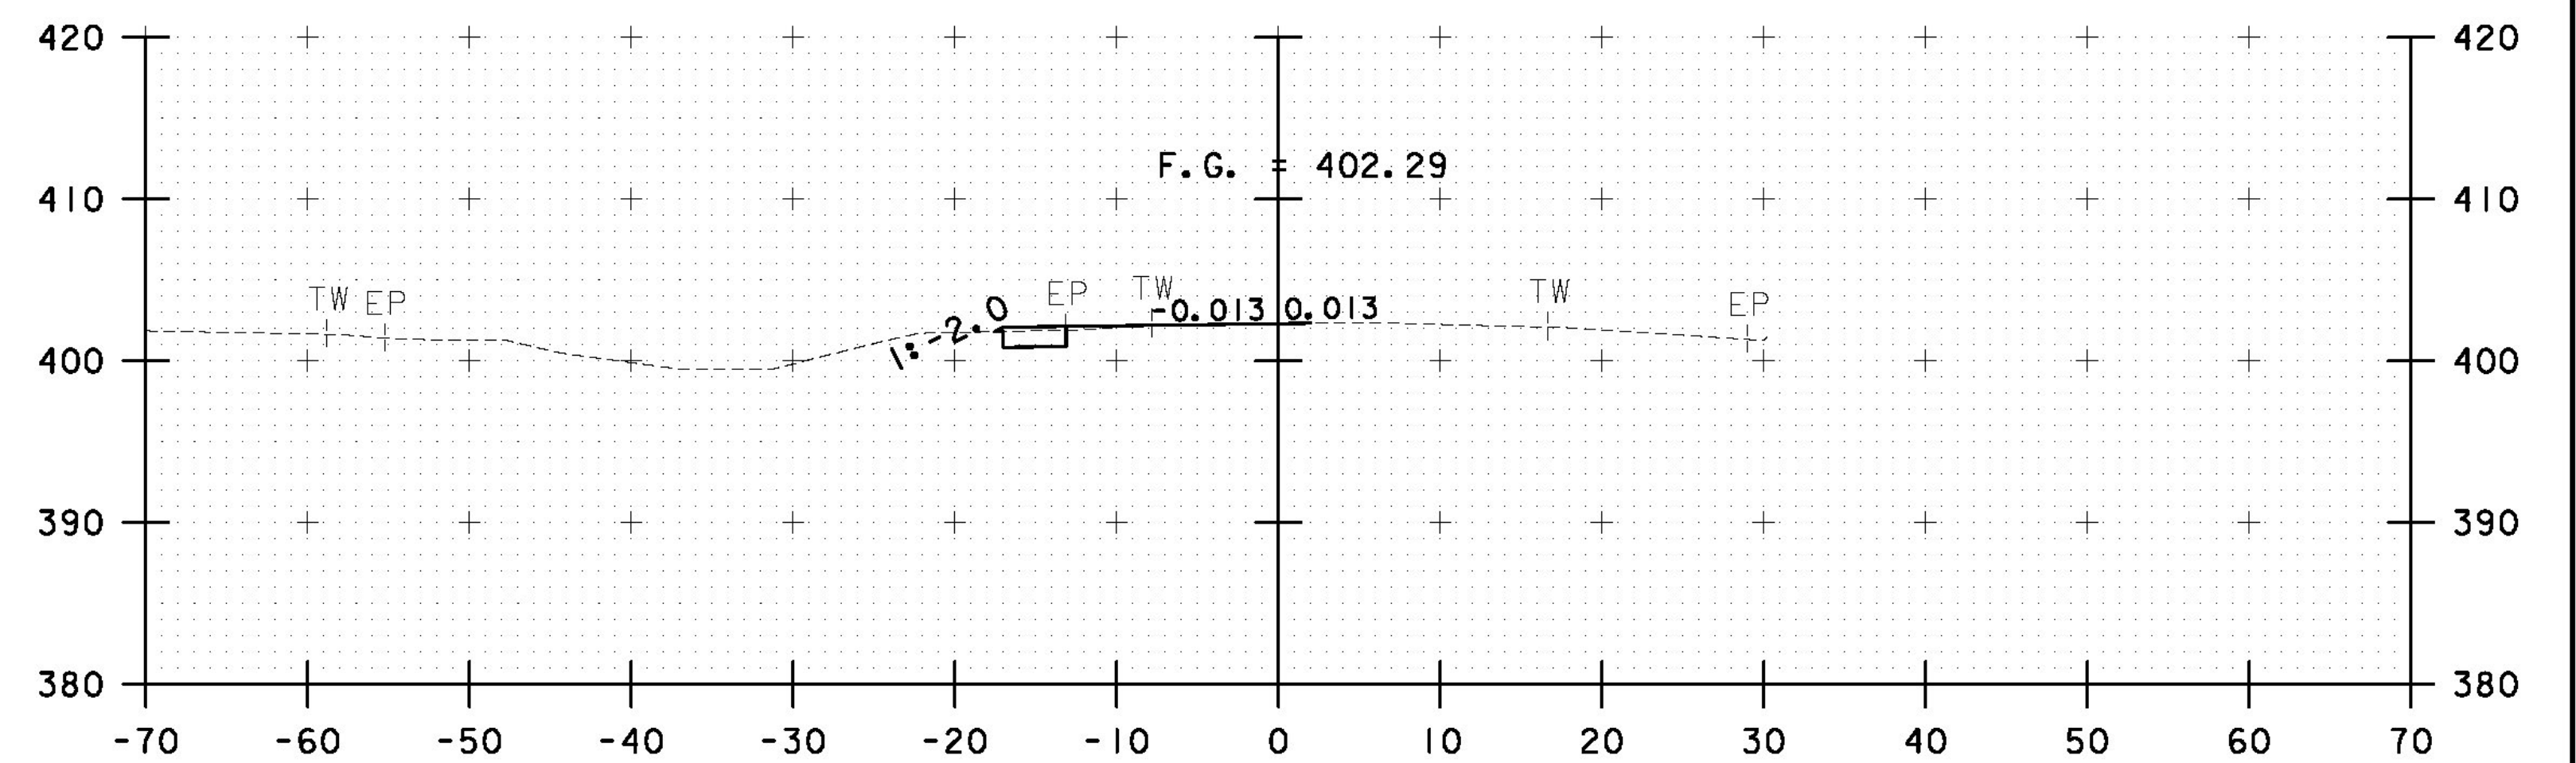

1001+50

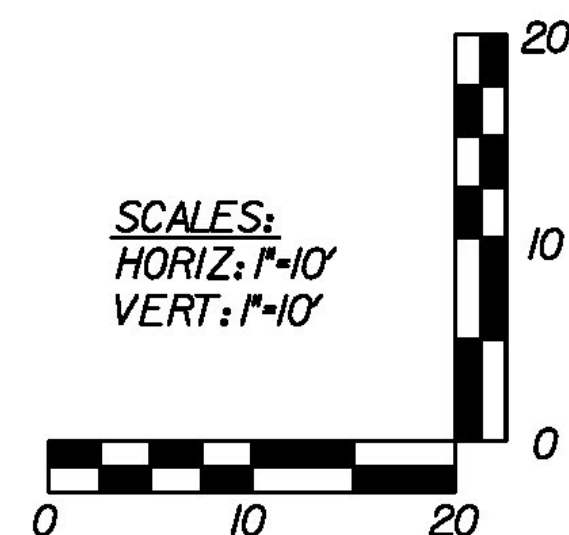

**AS BUILT
RECORD PLANS**

RFC PLANS - WORK PACKAGE #10
SOUTHBOUND APPROACH
MARCH 1, 2012

BECK & BELLUCCI, INC.

TYLIN INTERNATIONAL

STA. 1000+00 TO STA. 1002+50

PROJECT NAME: BRATTLEBORO

PROJECT NUMBER: IM_091-1(50)

FILE NAME: HW-100-SC0-900.dgn PLOT DATE: 3/1/2012

PROJECT LEADER: Phillip E. Kendall P.E. DRAWN BY: A. Greenlaw

DESIGNED BY: Phillip E. Kendall P.E. CHECKED BY: D. BRYANT P.E.

SOUTHBOUND CROSSOVER CROSS SECTIONS SHEET HW-100-SC0-901