




1003+50

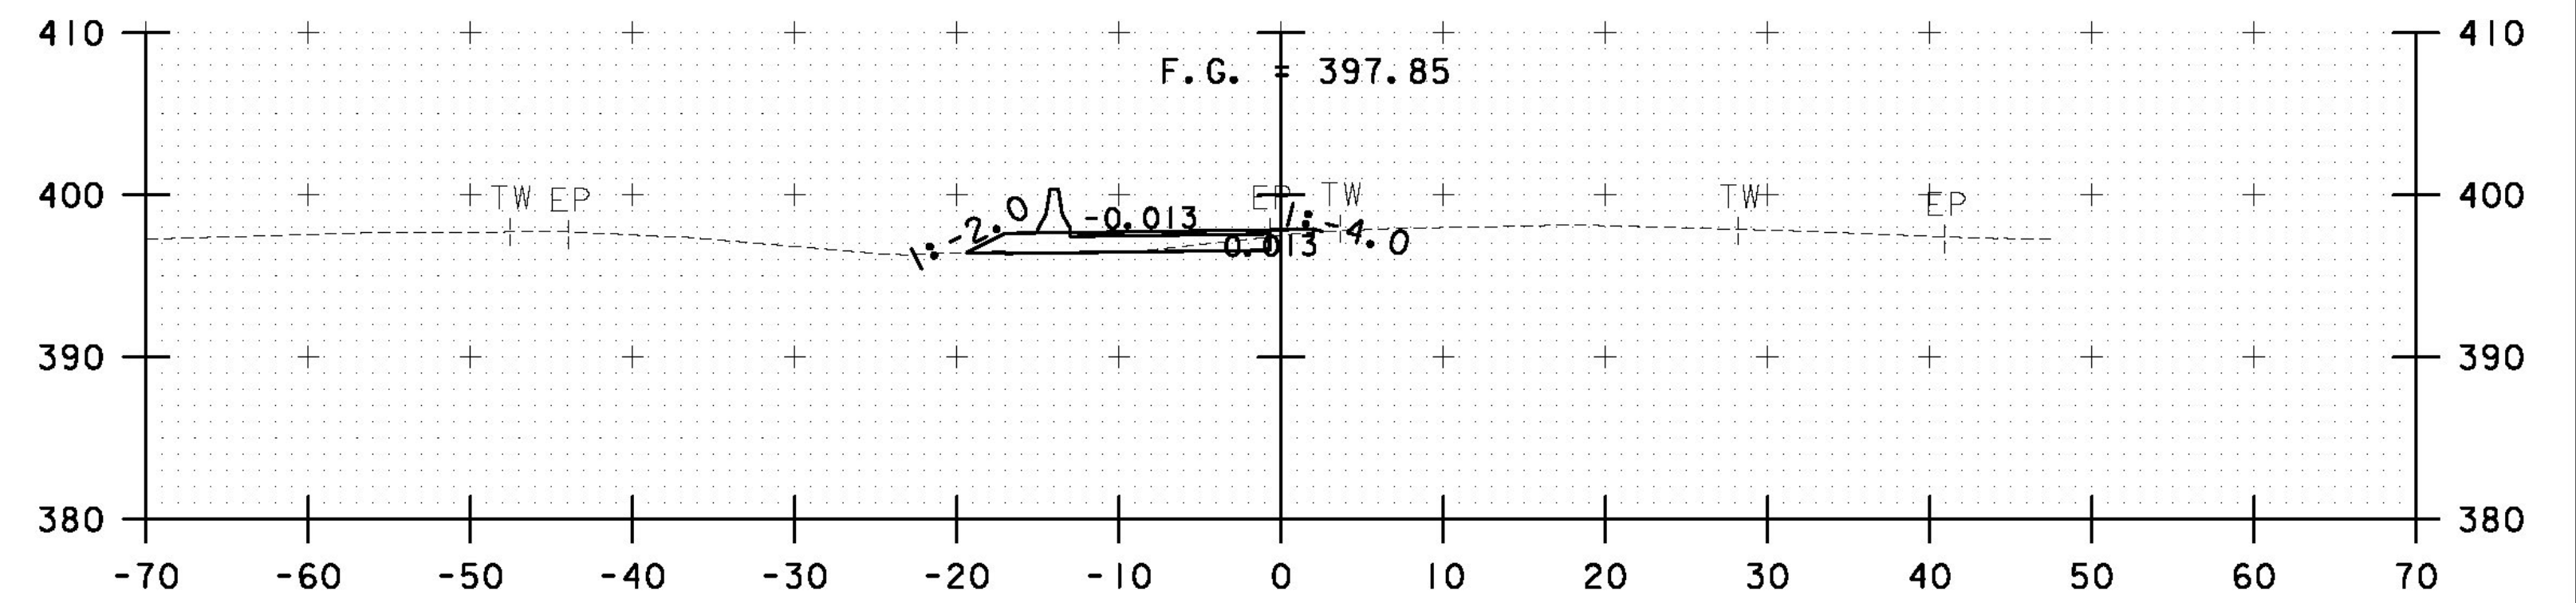


1004+50

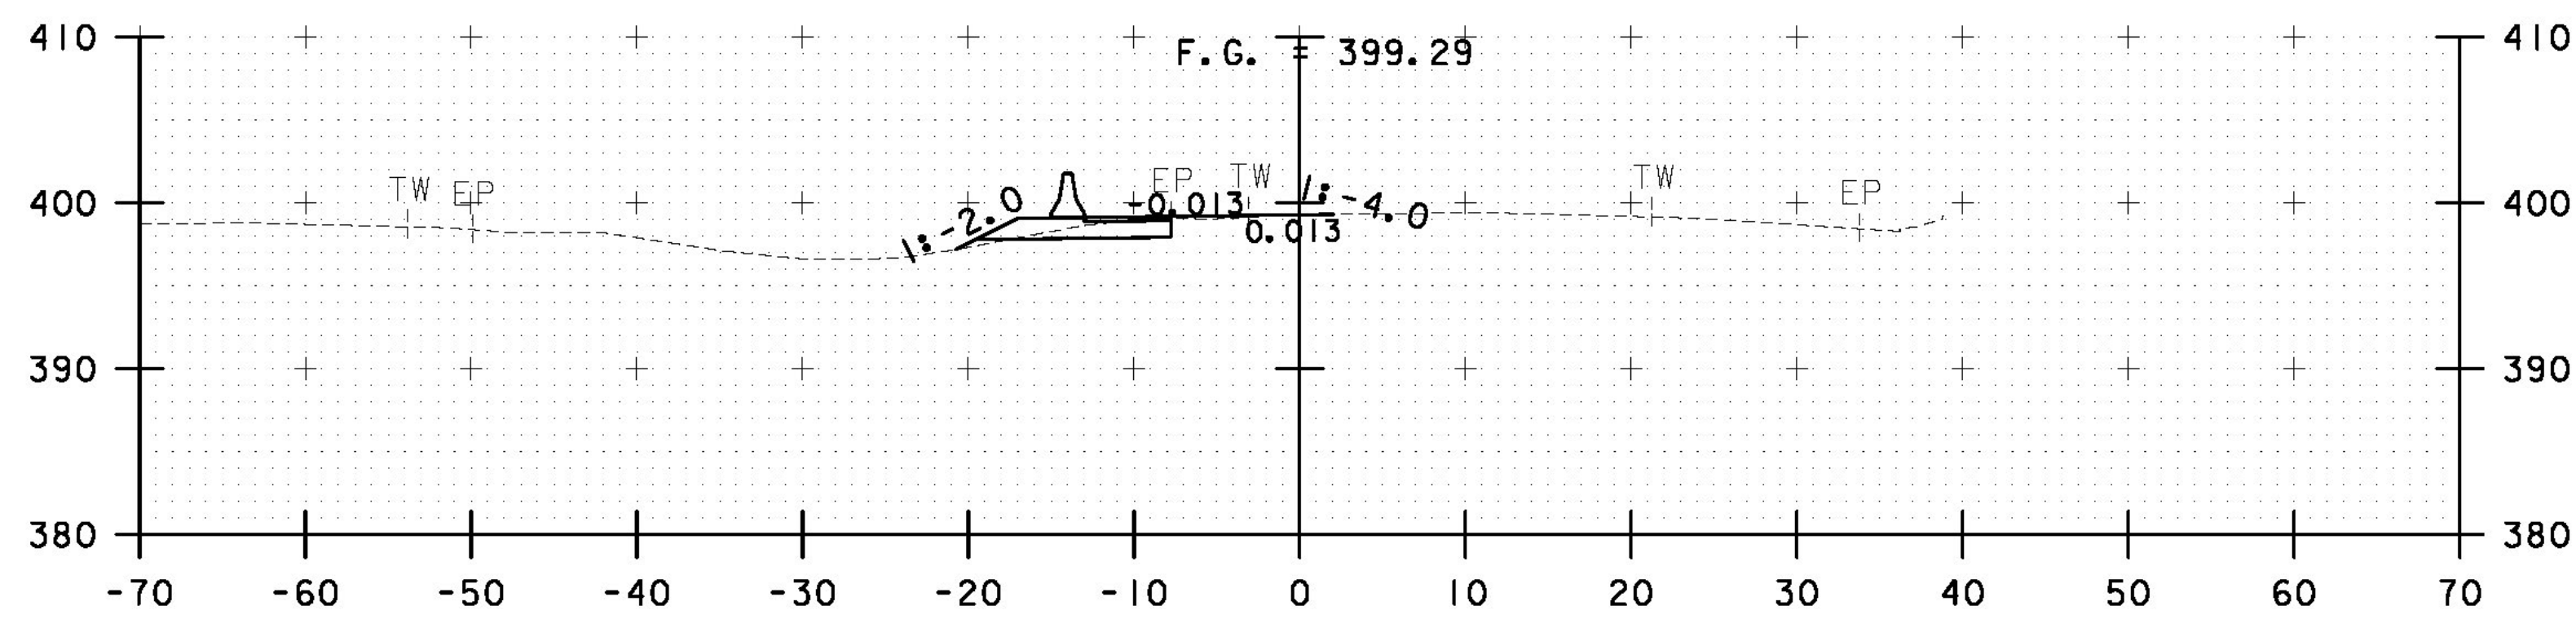


1003+00

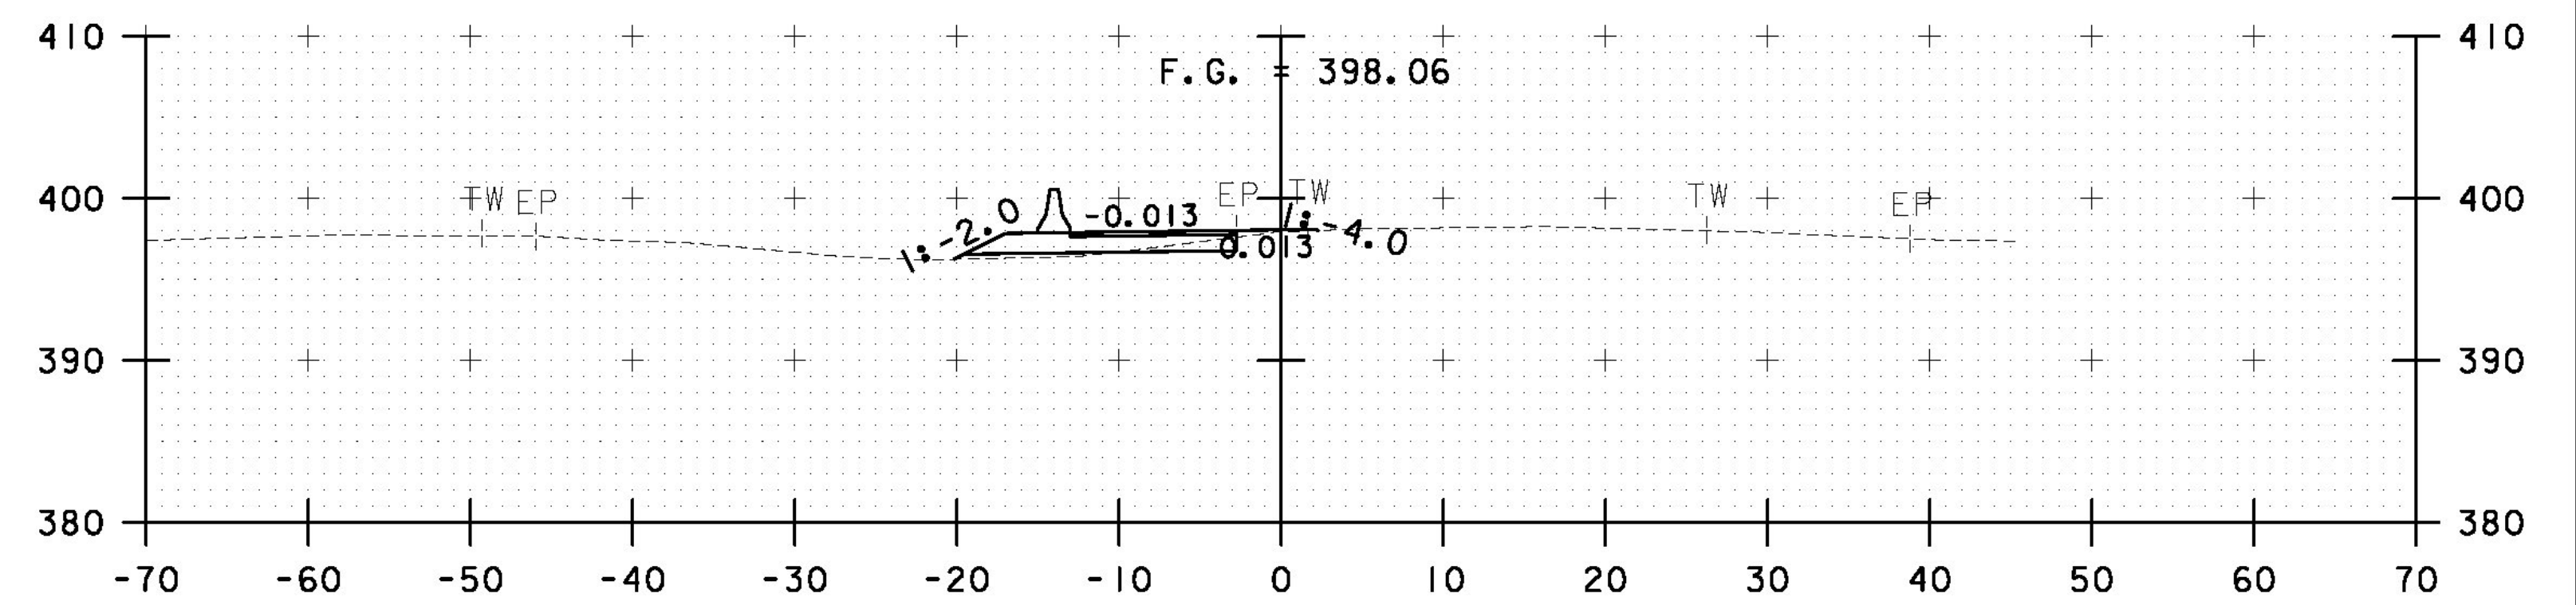


1004+25

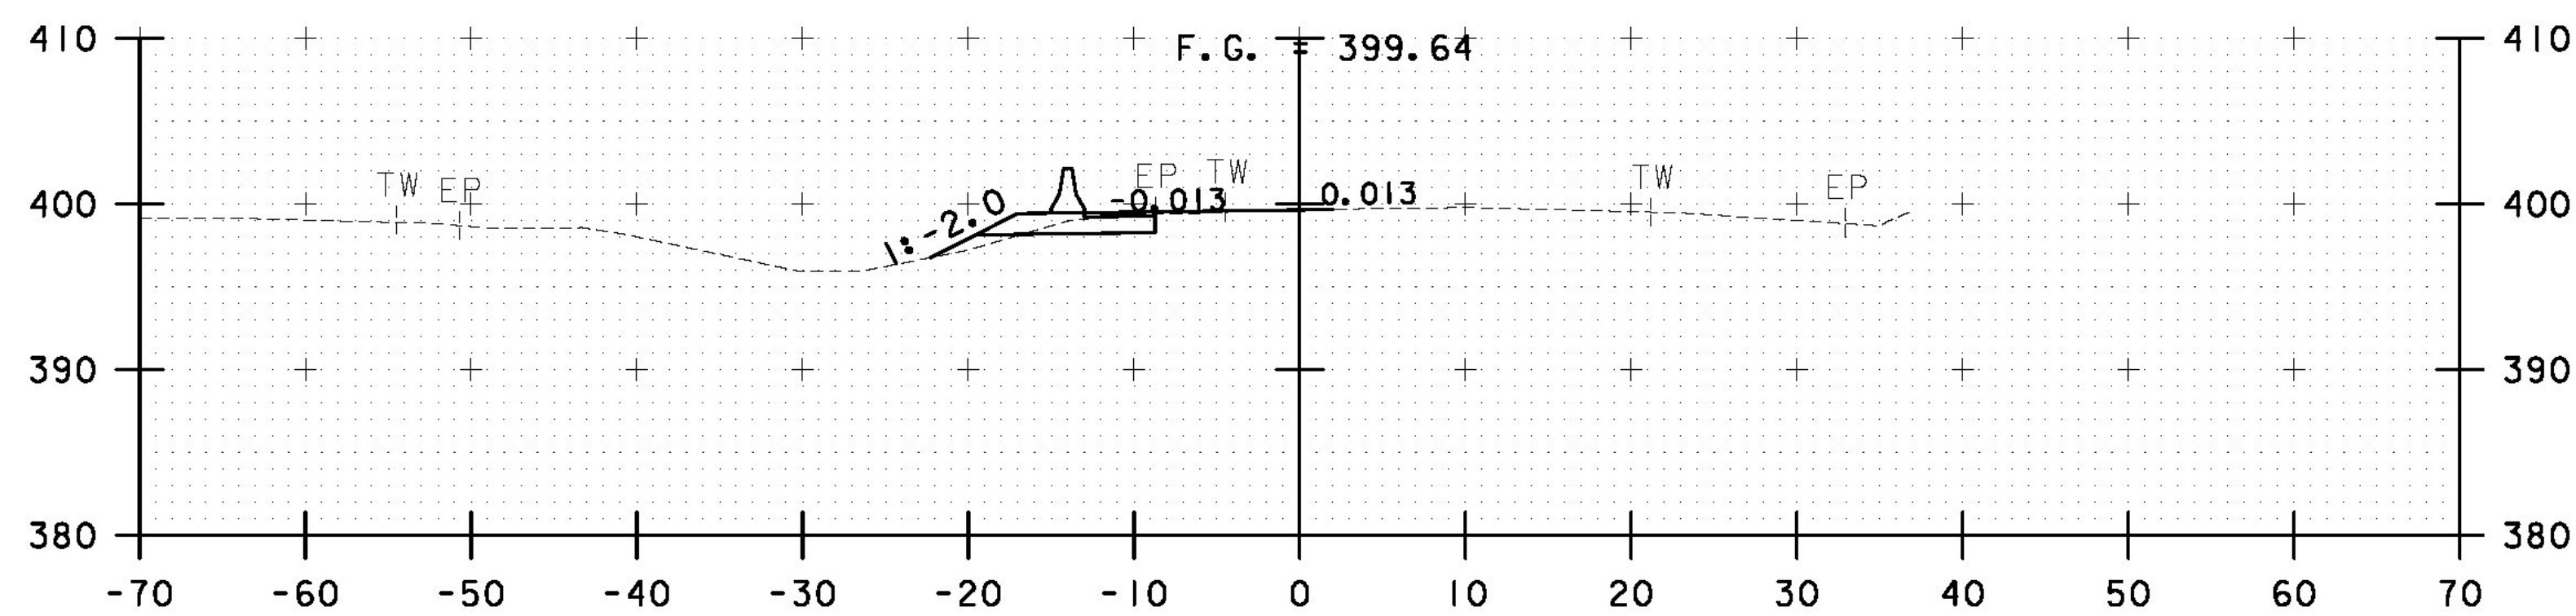

1002+75

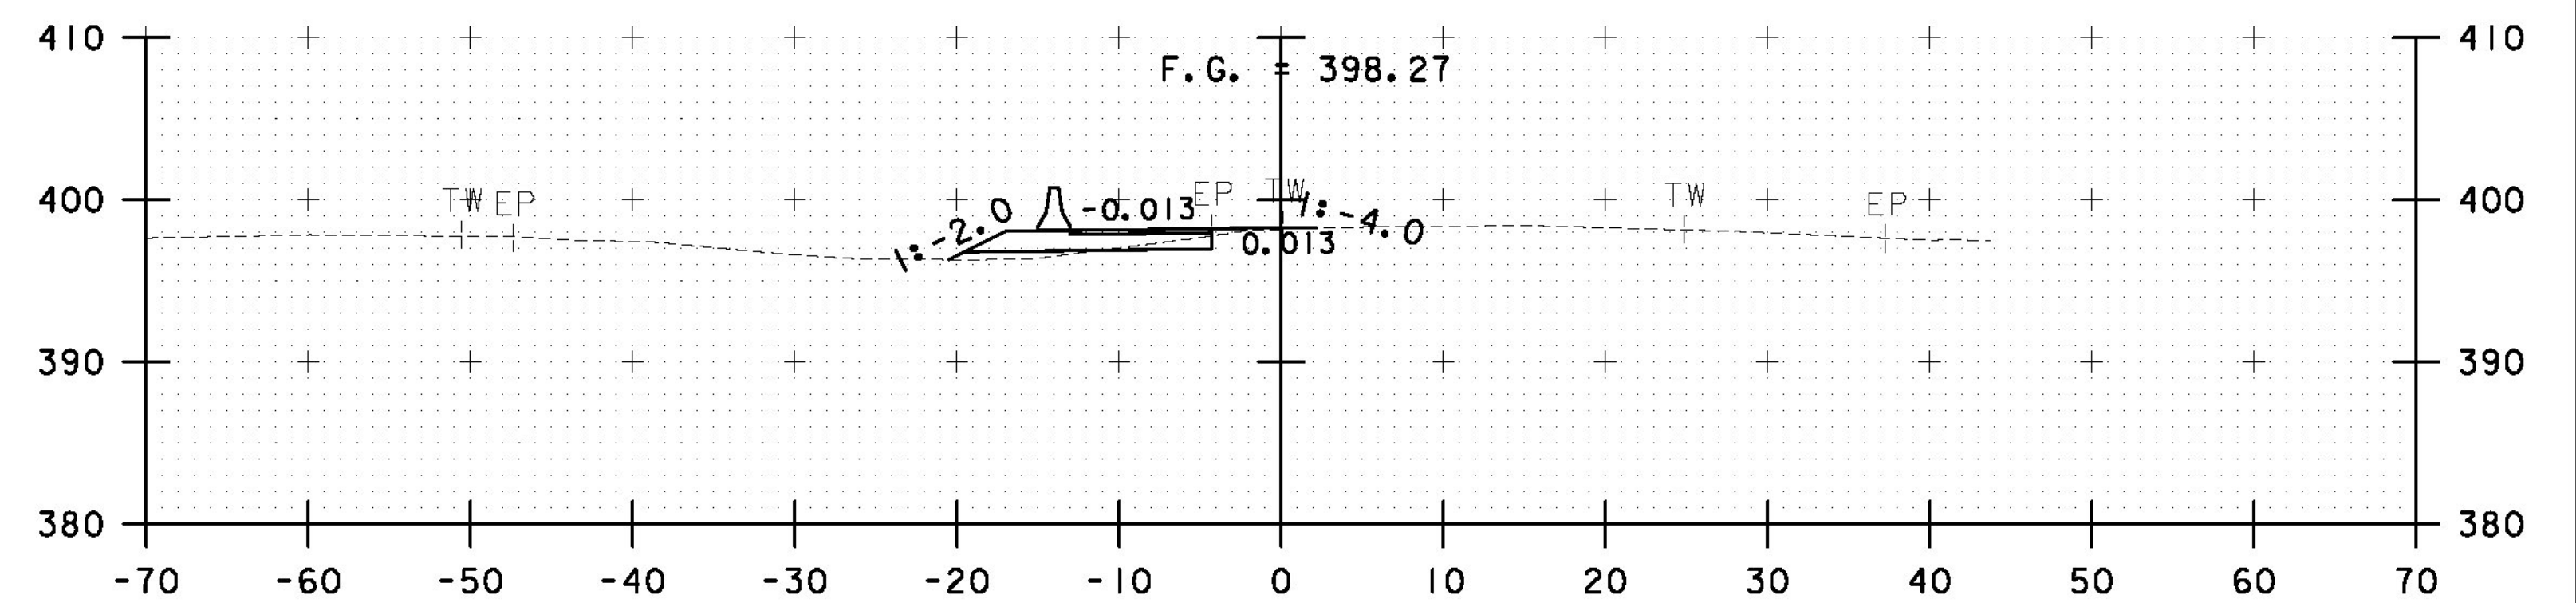

1004+00

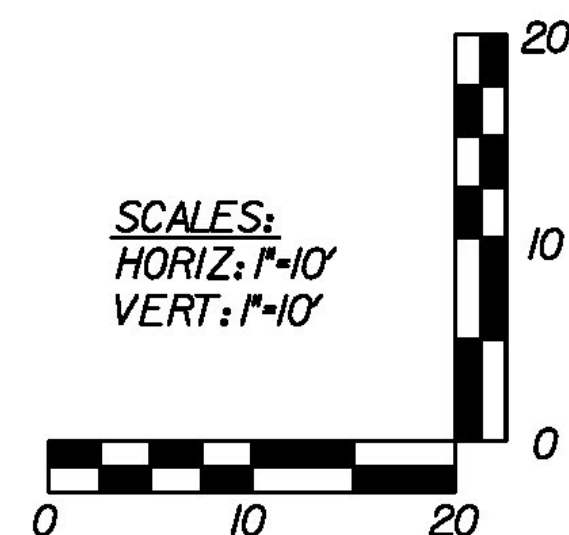

**AS BUILT
RECORD PLANS**

RFC PLANS - WORK PACKAGE #10
SOUTHBOUND APPROACH
MARCH 1, 2012

BECK & BELLUCCI, INC. TYLIN INTERNATIONAL

STA. 1002+75 TO STA. 1004+50

PROJECT NAME: BRATTLEBORO

PROJECT NUMBER: 1M_091-(150)

FILE NAME: HW-100-SC0-900.dgn PLOT DATE: 3/1/2012

PROJECT LEADER: Phillip E. Kendall P.E. DRAWN BY: A. Greenlaw

DESIGNED BY: Phillip E. Kendall II, P.E. CHECKED BY: D. BRYANT P.E.

SOUTHBOUND CROSSOVER CROSS SECTIONS SHEET HW-100-SC0-902