




1006+00

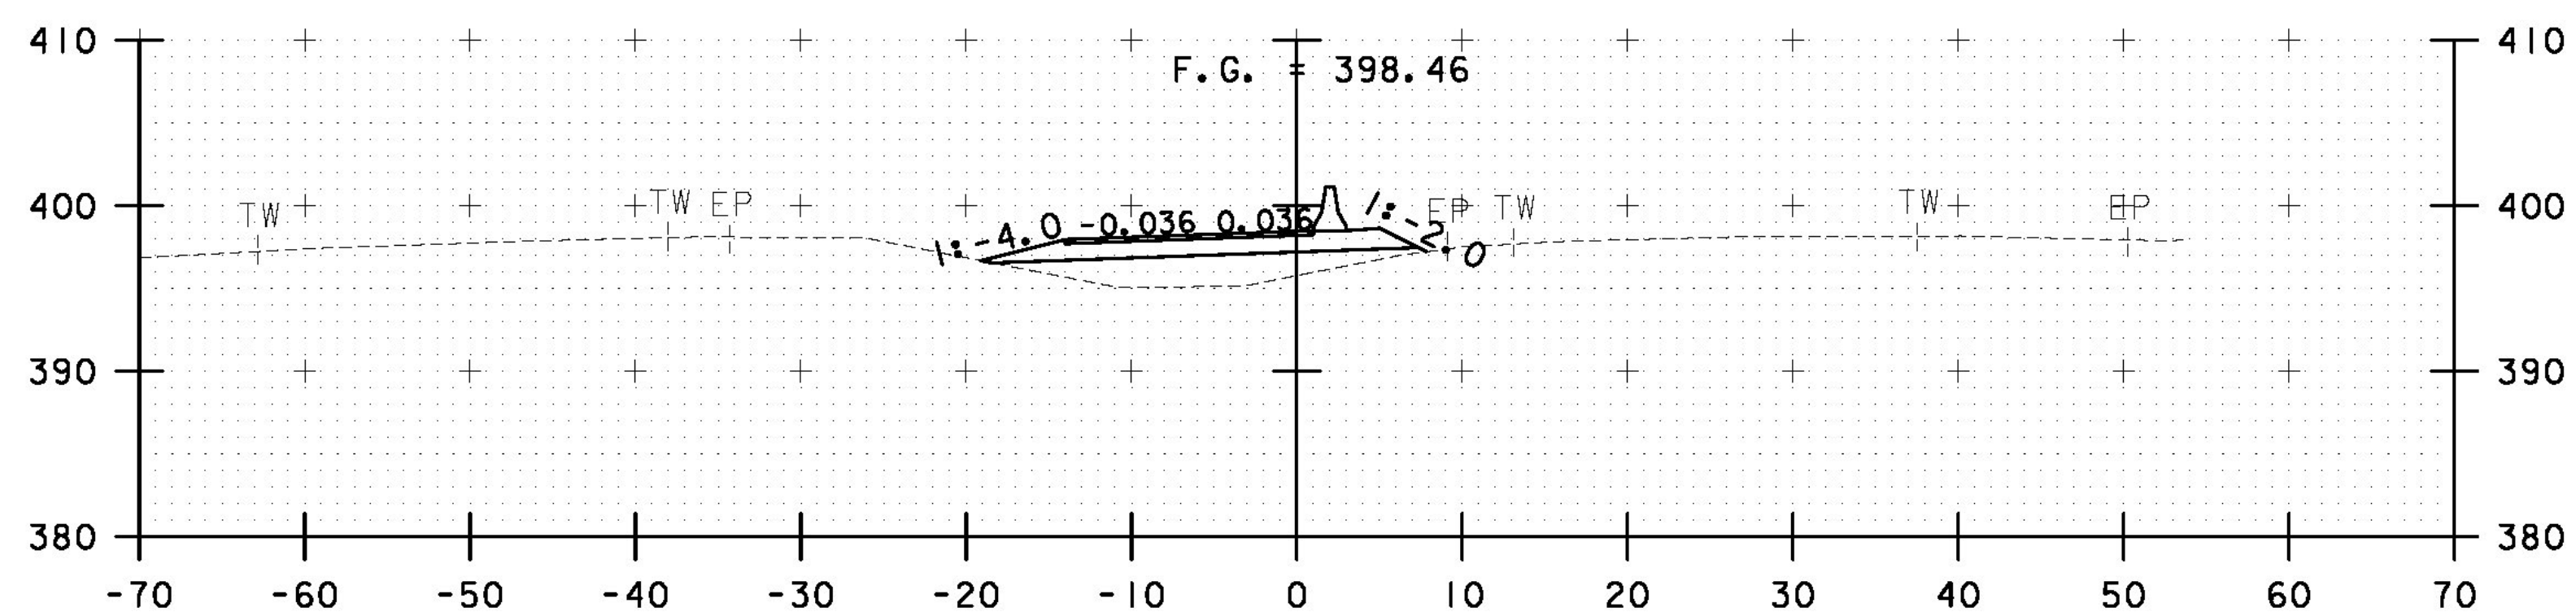


1005+50

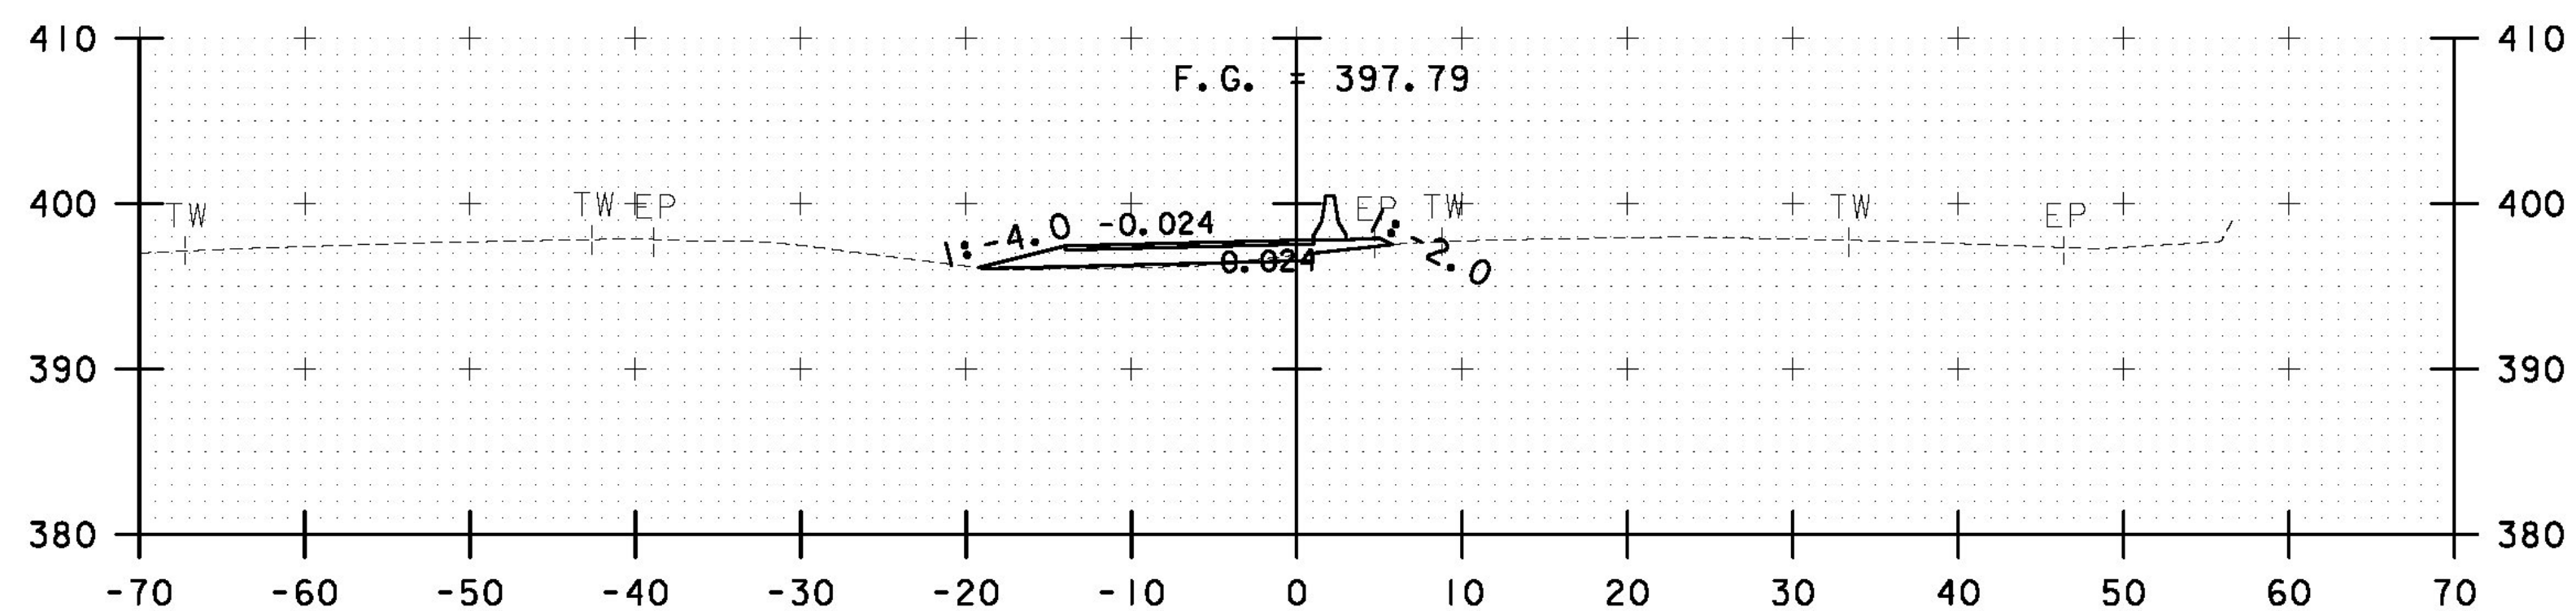


1005+00

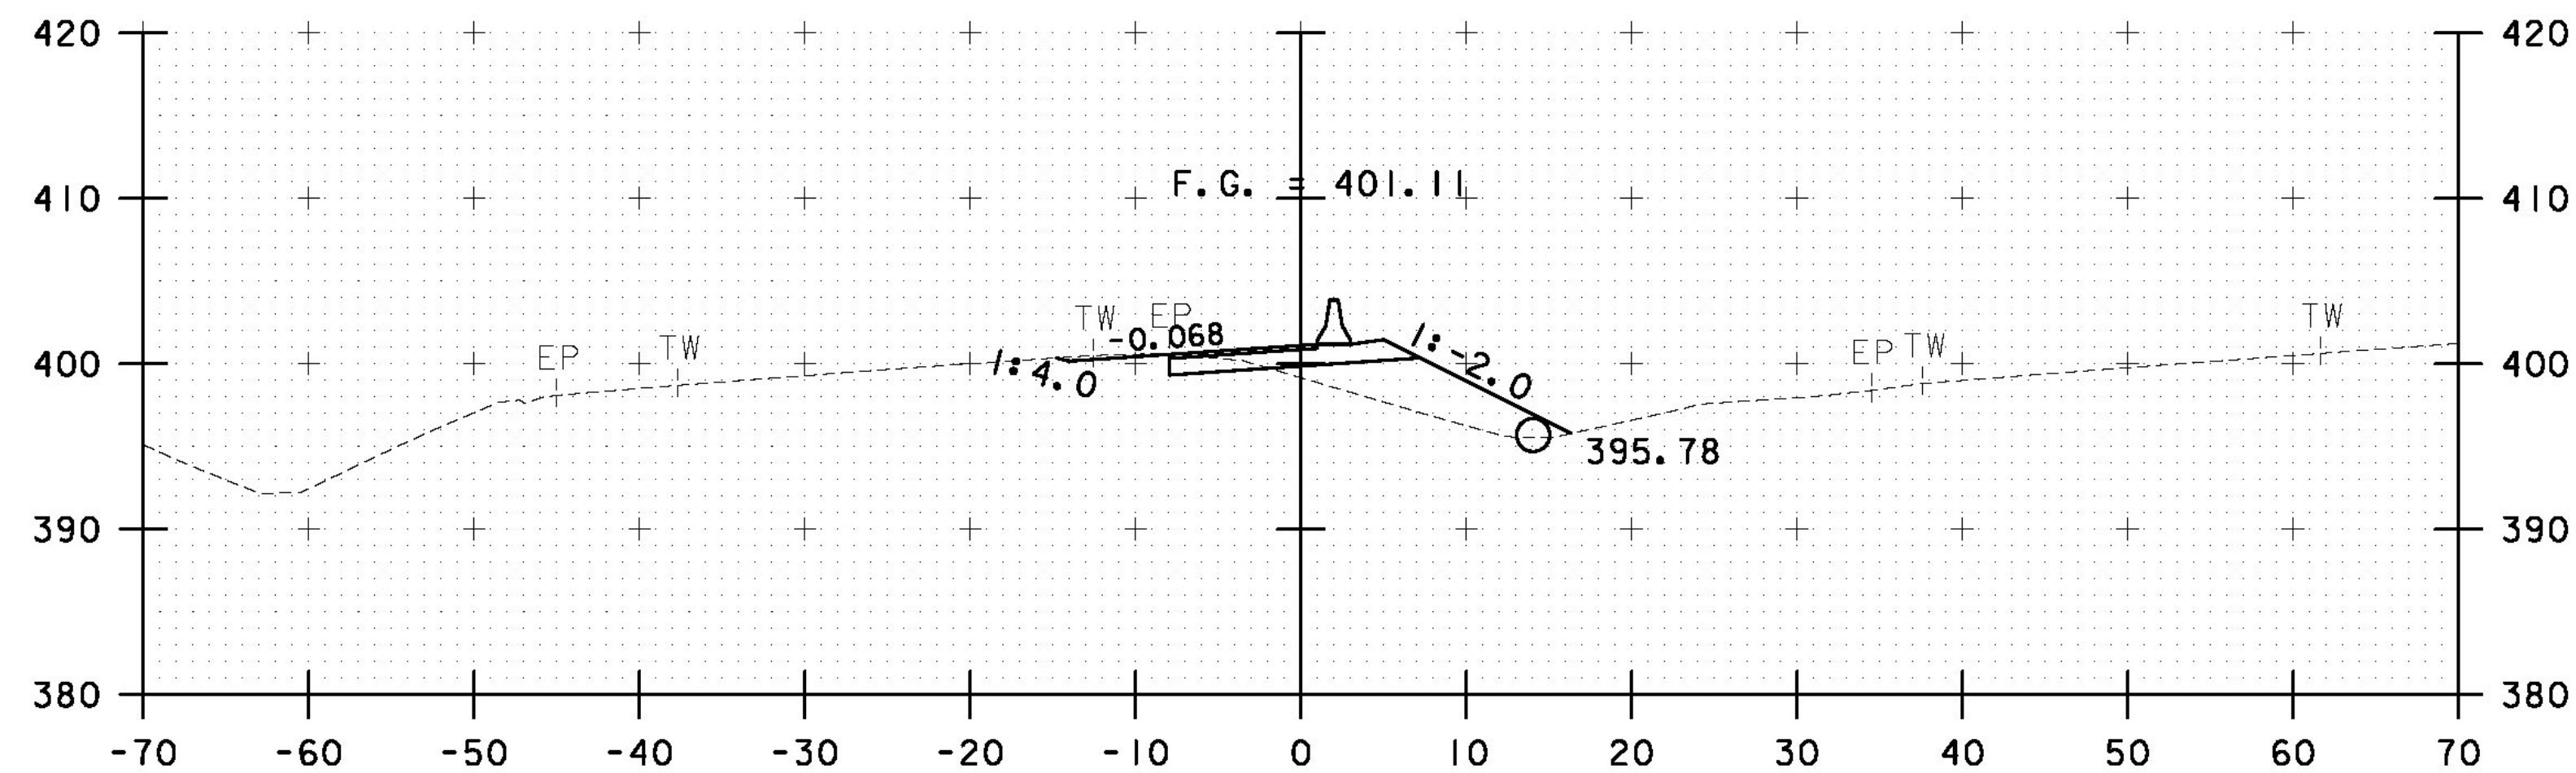


1007+50

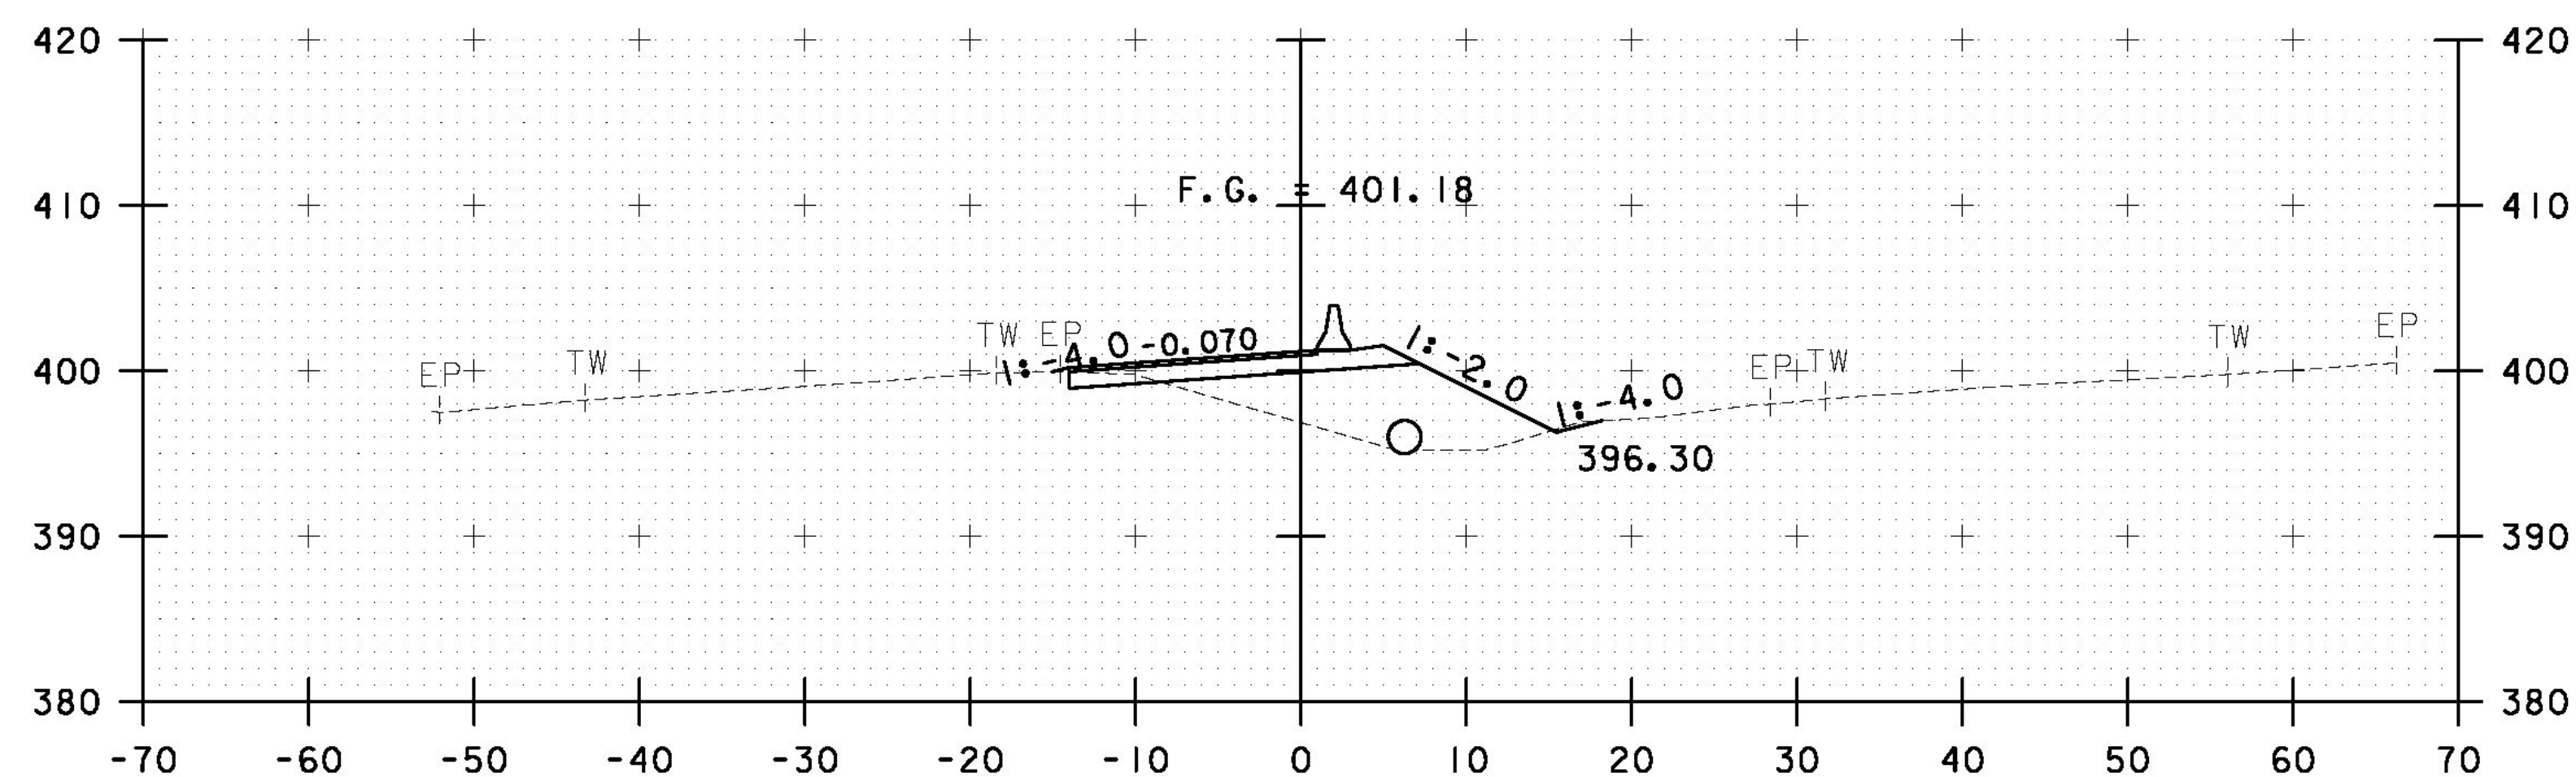

1007+00

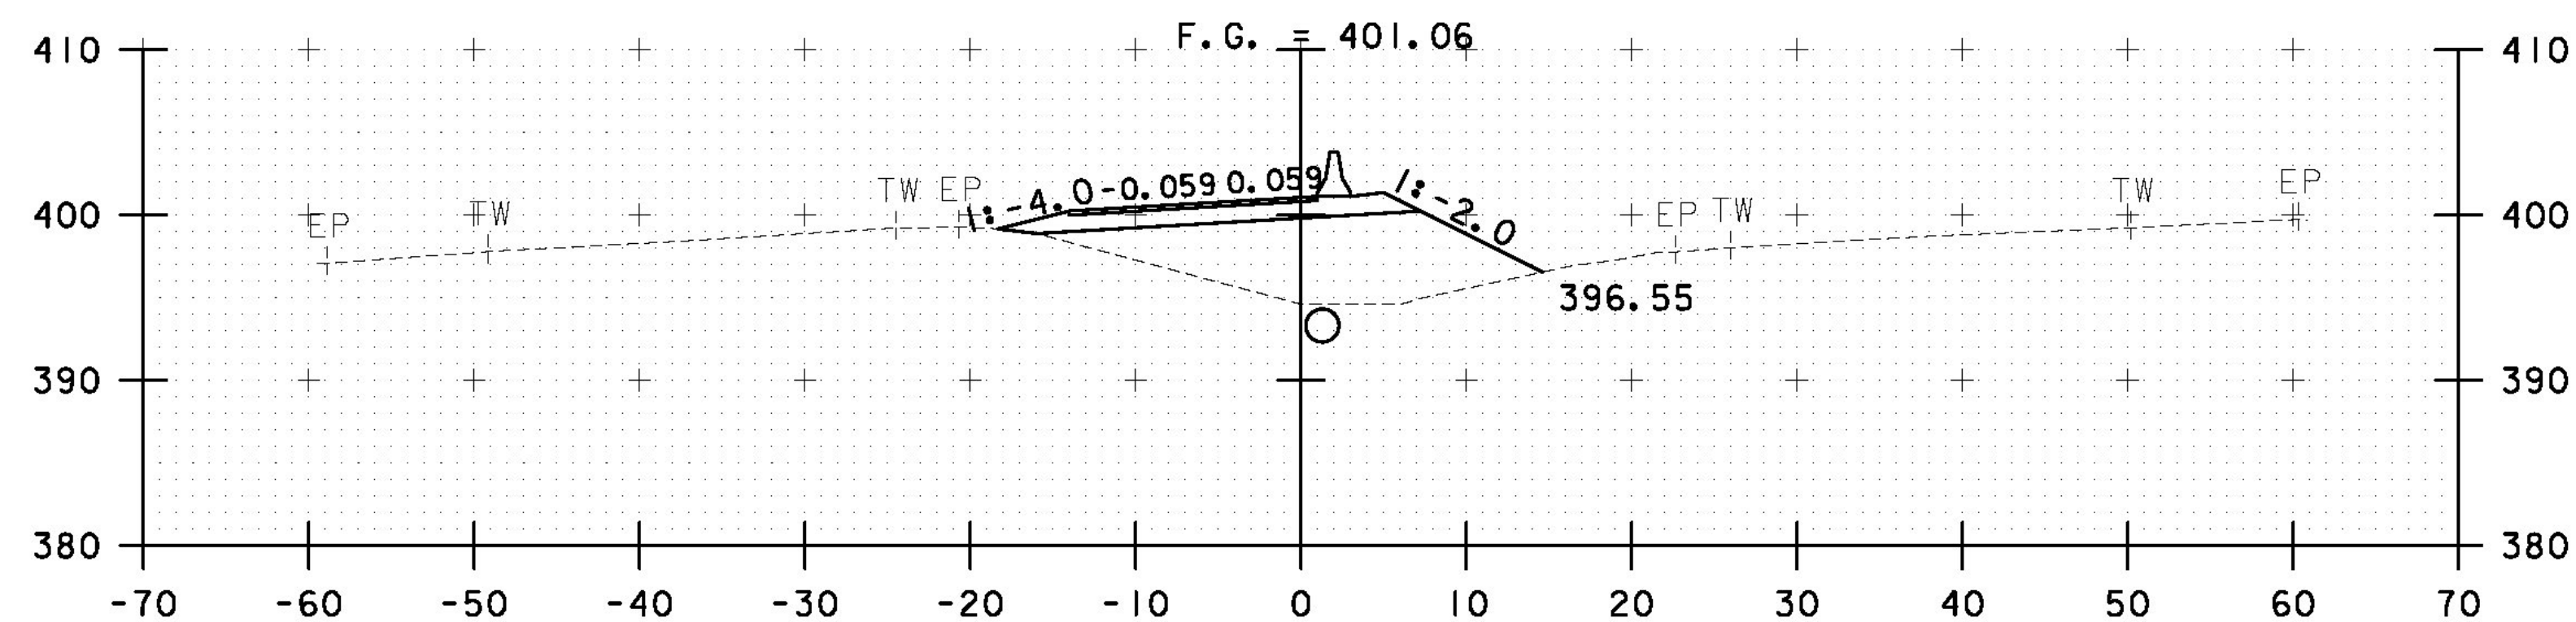

1006+50

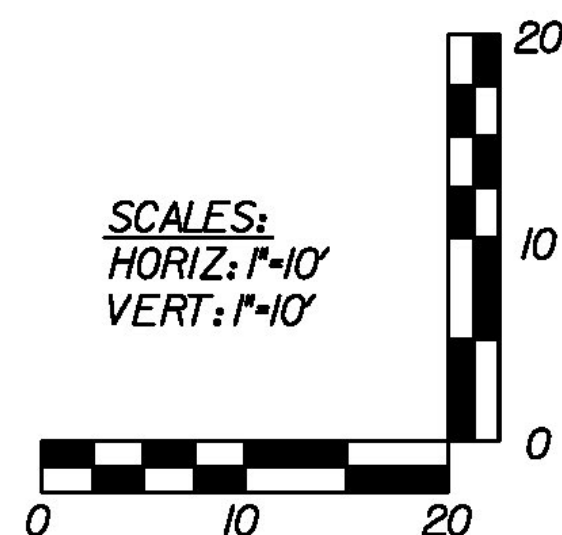

**AS BUILT  
RECORD PLANS**

RFC PLANS - WORK PACKAGE #10  
SOUTHBOUND APPROACH  
MARCH 1, 2012

STA. 1005+00 TO STA. 1007+50

PROJECT NAME: BRATTLEBORO

PROJECT NUMBER: 1M\_091-(150)

BECK & BELLUCCI, INC. TYLIN INTERNATIONAL

FILE NAME: HW-100-SC0-900.dgn PLOT DATE: 3/1/2012  
PROJECT LEADER: Phillip E. Kendall P.E. DRAWN BY: A. Greenlaw  
DESIGNED BY: Phillip E. Kendall P.E. CHECKED BY: D. BRYANT P.E.  
SOUTHBOUND CROSSOVER CROSS SECTIONS SHEET HW-100-SC0-903