



1008+50

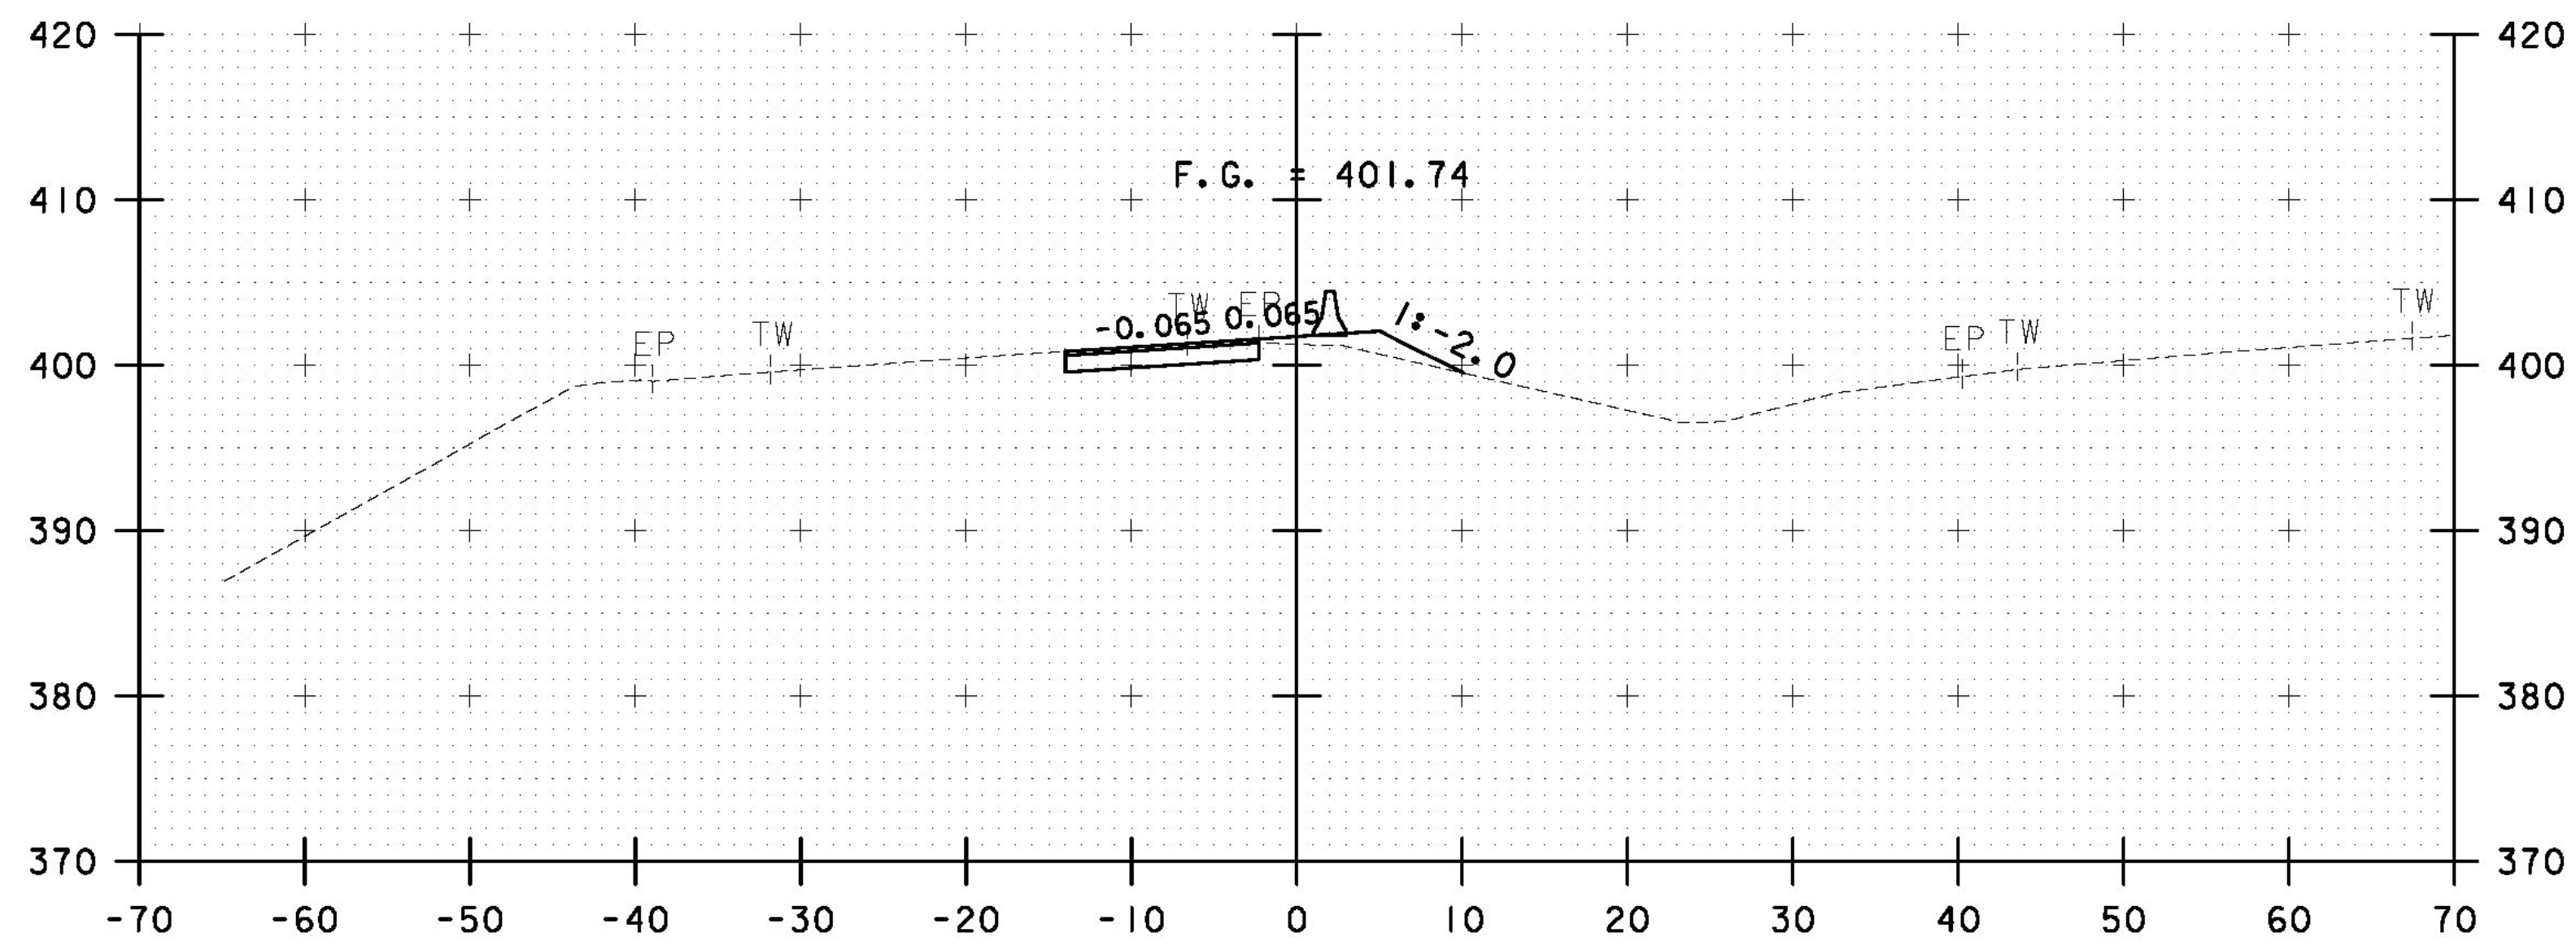

1008+00

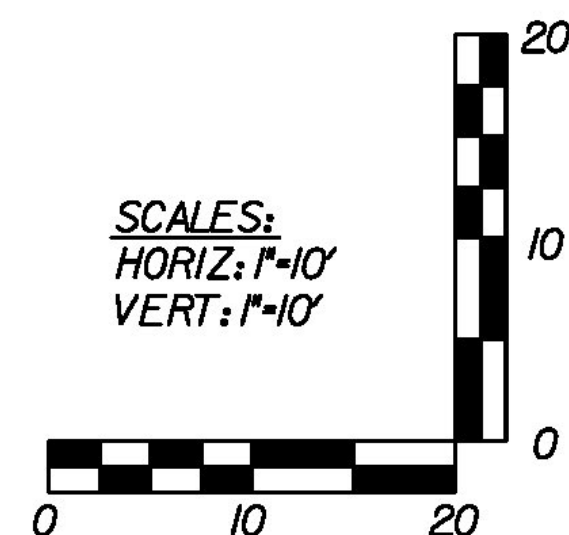

**AS BUILT
RECORD PLANS**

RFC PLANS - WORK PACKAGE #10
SOUTHBOUND APPROACH
MARCH 1, 2012

STA. 1008+00 TO STA. 1008+50

PROJECT NAME: BRATTLEBORO

PROJECT NUMBER: IM_091-(50)

BECK & BELLUCCI, INC. TYLIN INTERNATIONAL

FILE NAME: HW-100-SC0-900.dgn PLOT DATE: 3/1/2012

PROJECT LEADER: Phillip E. Kendall P.E. DRAWN BY: A. Greenlaw

DESIGNED BY: Phillip E. Kendall II, P.E. CHECKED BY: D. BRYANT P.E.

SOUTHBOUND CROSSOVER CROSS SECTIONS SHEET HW-100-SC0-904