




2000+50

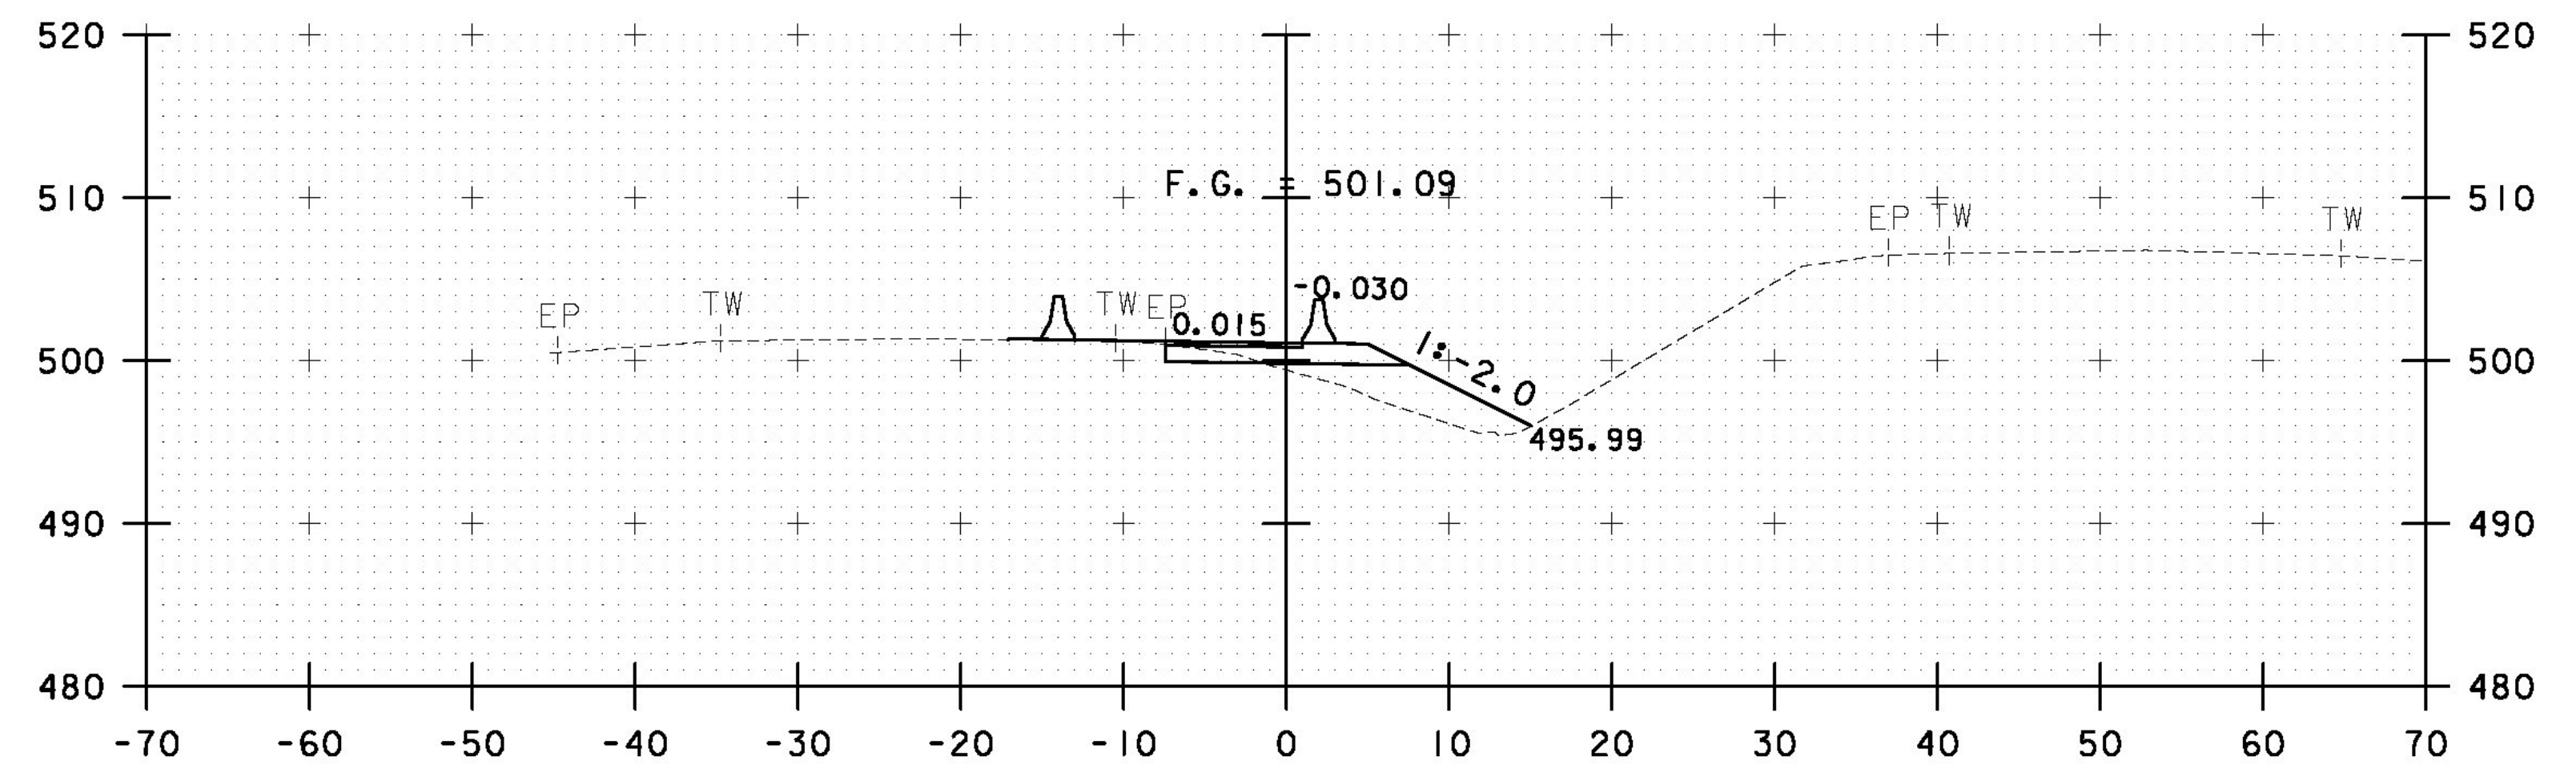


2001+50

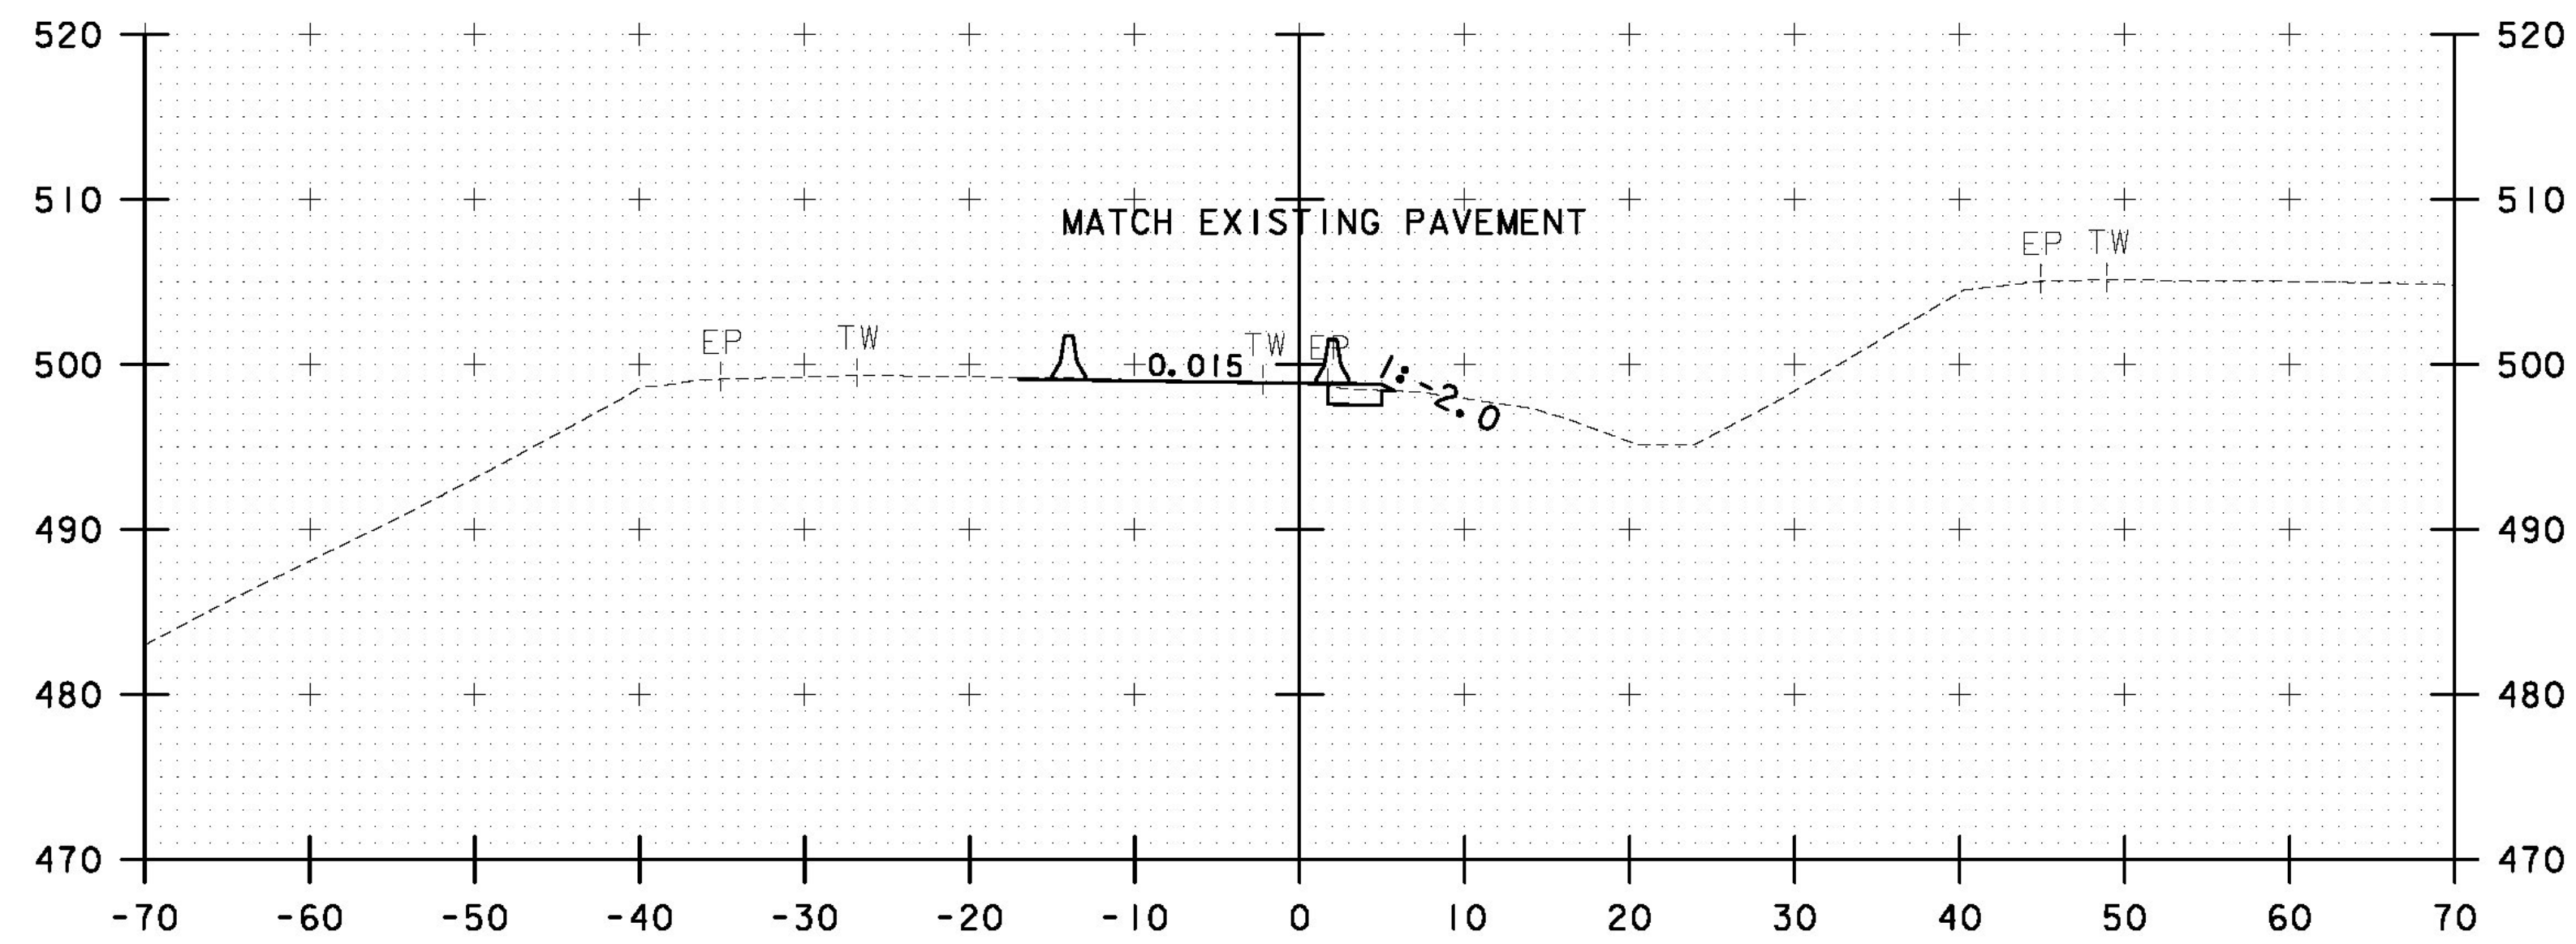

2000+00

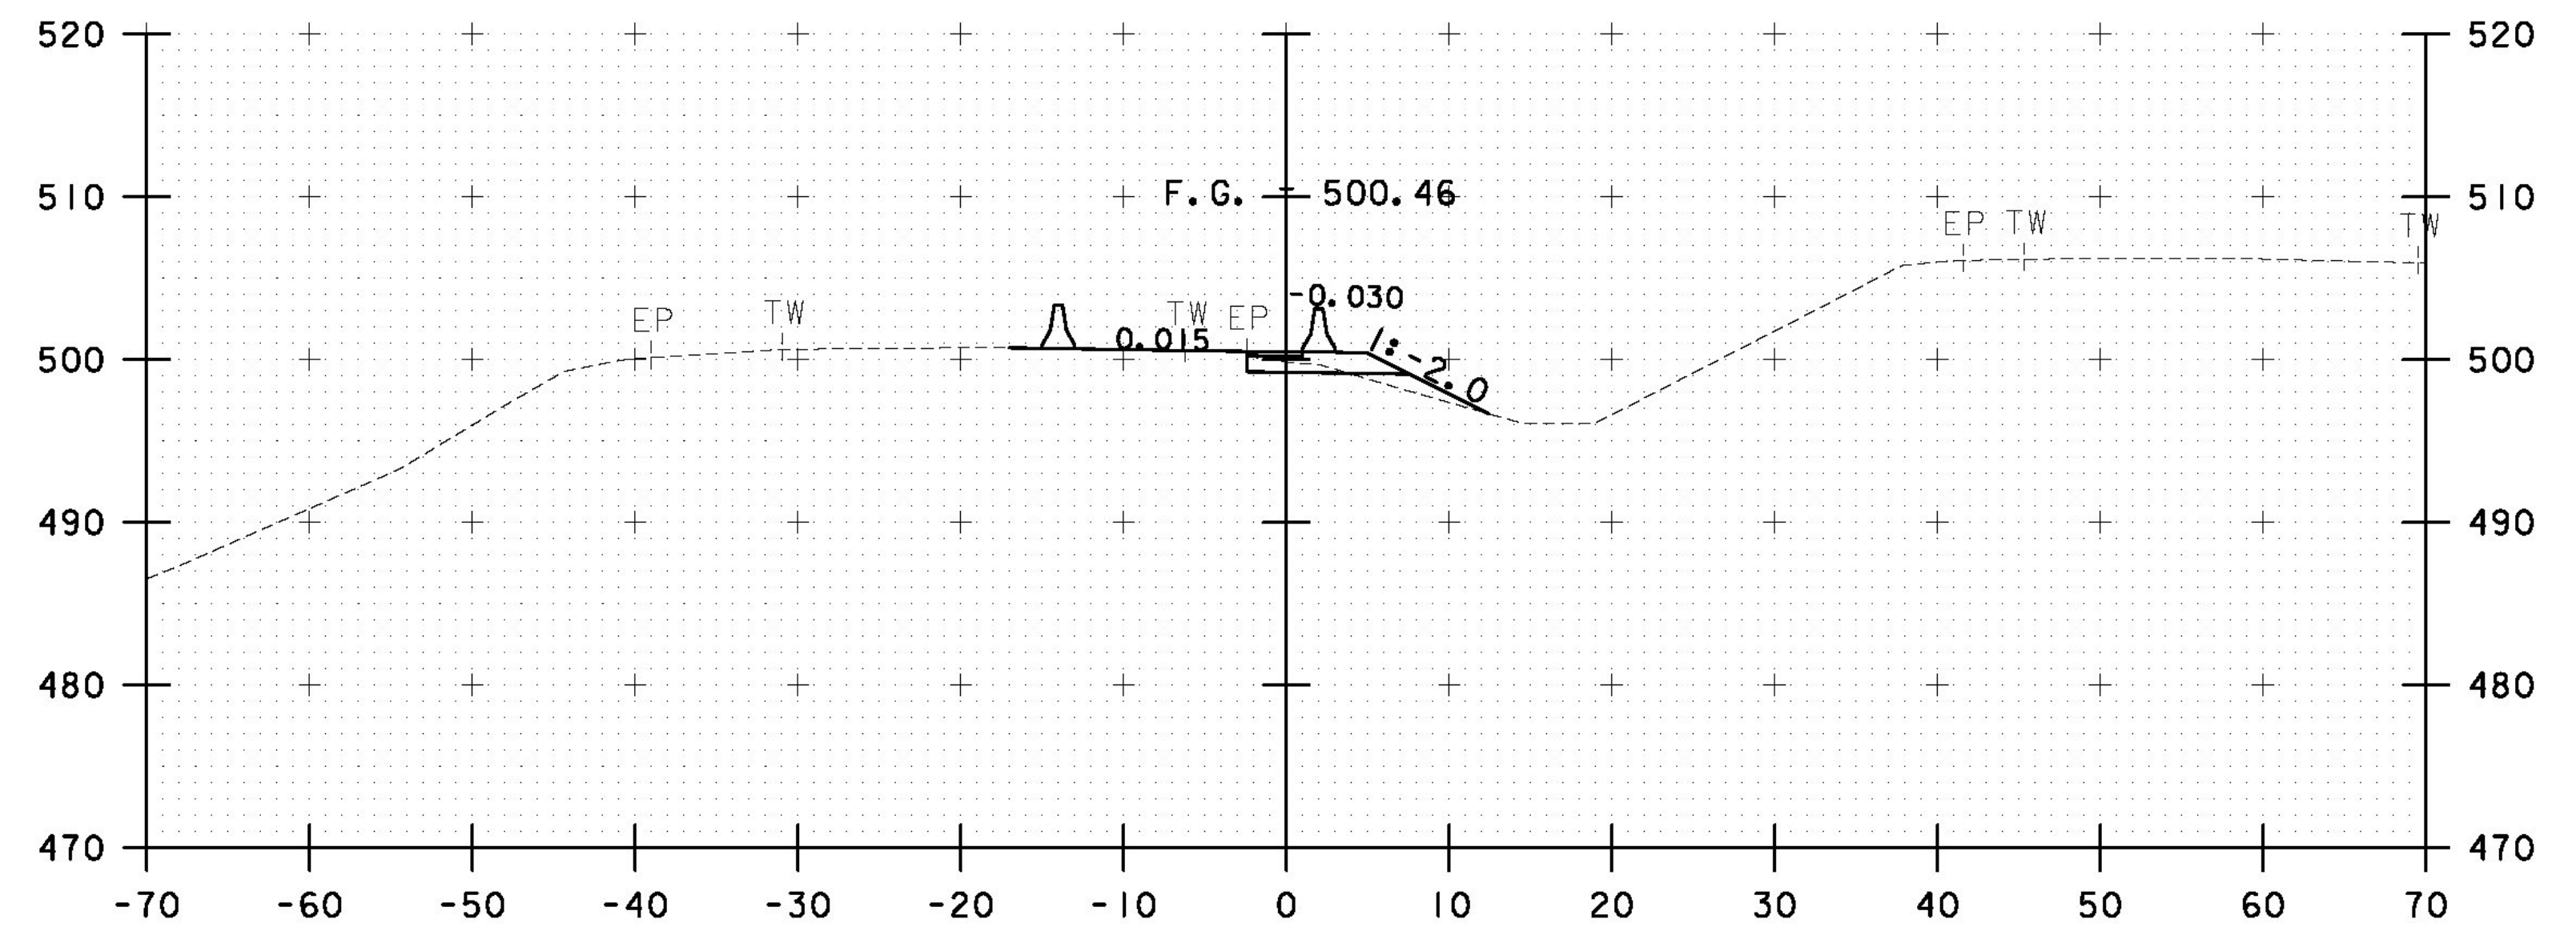

2001+00

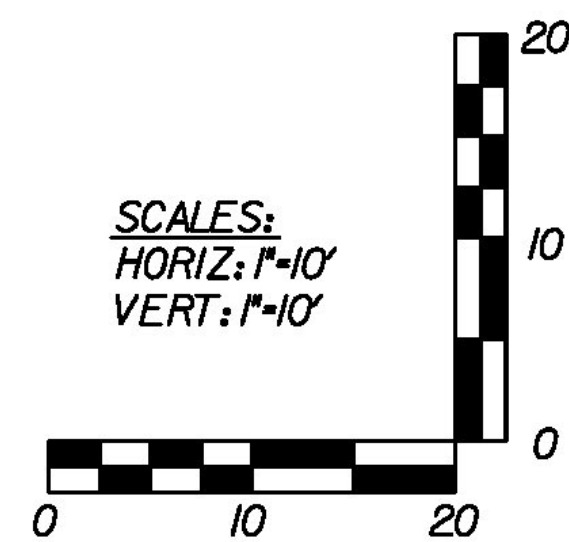

**AS BUILT  
RECORD PLANS**

RFC PLANS - WORK PACKAGE #10  
SOUTHBOUND APPROACH  
MARCH 1, 2012

STA. 2000+00 TO STA. 2001+50

PROJECT NAME: BRATTLEBORO

PROJECT NUMBER: IM\_091-(150)

BECK & BELLUCCI, INC. TYLIN INTERNATIONAL

FILE NAME: HW-100-SC0-900.dgn PLOT DATE: 3/1/2012  
PROJECT LEADER: Phillip E. Kendall P.E. DRAWN BY: A. Greenlaw  
DESIGNED BY: Phillip E. Kendall II, P.E. CHECKED BY: D. BRYANT P.E.  
SOUTHBOUND CROSSOVER CROSS SECTIONS SHEET HW-100-SC0-905