




2005+50

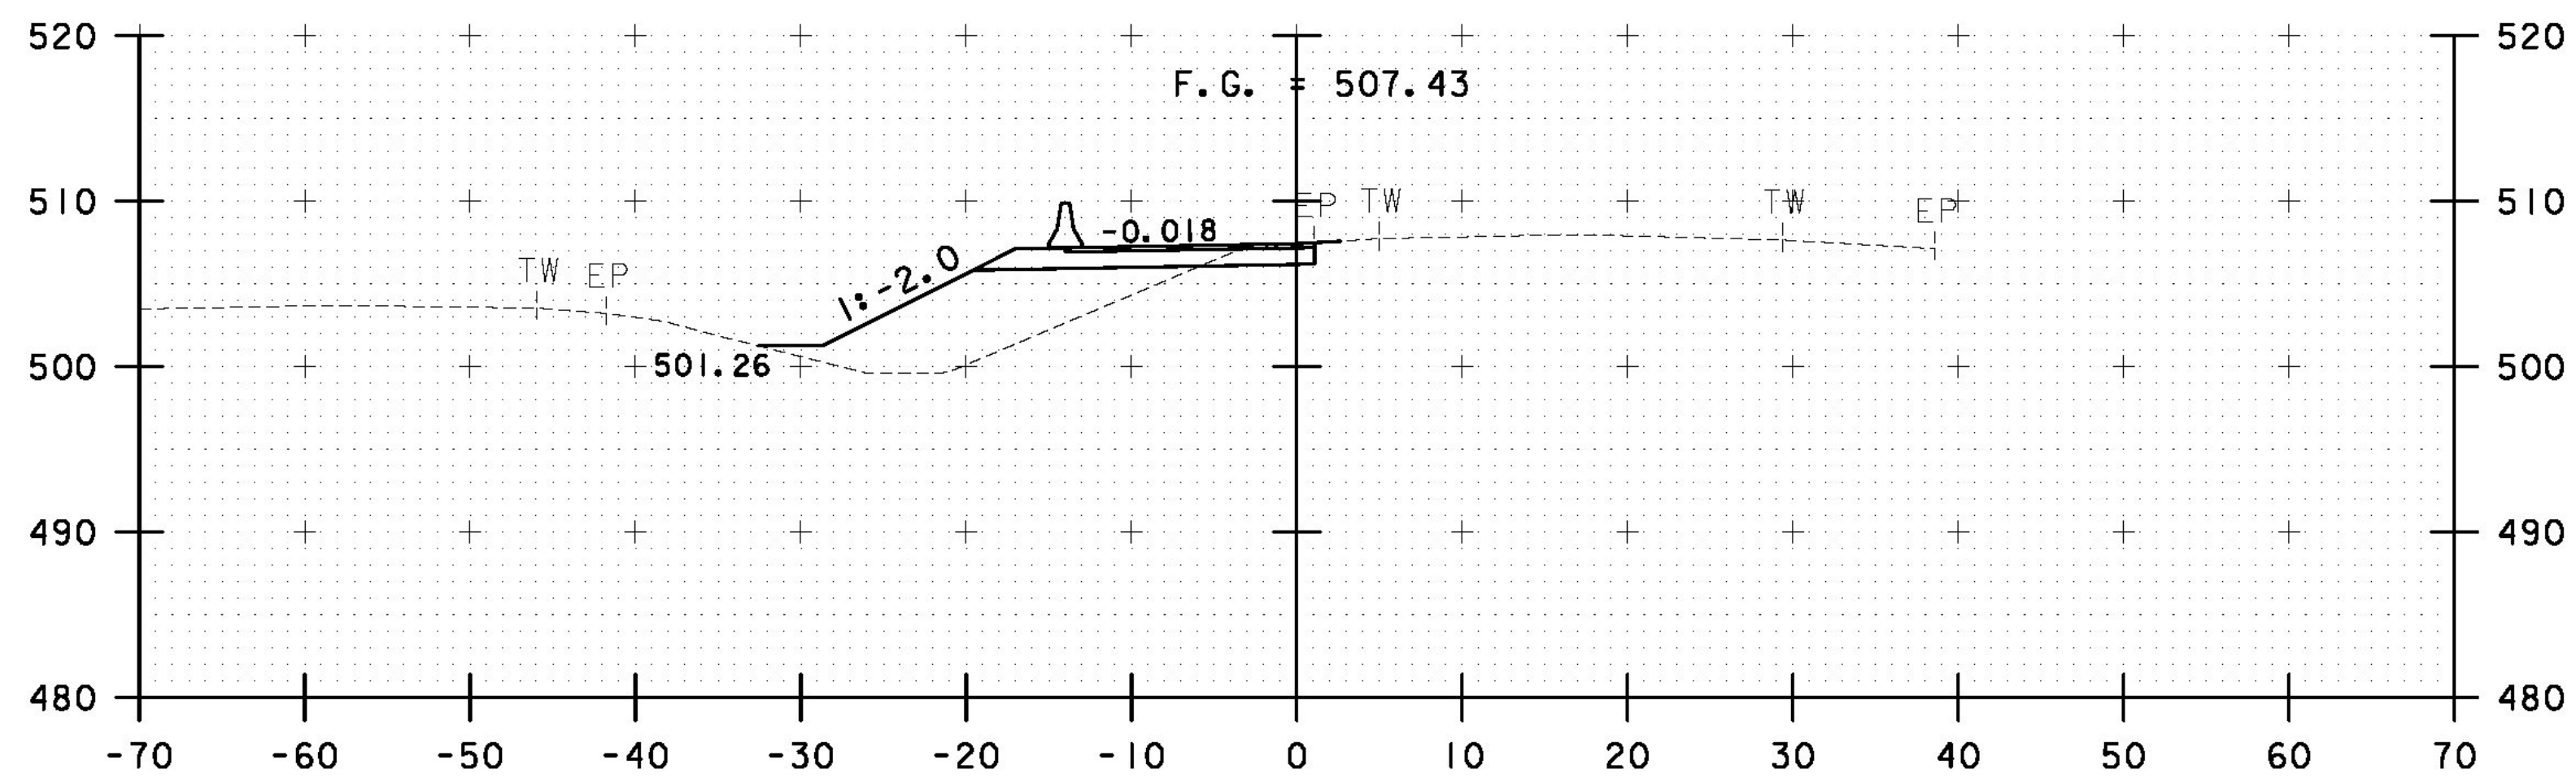

2005+00

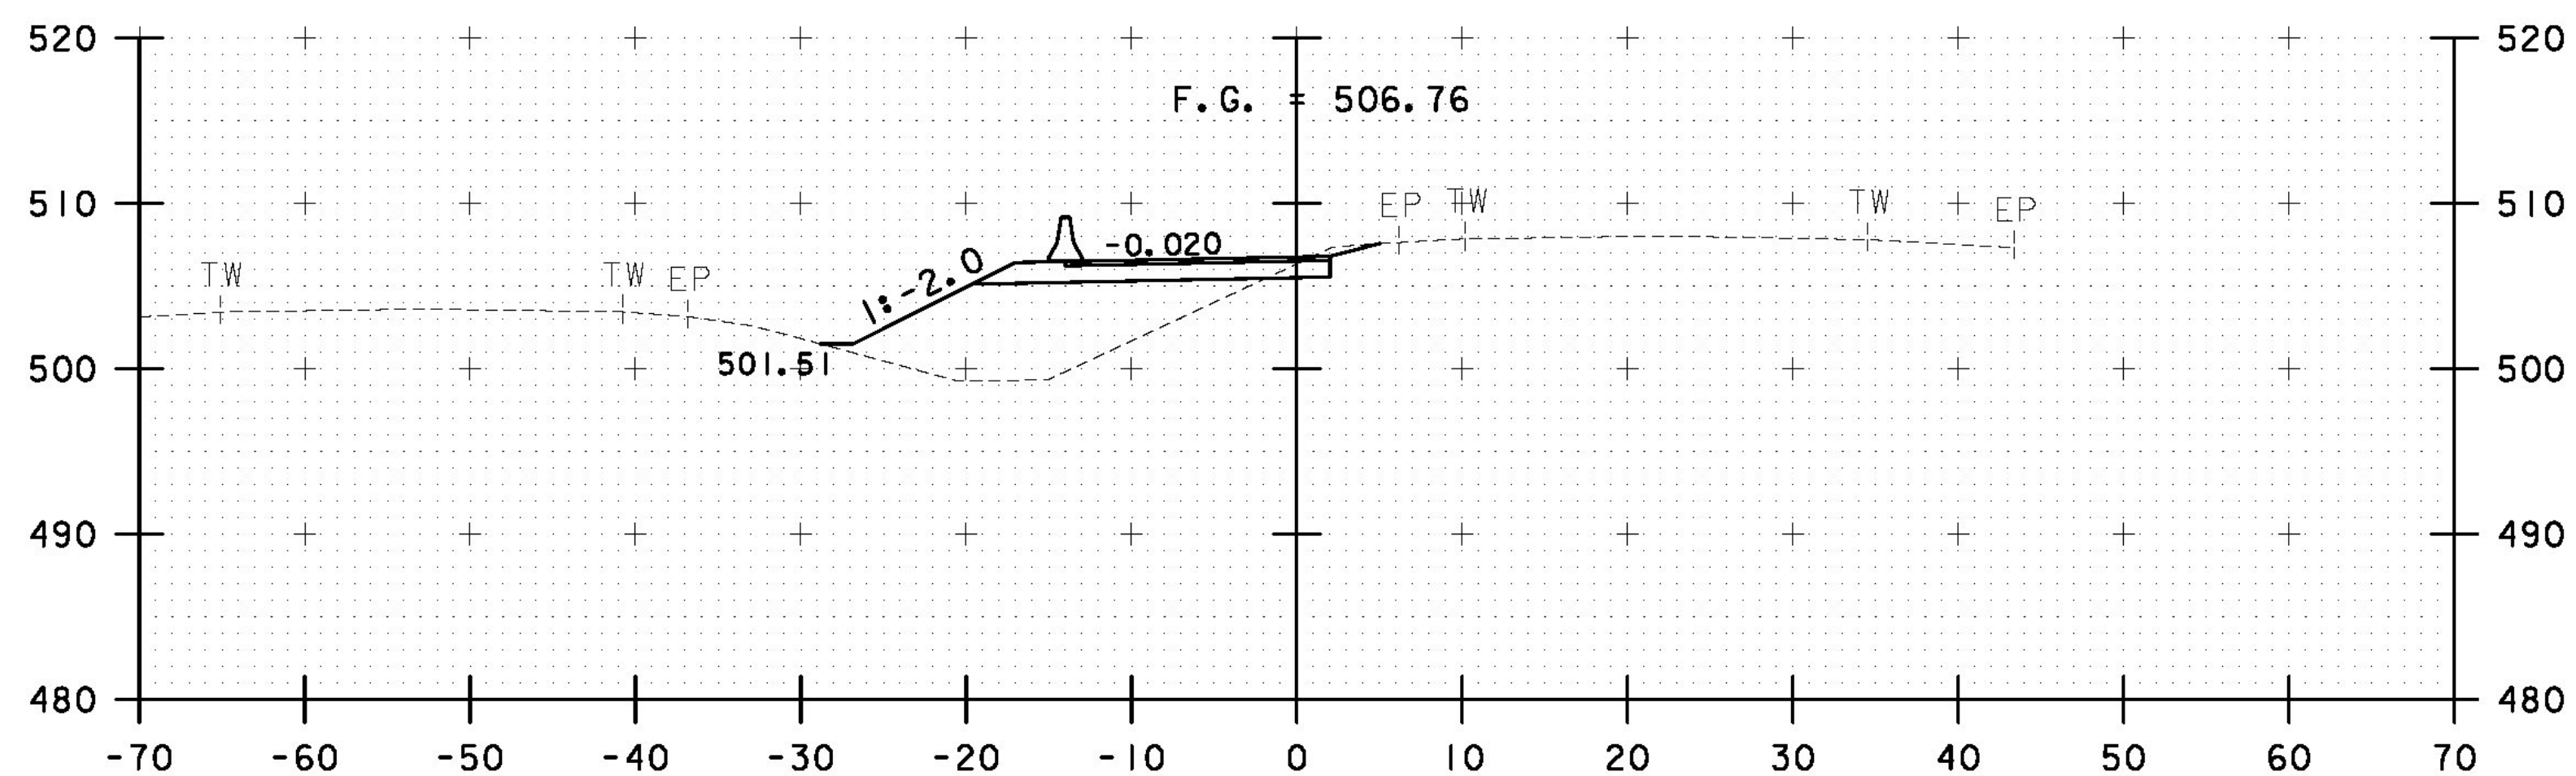


2004+50

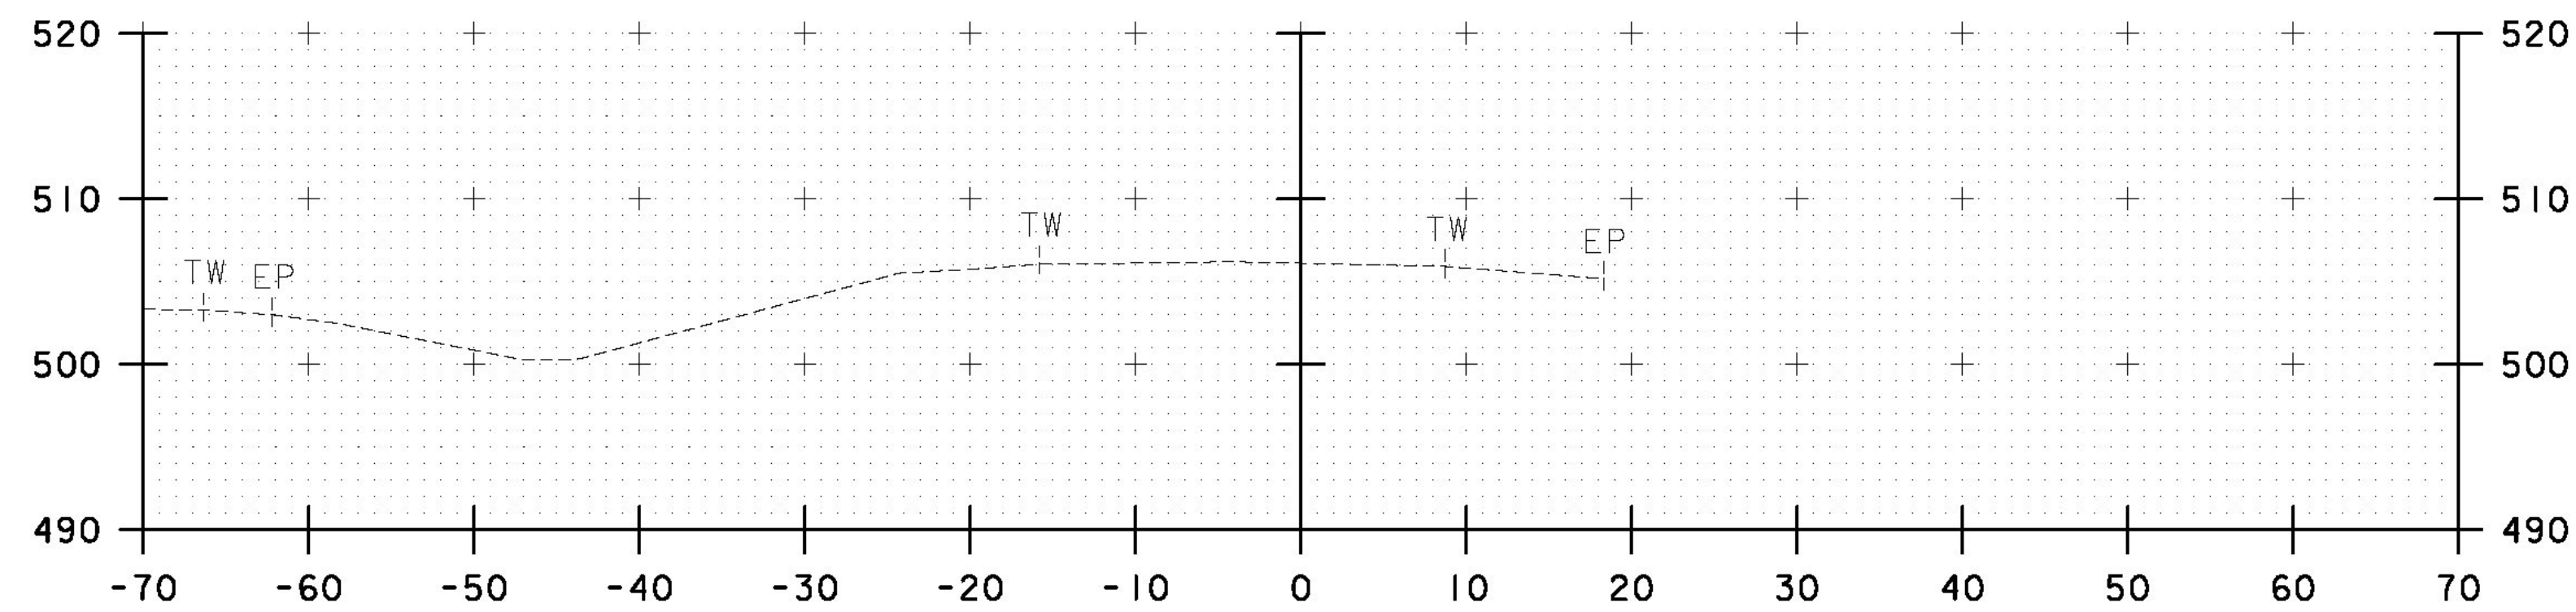


2007+00


MATCH EXISTING PAVEMENT 2006+75

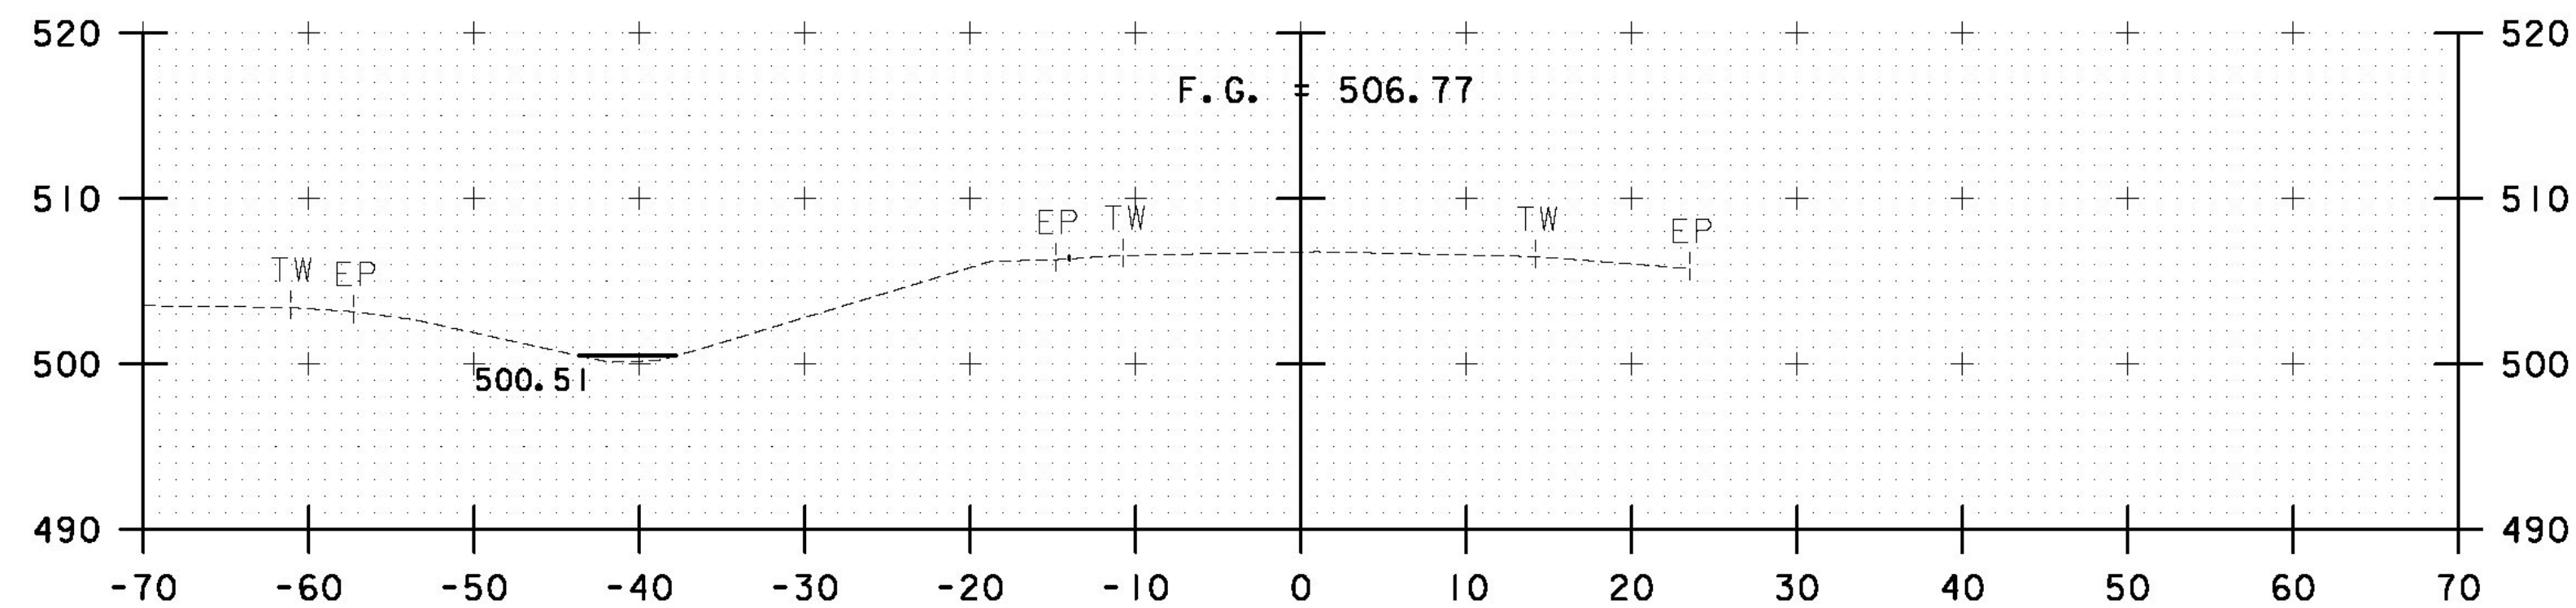

2006+50

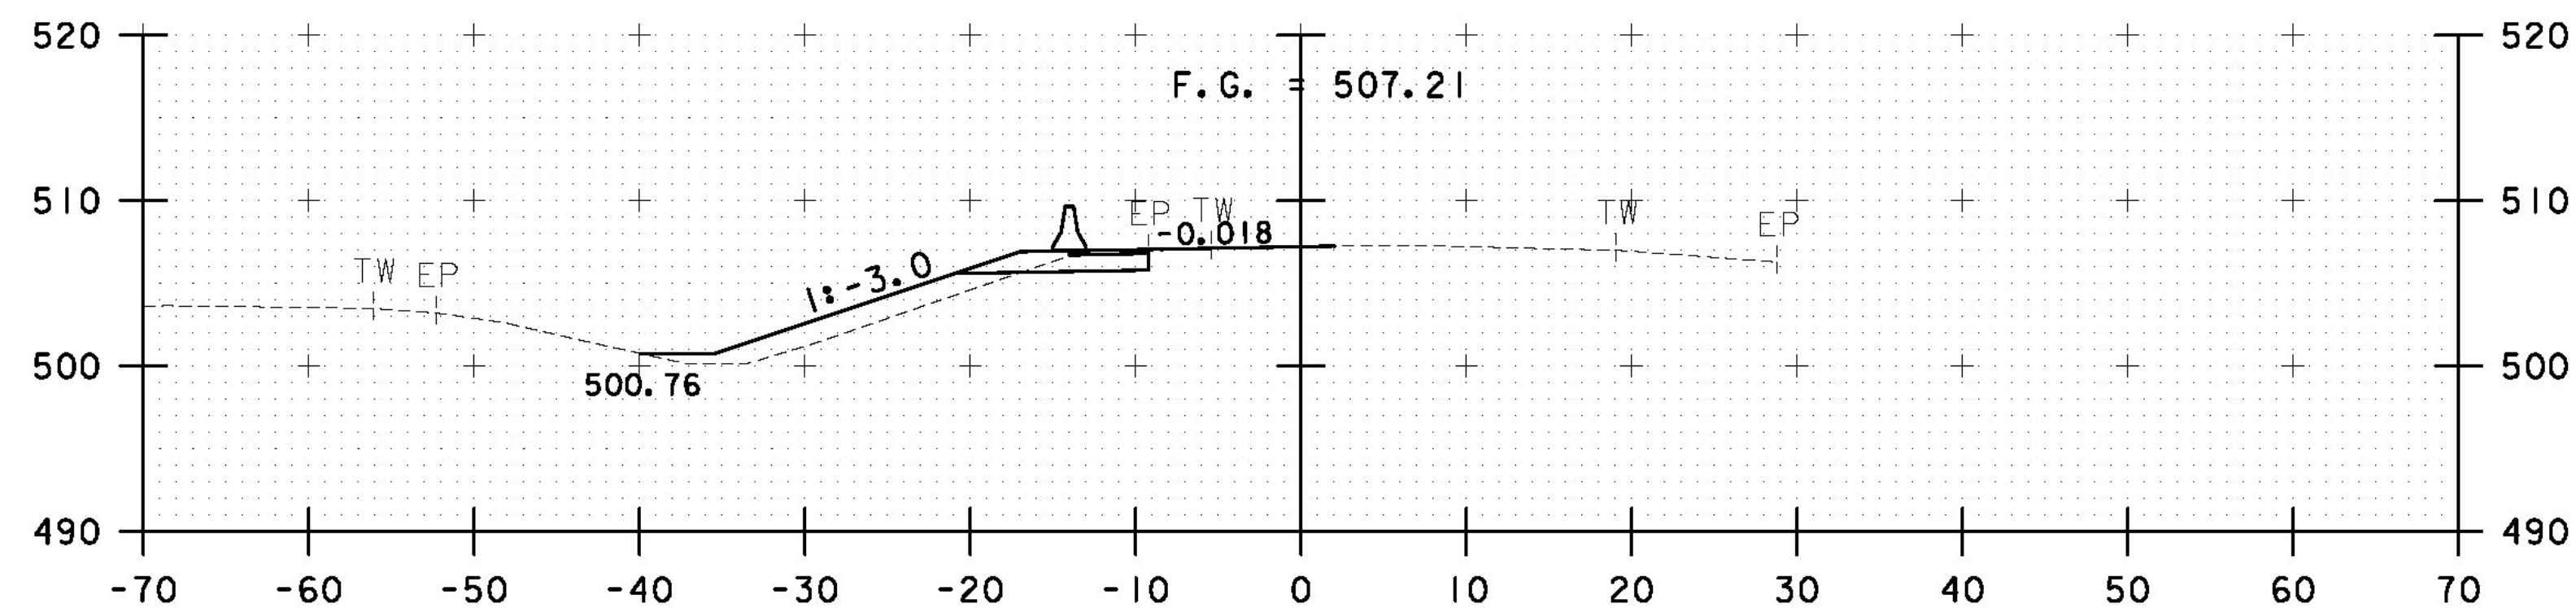

2006+00

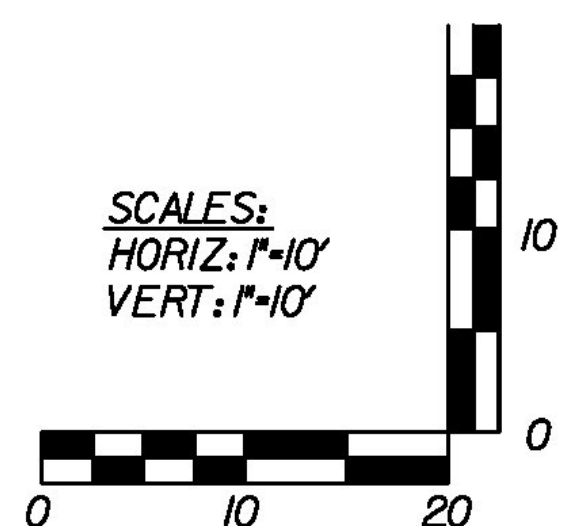

**AS BUILT
RECORD PLANS**

RFC PLANS - WORK PACKAGE #10
SOUTHBOUND APPROACH
MARCH 1, 2012

BECK & BELLUCCI, INC. TYLIN INTERNATIONAL

STA. 2004+50 TO STA. 2007+00

PROJECT NAME: BRATTLEBORO

PROJECT NUMBER: IM_091-1(50)

FILE NAME: HW-100-SC0-900.dgn PLOT DATE: 3/1/2012

PROJECT LEADER: Phillip E. Kendall P.E. DRAWN BY: A. Greenlaw

DESIGNED BY: Phillip E. Kendall II, P.E. CHECKED BY: D. BRYANT P.E.

SOUTHBOUND CROSSOVER CROSS SECTIONS SHEET HW-100-SC0-907