




2008+25

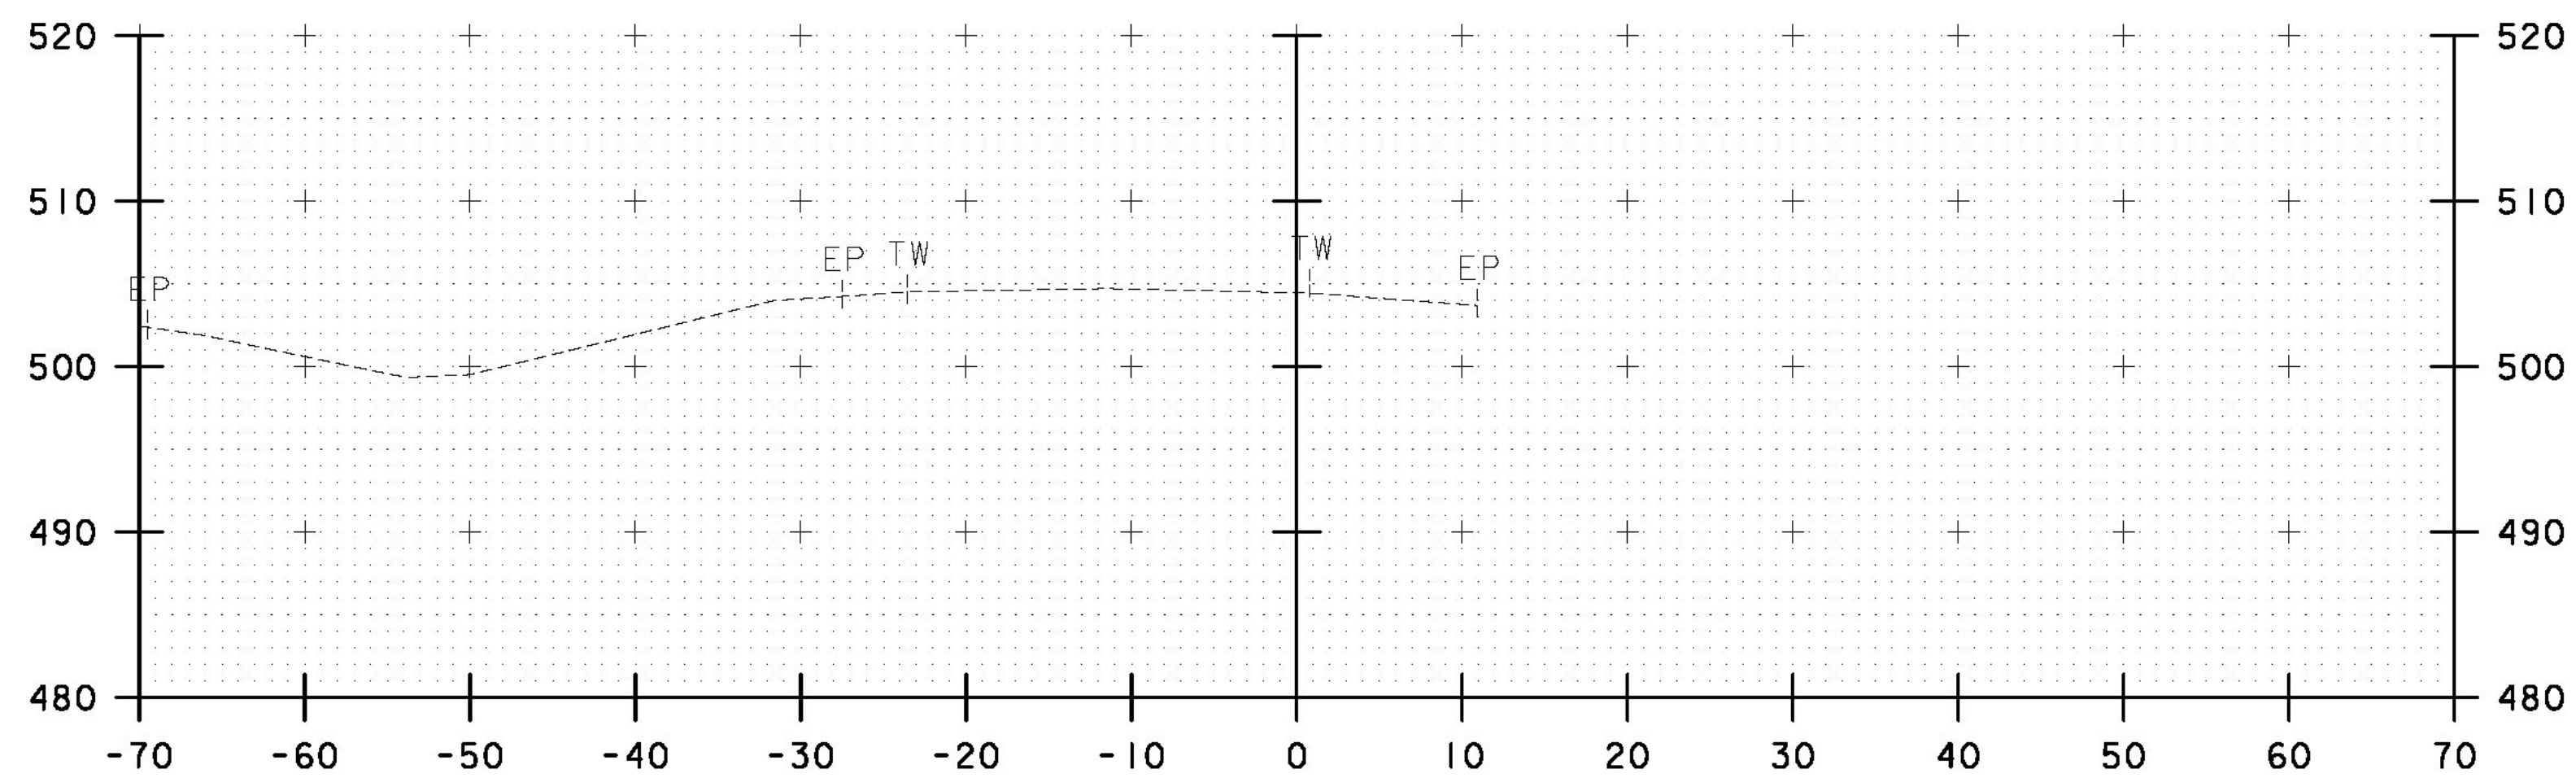

2008+00

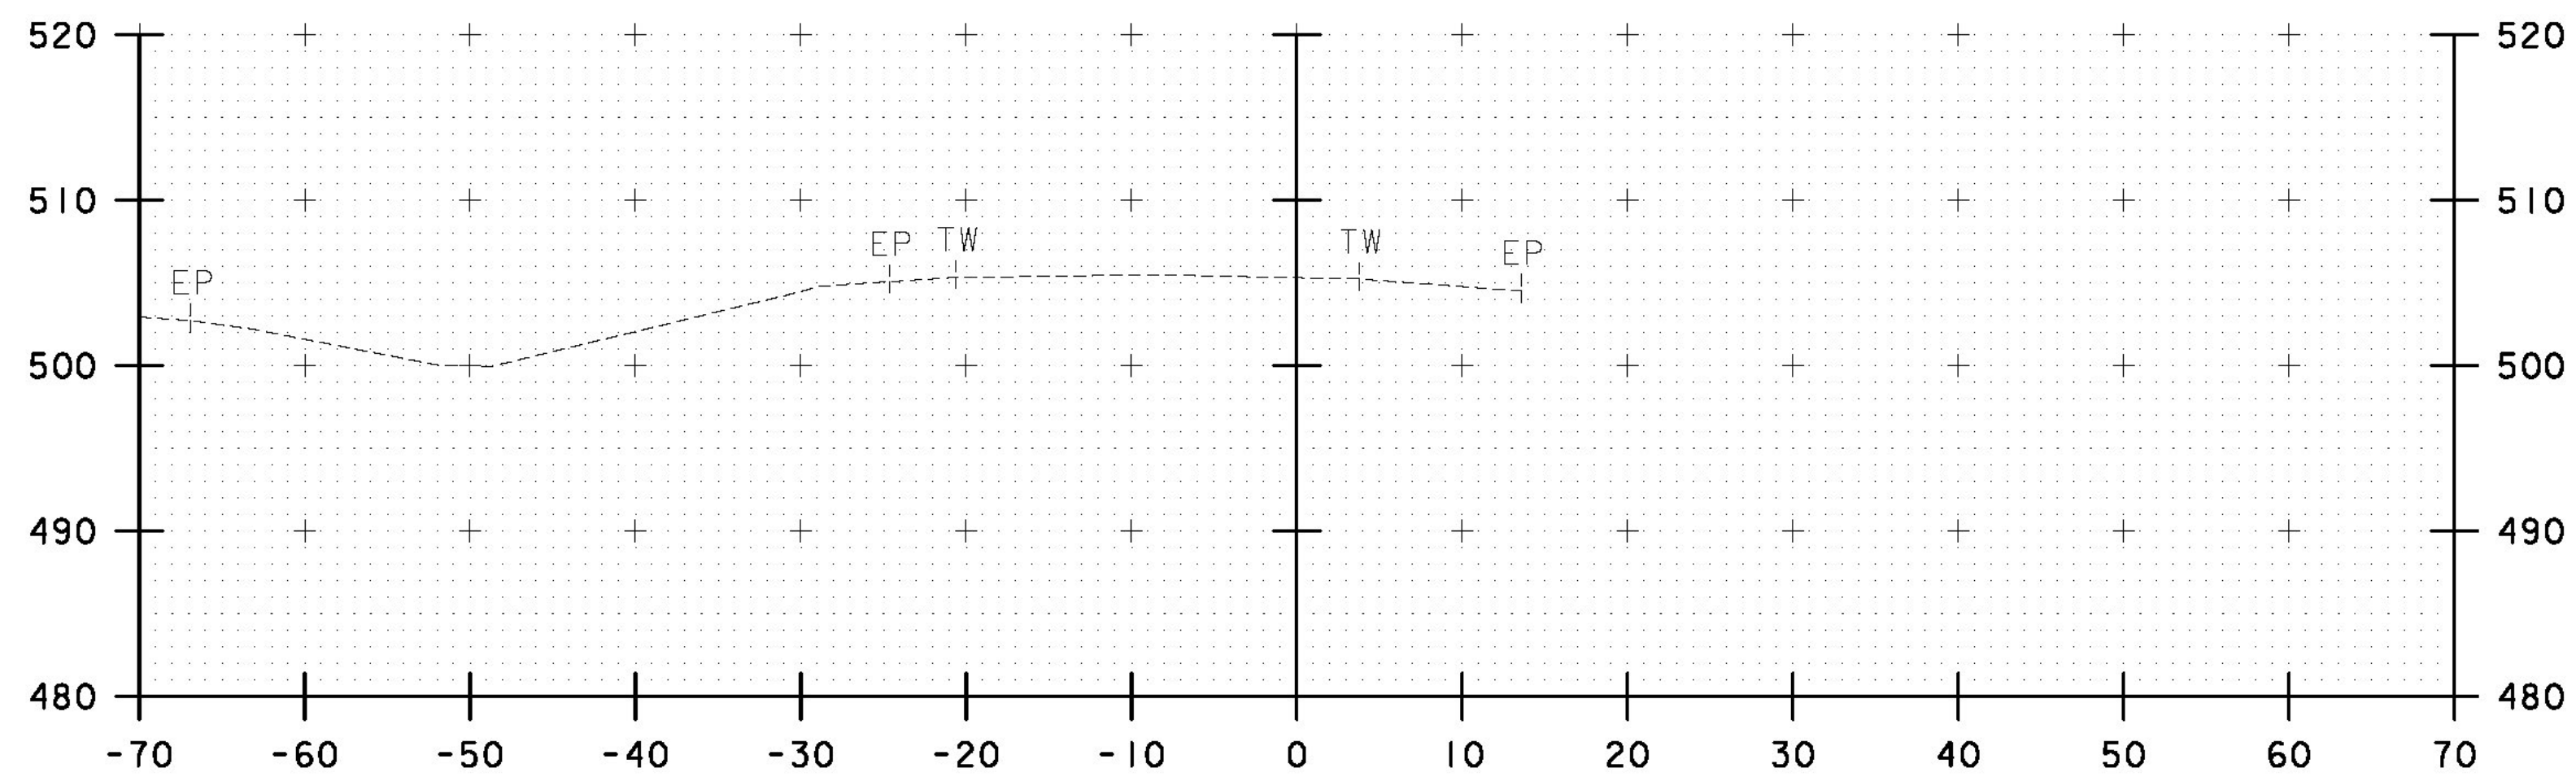

2007+50

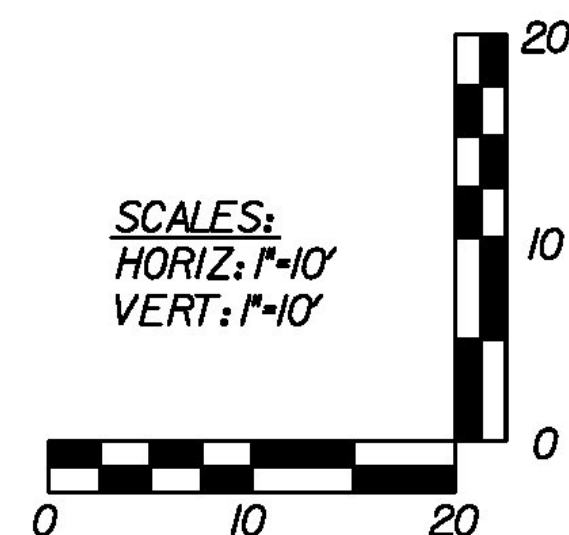

**AS BUILT  
RECORD PLANS**

RFC PLANS - WORK PACKAGE #10  
SOUTHBOUND APPROACH  
MARCH 1, 2012

STA. 2007+50 TO STA. 2008+25

PROJECT NAME: BRATTLEBORO

PROJECT NUMBER: 1M\_091-1(50)

**BECK & BELLUCCI, INC.** **TYLIN INTERNATIONAL**

FILE NAME: HW-100-SC0-900.dgn PLOT DATE: 3/1/2012

PROJECT LEADER: Phillip E. Kendall P.E. DRAWN BY: A. Greenlaw

DESIGNED BY: Phillip E. Kendall II, P.E. CHECKED BY: D. BRYANT P.E.

SOUTHBOUND CROSSOVER CROSS SECTIONS SHEET HW-100-SC0-908