


**AS BUILT  
RECORD PLANS**

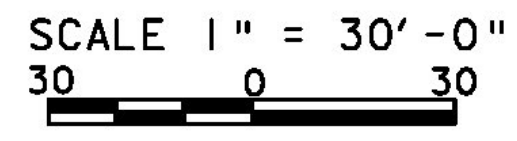

RFC PLANS - WORK PACKAGE 00  
WINTER TCP  
DECEMBER 12, 2011

BECK & BELLUCCI, INC. TYLIN INTERNATIONAL

PROJECT NAME: BRATTLEBORO  
PROJECT NUMBER: IM 091-(K50)

FILE NAME: HW-TCP-DGN-507.dgn  
PROJECT LEADER: Phillip E. Kendall II, P.E.  
DESIGNED BY: Phillip E. Kendall II, P.E.  
PHASE I TRAFFIC CONTROL PLANS

PLOT DATE: 12/12/2011  
DRAWN BY: A.R. Greenlaw  
CHECKED BY: D. Bryant P.E.  
SHEET HW-TCP-DGN-507