


**AS BUILT
RECORD PLANS**

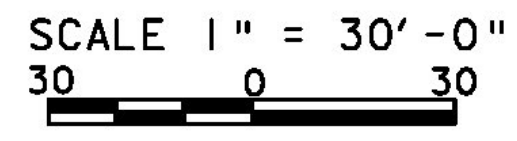

RFC PLANS - WORK PACKAGE 00
2011-2012 WINTER TCP PACKAGE
DECEMBER 1, 2011

BECK & BELLUCCI, INC. TYLIN INTERNATIONAL

PROJECT NAME: BRATTLEBORO
PROJECT NUMBER: IM 091-(K50)

FILE NAME: HW-TCP-DGN-517.dgn
PROJECT LEADER: Phillip E. Kendall II, P.E.
DESIGNED BY: Phillip E. Kendall II, P.E.
PHASE 3 TRAFFIC CONTROL PLANS

PLOT DATE: 12/5/2011
DRAWN BY: A.R. Greenlaw
CHECKED BY: D. Bryant P.E.
SHEET HW-TCP-DGN-517