


**AS BUILT
RECORD PLANS**

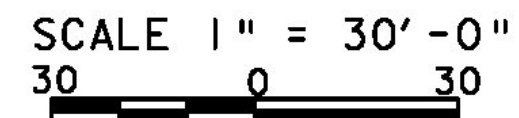

RFC PLANS - WORK PACKAGE 00
2011-2012 WINTER TCP PACKAGE
DECEMBER 1, 2011

BECK & BELLUCCI, INC.

TYLIN INTERNATIONAL

PROJECT NAME: BRATTLEBORO

PROJECT NUMBER: IM 091-(50)

FILE NAME: HW-TCP-DGN-519.dgn

PROJECT LEADER: Phillip E. Kendall II, P.E.

DESIGNED BY: Phillip E. Kendall II, P.E.

PHASE 3 TRAFFIC CONTROL PLANS

PLOT DATE: 12/5/2011

DRAWN BY: A. R. Greenlaw

CHECKED BY: D. Bryant P.E.

SHEET HW-TCP-DGN-519