
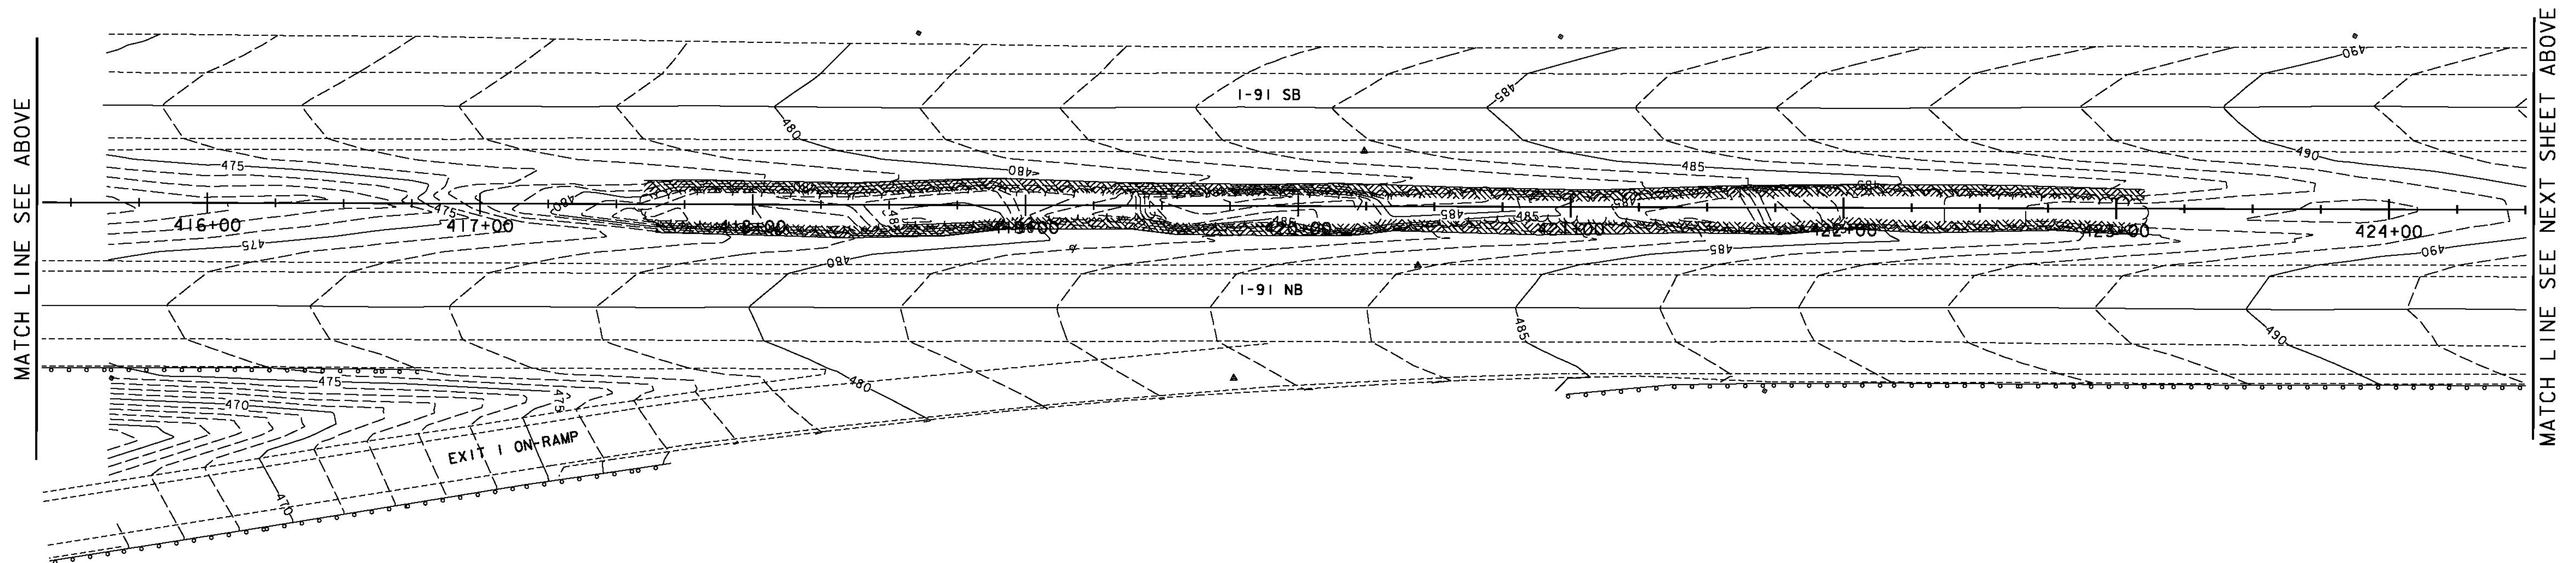
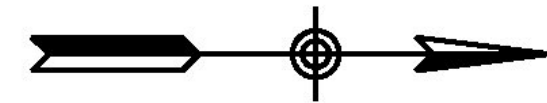


NOTES:
 1. THIS EPSC PLAN IS INTENDED TO BE A DYNAMIC PLAN. AS CONDITIONS CHANGE, THE EPSC PLAN WILL BE AMENDED AS NECESSARY AS EROSION CONTROL INSPECTORS DICTATE.

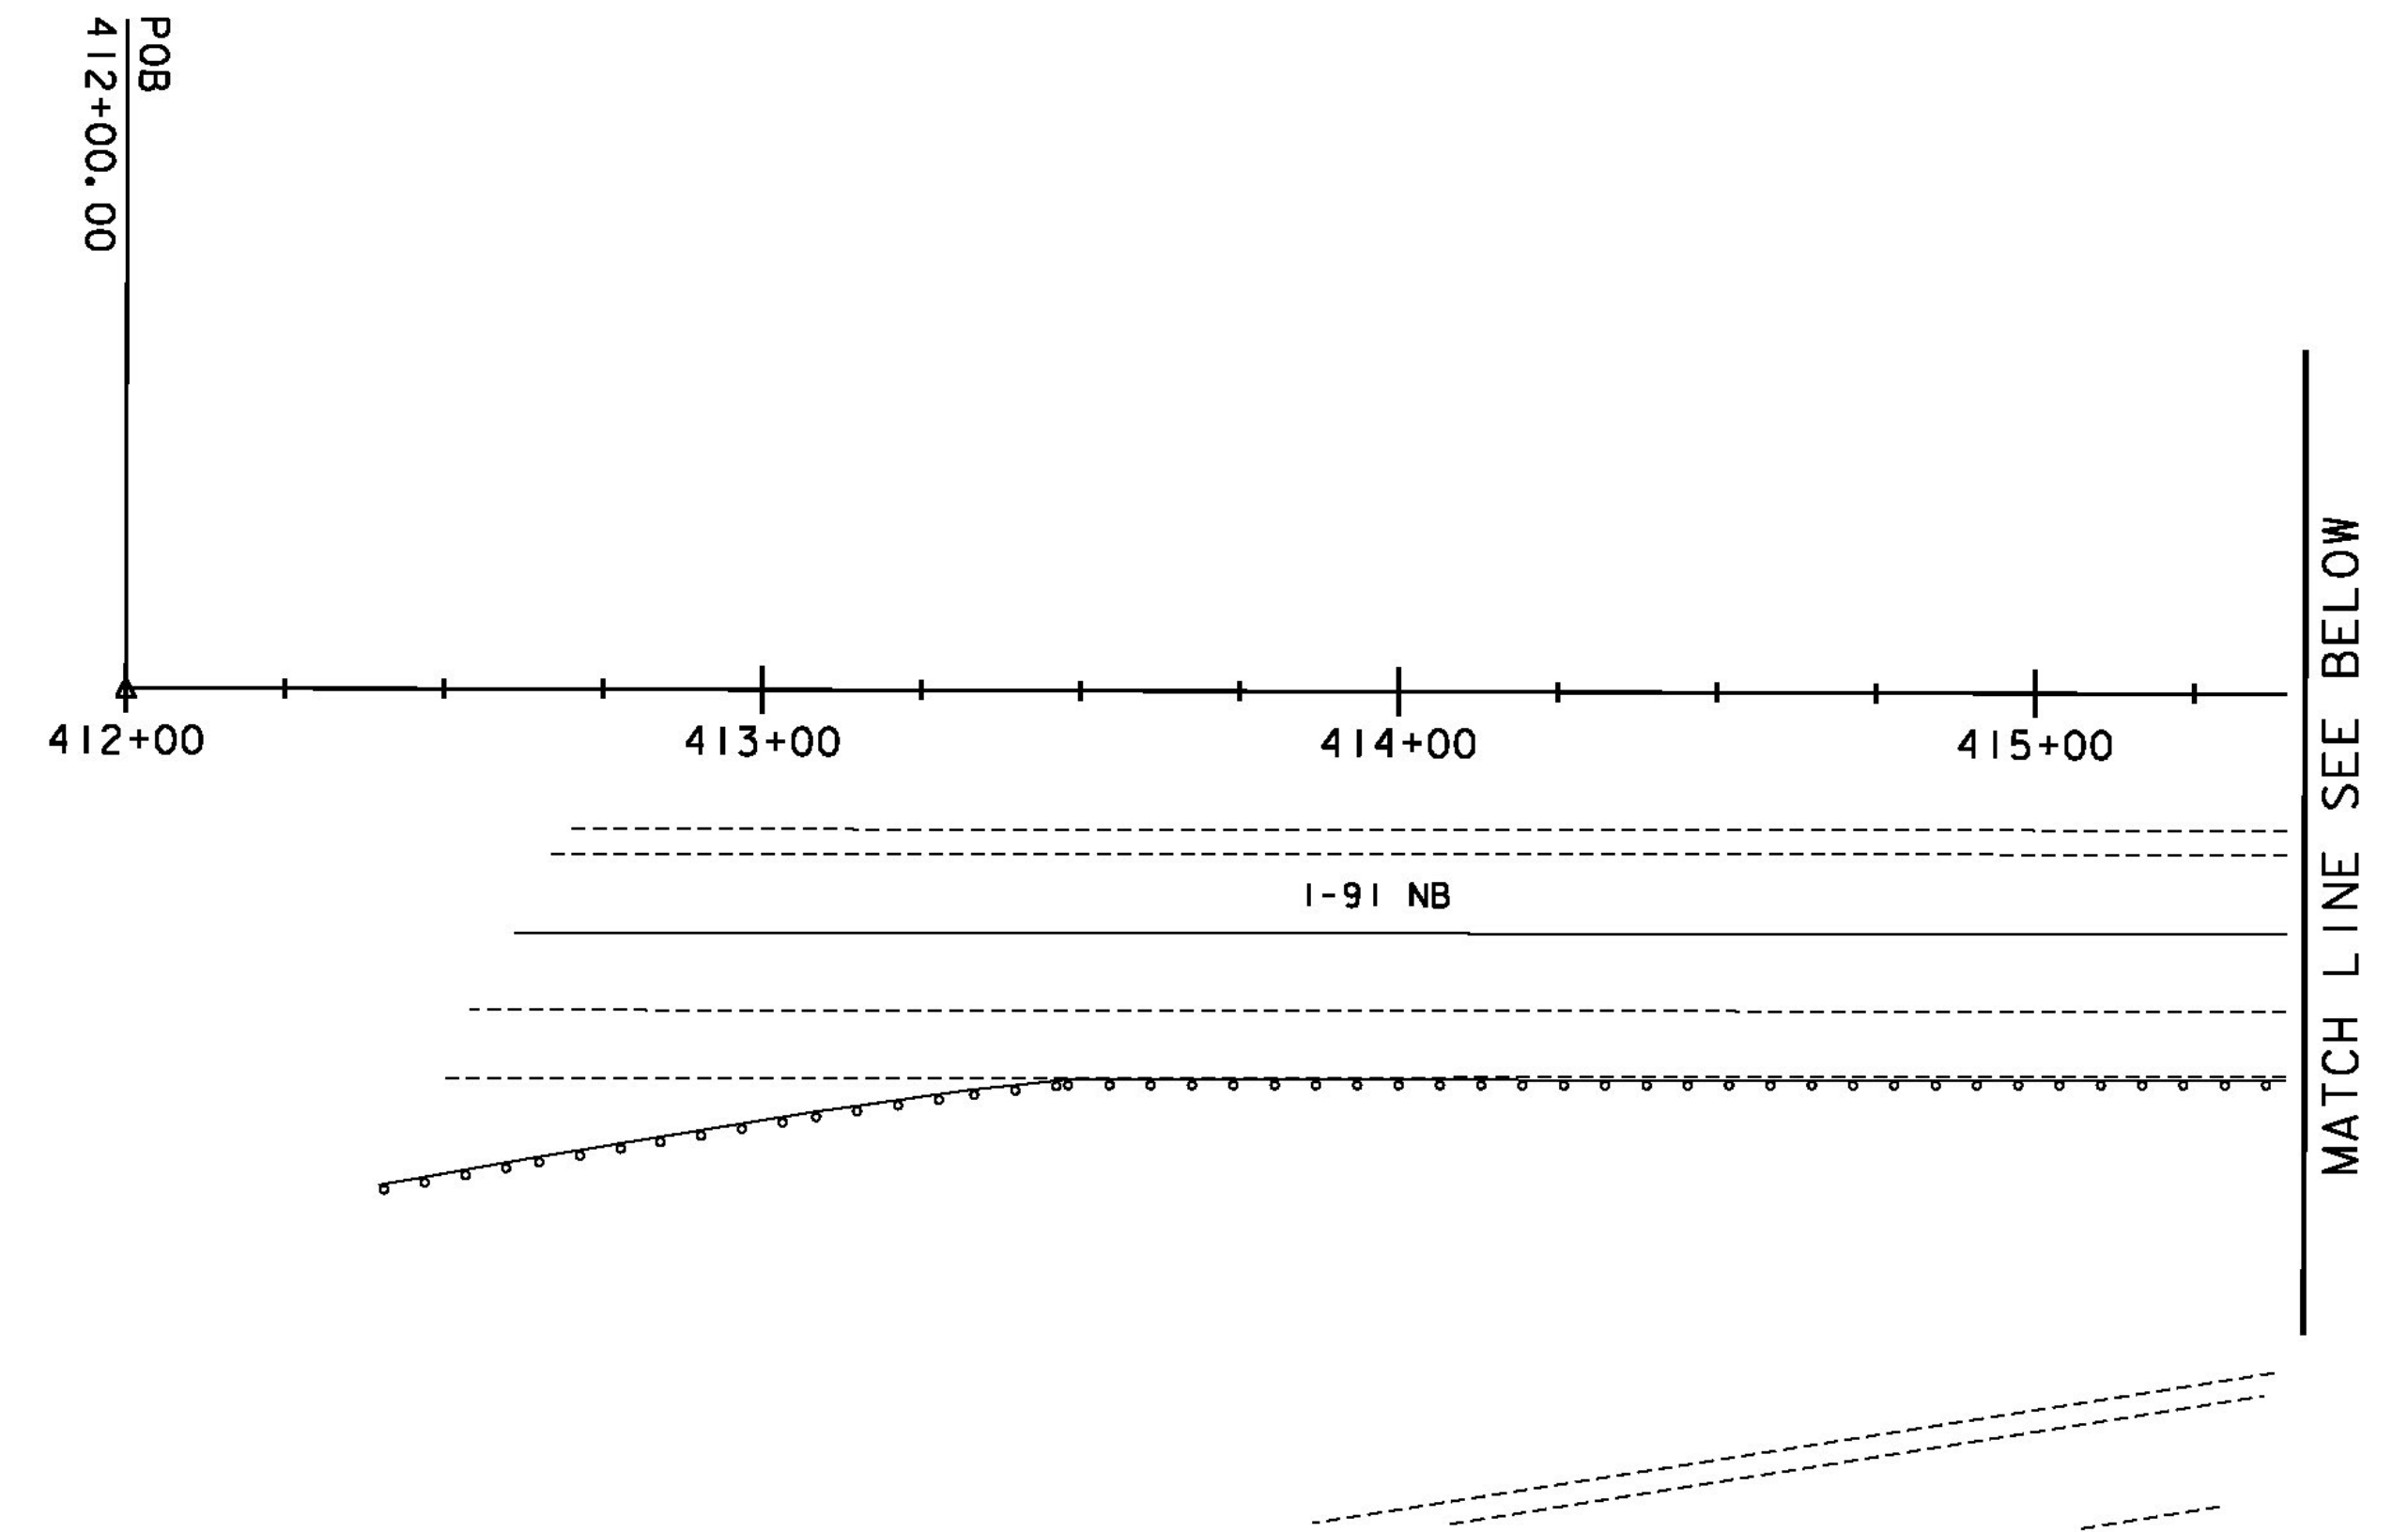

**AS BUILT
 RECORD PLANS**

SCALE 1" = 30'-0"
 30 0 30

**RFC WORK PACKAGE #1C
 03/18/2011**

BECK & BELLUCCI, INC.

TYLIN INTERNATIONAL

PROJECT NAME: I-91 BRIDGE IMPROVEMENTS	
PROJECT NUMBER: BRATTLEBORO AC IM 091-I(50)	
FILE NAME: EPSC I.DGN	PLOT DATE: 3/18/2011
PROJECT LEADER: Brian W. Clogston P.E.	DRAWN BY: Brian Waehler
DESIGNED BY: Brian Waehler P.E.	CHECKED BY: John St. John
EPSC PLAN PHASE I - EXISTING CONDITIONS	SHEET 1 OF 20