
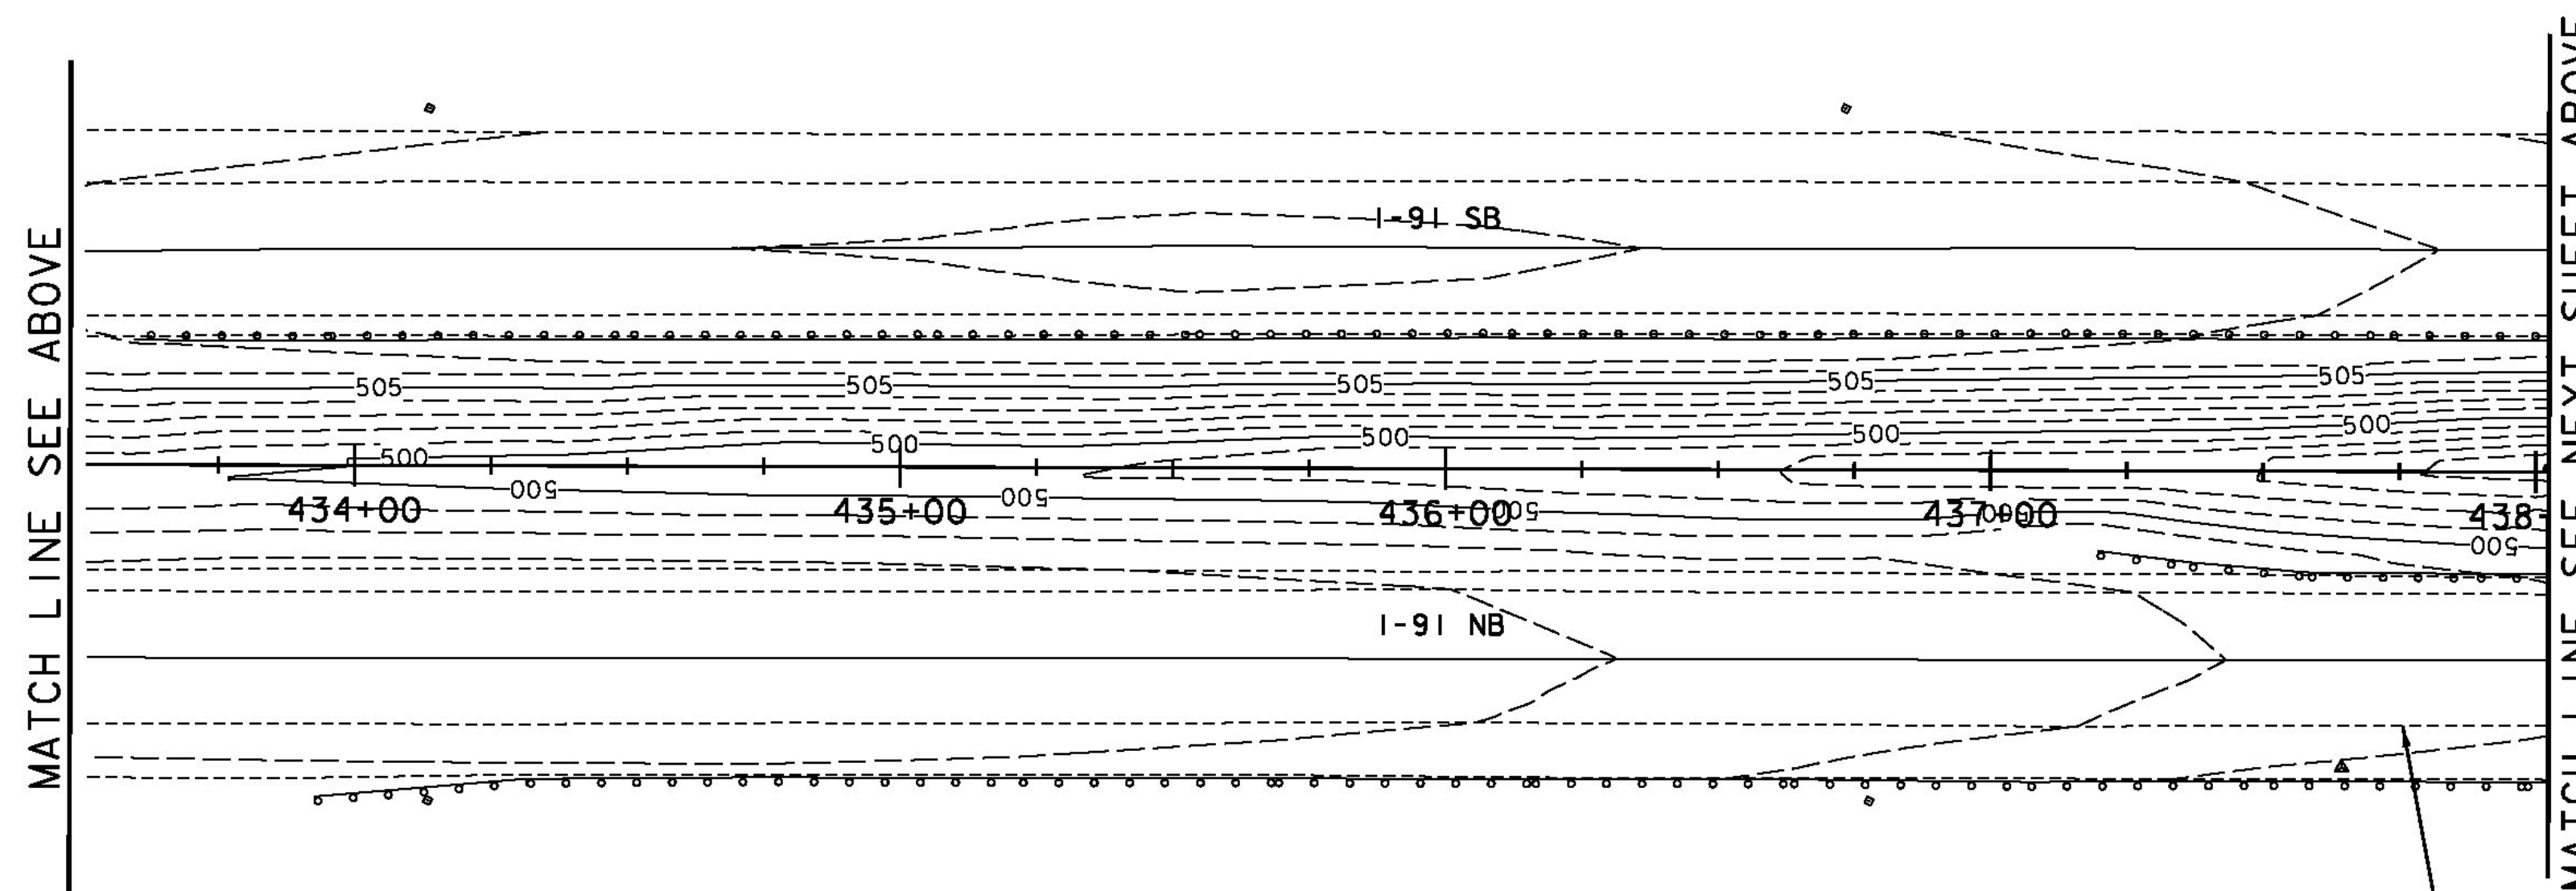
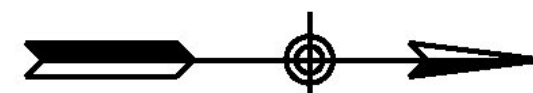
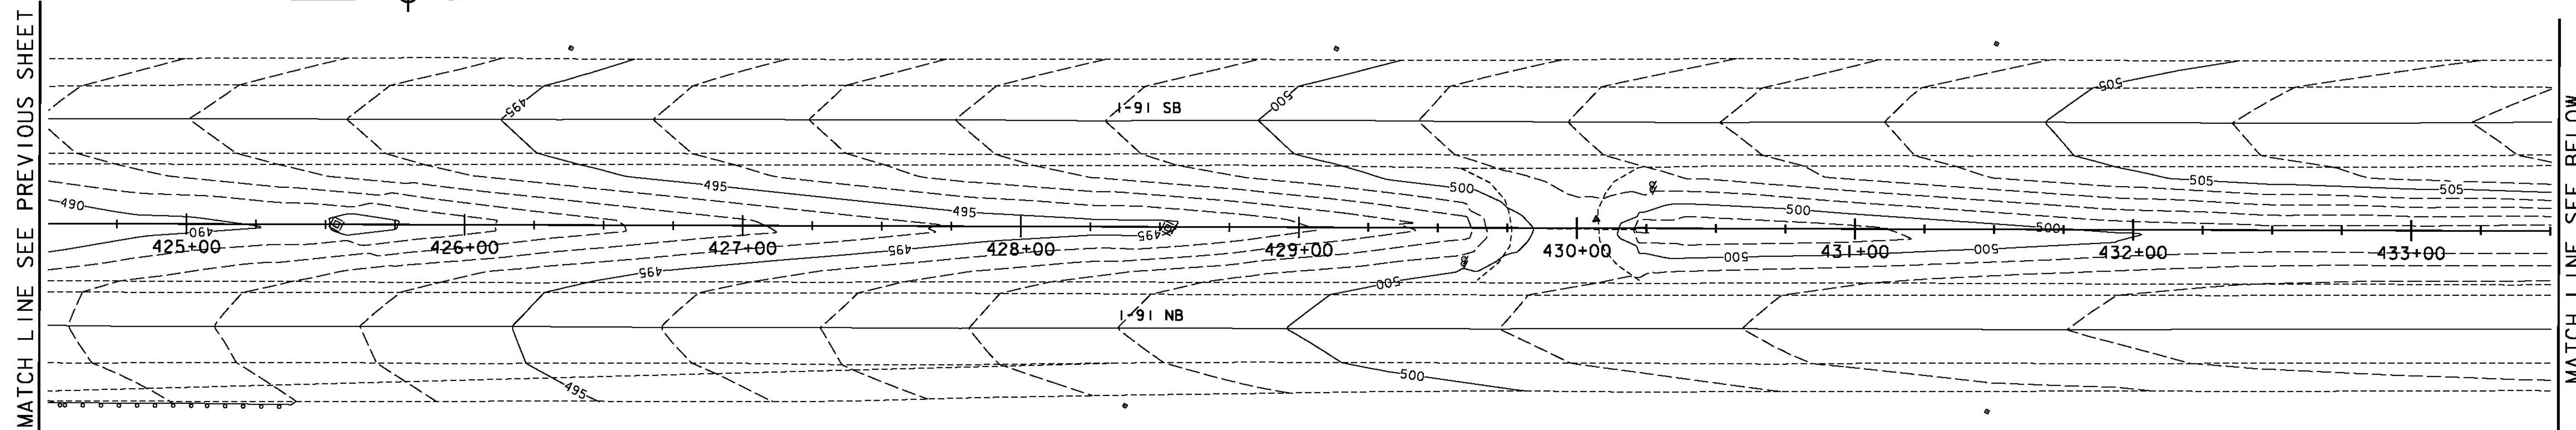


NOTES:
 1. THIS EPSC PLAN IS INTENDED TO BE A DYNAMIC PLAN. AS CONDITIONS CHANGE, THE EPSC PLAN WILL BE AMENDED AS NECESSARY AS EROSION CONTROL INSPECTORS DICTATE.

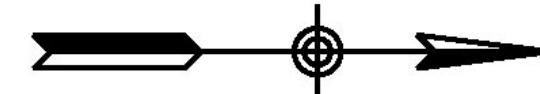

REFER TO SHEET 3 FOR BRIDGE 5N EXISTING CONDITIONS

**AS BUILT
 RECORD PLANS**

SCALE 1" = 30' - 0"
 30 0 30

RFC WORK PACKAGE #1C
 03/18/2011

BECK & BELLUCCI, INC.	TYLIN INTERNATIONAL	PROJECT NAME: I-91 BRIDGE IMPROVEMENTS	PLOT DATE: 3/18/2011
		PROJECT NUMBER: BRATTLEBORO AC IM 091-(150)	DRAWN BY: Brian Waehler
		FILE NAME: EPSC 2.DGN	CHECKED BY: John St. John
		PROJECT LEADER: Brian W. Clogston P.E.	SHEET 2 OF 20
		DESIGNED BY: Brian Waehler P.E.	
		EPSC PLAN PHASE 1 - EXISTING CONDITIONS	