



NOTES:
 1. THIS EPSC PLAN IS INTENDED TO BE A DYNAMIC PLAN. AS CONDITIONS CHANGE, THE EPSC PLAN WILL BE AMENDED AS NECESSARY AS EROSION CONTROL INSPECTORS DICTATE.

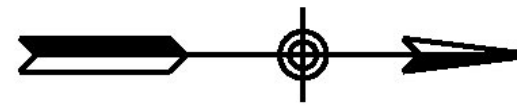

REFER TO SHEET 7 FOR EXISTING CONDITIONS IN AREA OF PROPOSED CROSSOVER

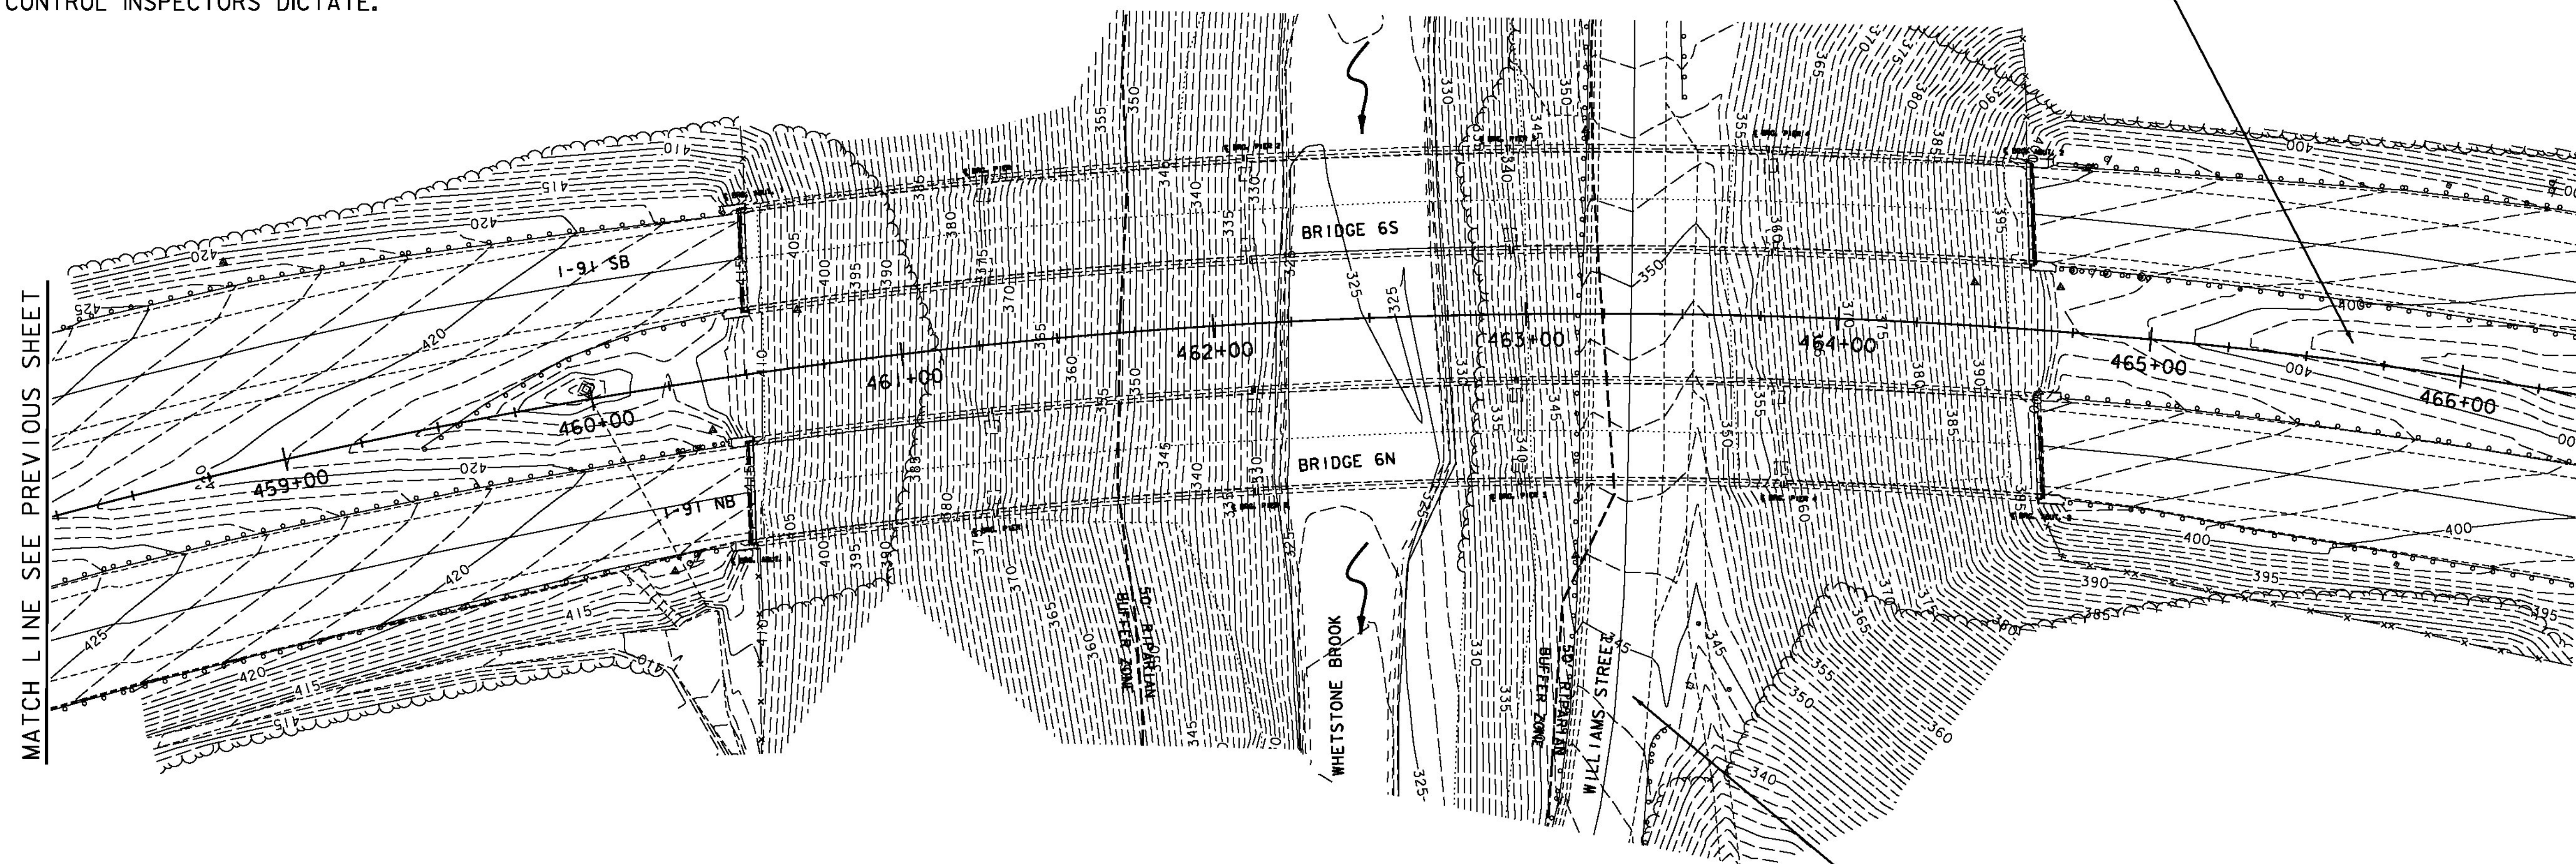

REFER TO SHEET 6 FOR EXISTING CONDITIONS IN AREA OF PROPOSED WILLIAMS STREET DETOUR

**AS BUILT
 RECORD PLANS**

**RFC WORK PACKAGE #1C
 03/18/2011**



BECK & BELLUCCI, INC. **TYLIN INTERNATIONAL**

PROJECT NAME: I-91 BRIDGE IMPROVEMENTS	
PROJECT NUMBER: BRATTLEBORO AC IM 091-(150)	
FILE NAME: EPSC 5.DGN	PLOT DATE: 3/18/2011
PROJECT LEADER: Brian W. Clogston P.E.	DRAWN BY: Brian Waehler
DESIGNED BY: Brian Waehler P.E.	CHECKED BY: John St. John
EPSC PLAN PHASE I - EXISTING CONDITIONS SHEET 5 OF 20	