


**NOTES:**  
 1. THIS EPSC PLAN IS INTENDED TO BE A DYNAMIC PLAN. AS CONDITIONS CHANGE, THE EPSC PLAN WILL BE AMENDED AS NECESSARY AS EROSION CONTROL INSPECTORS DICTATE.

REFER TO SHEET 7 FOR EXISTING CONDITIONS IN AREA OF PROPOSED CROSSOVER

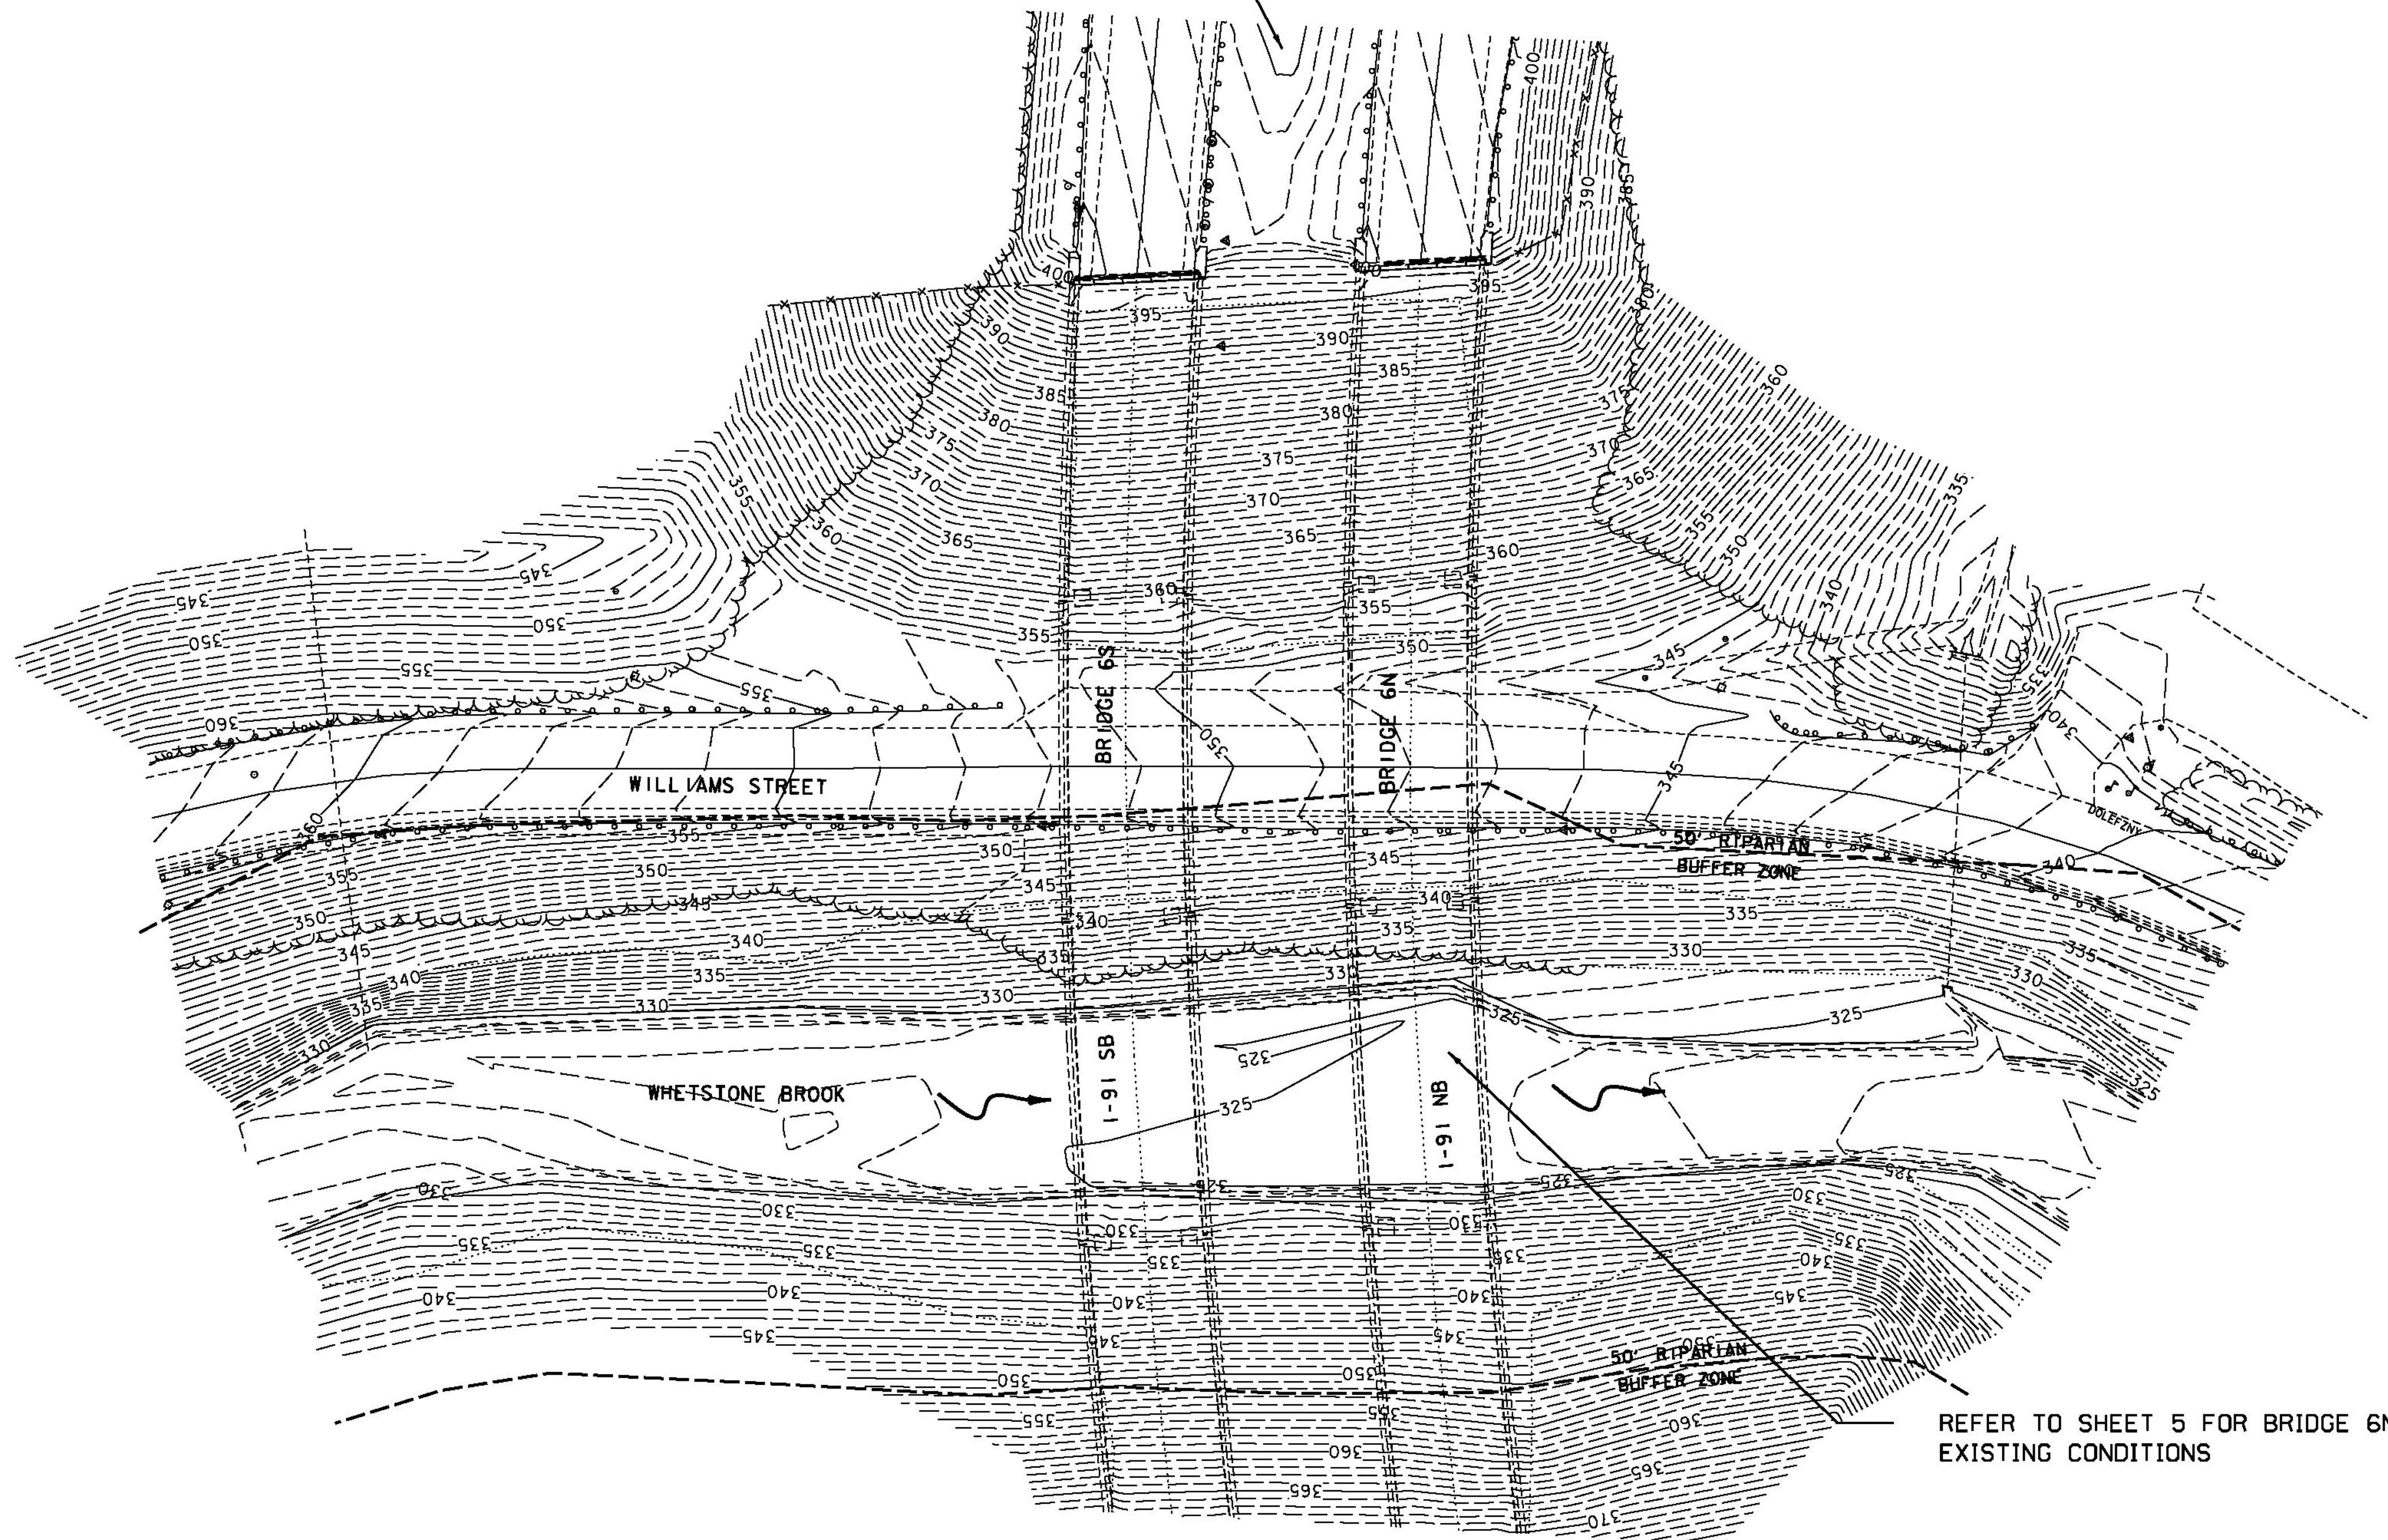

REFER TO SHEET 5 FOR BRIDGE 6N EXISTING CONDITIONS

**AS BUILT  
 RECORD PLANS**

SCALE 1" = 30'-0"  
 30 0 30

**RFC WORK PACKAGE #1C  
 03/18/2011**

**BECK & BELLUCCI, INC.**

**TYLIN INTERNATIONAL**

|   |                           |
|---|---------------------------|
| PROJECT NAME: I-91 BRIDGE IMPROVEMENTS                |                           |
| PROJECT NUMBER: BRATTLEBORO AC IM 091-(150)           |                           |
| FILE NAME: EPSC 6.DGN                                 | PLOT DATE: 3/18/2011      |
| PROJECT LEADER: Brian W. Clogston P.E.                | DRAWN BY: Brian Waehler   |
| DESIGNED BY: Brian Waehler P.E.                       | CHECKED BY: John St. John |
| EPSC PLAN PHASE I - EXISTING CONDITIONS SHEET 6 OF 20 |                           |