
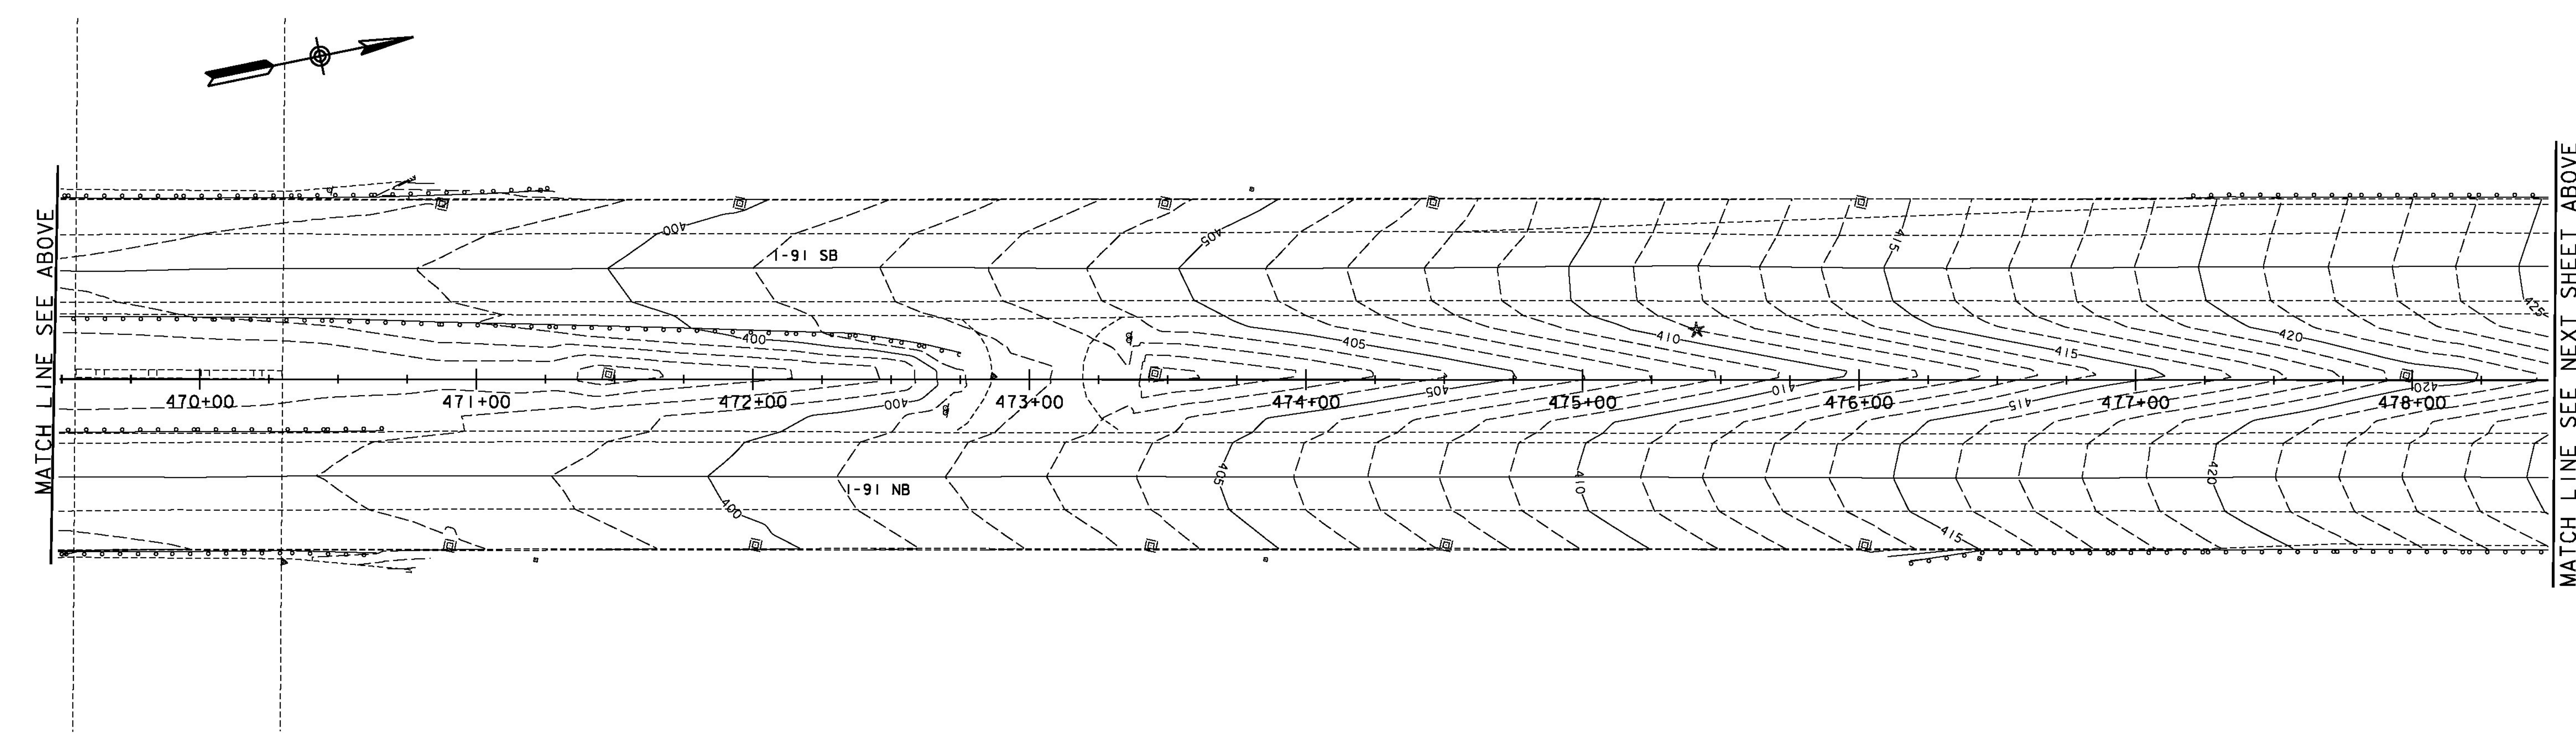


NOTES:  
 1. THIS EPSC PLAN IS INTENDED TO BE A DYNAMIC PLAN. AS CONDITIONS CHANGE, THE EPSC PLAN WILL BE AMENDED AS NECESSARY AS EROSION CONTROL INSPECTORS DICTATE.

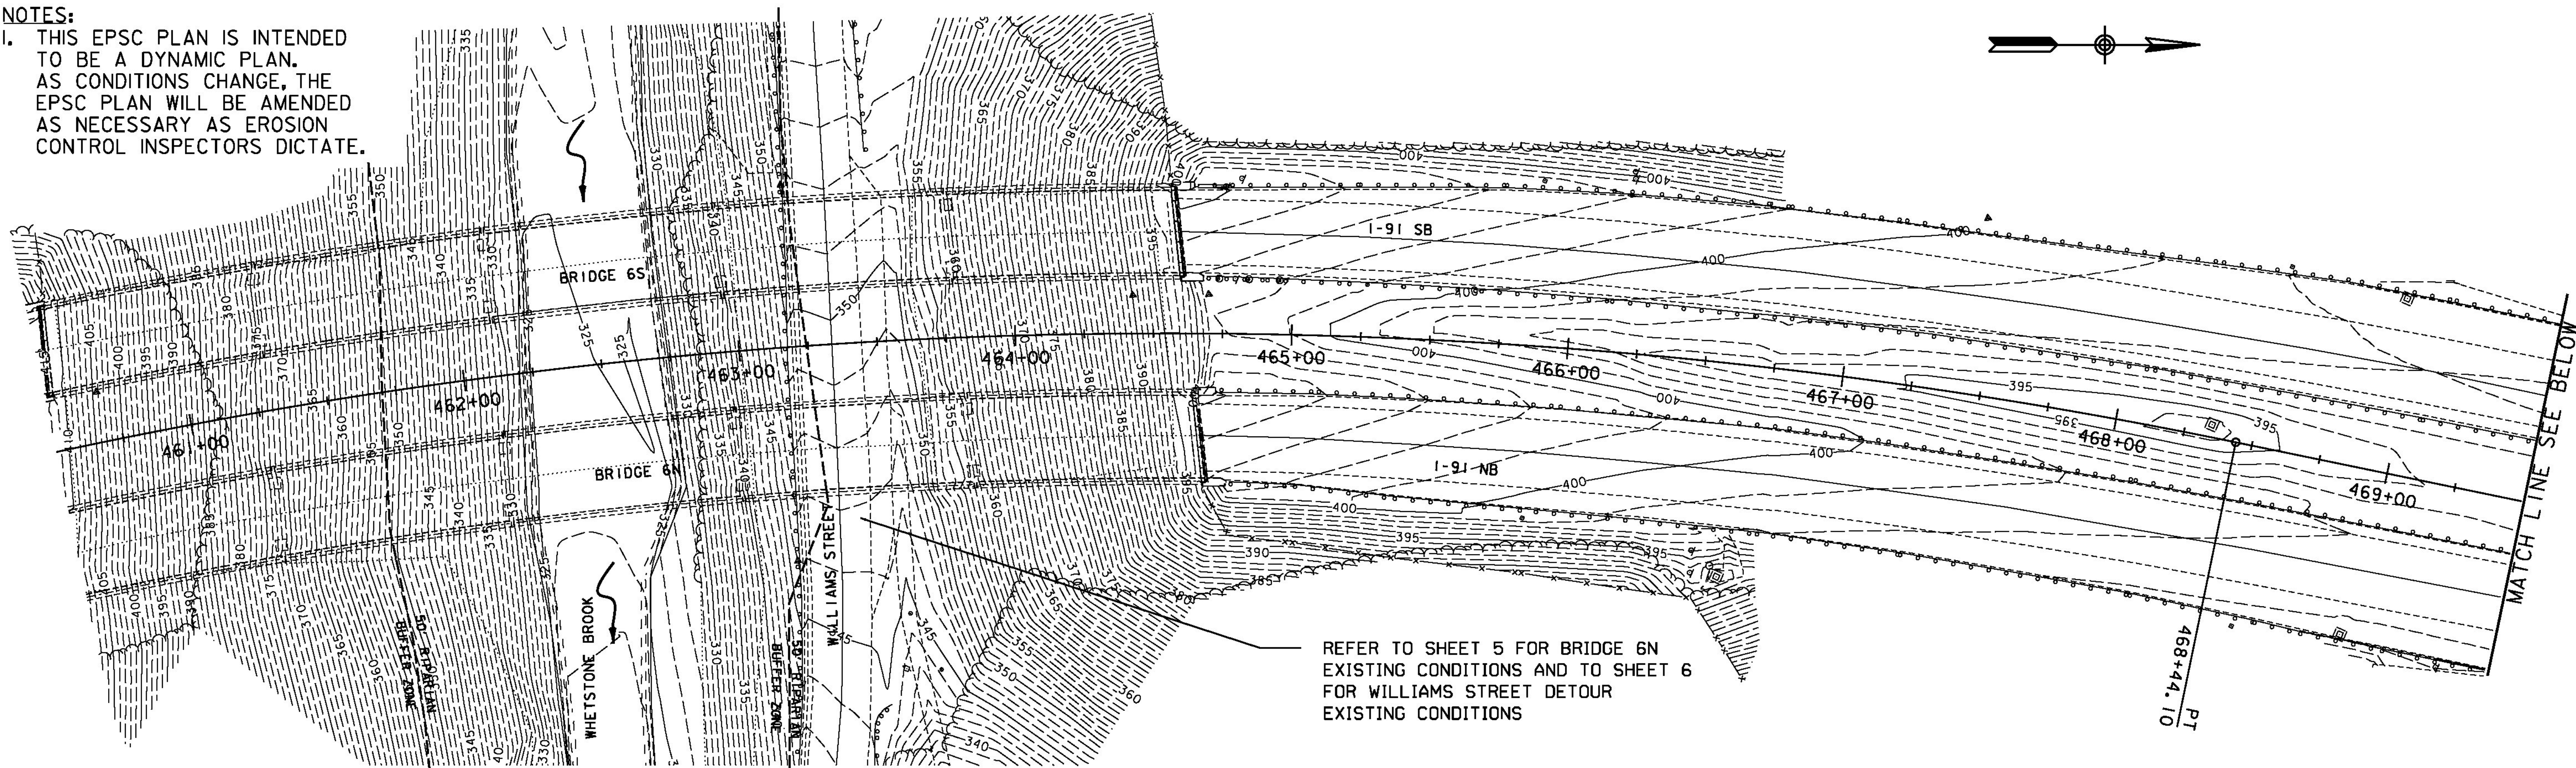

**AS BUILT  
 RECORD PLANS**

SCALE 1" = 30'-0"  
 30 0 30

RFC WORK PACKAGE #1C  
 03/18/2011

BECK & BELLUCCI, INC.

TYLIN INTERNATIONAL

PROJECT NAME: I-91 BRIDGE IMPROVEMENTS	PLOT DATE: 3/18/2011
PROJECT NUMBER: BRATTLEBORO AC IM 091-(K50)	DRAWN BY: Brian Waehler
FILE NAME: EPSC 7.DGN	CHECKED BY: John St. John
PROJECT LEADER: Brian W. Clogston P.E.	SHEET 7 OF 20
DESIGNED BY: Brian Waehler P.E.	
EPSC PLAN PHASE I - EXISTING CONDITIONS	