



NOTES:  
 1. THIS EPSC PLAN IS INTENDED TO BE A DYNAMIC PLAN. AS CONDITIONS CHANGE, THE EPSC PLAN WILL BE AMENDED AS NECESSARY AS EROSION CONTROL INSPECTORS DICTATE.

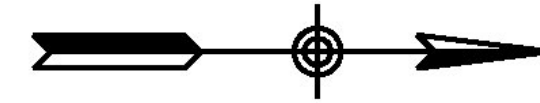


MATCH LINE SEE PREVIOUS SHEET

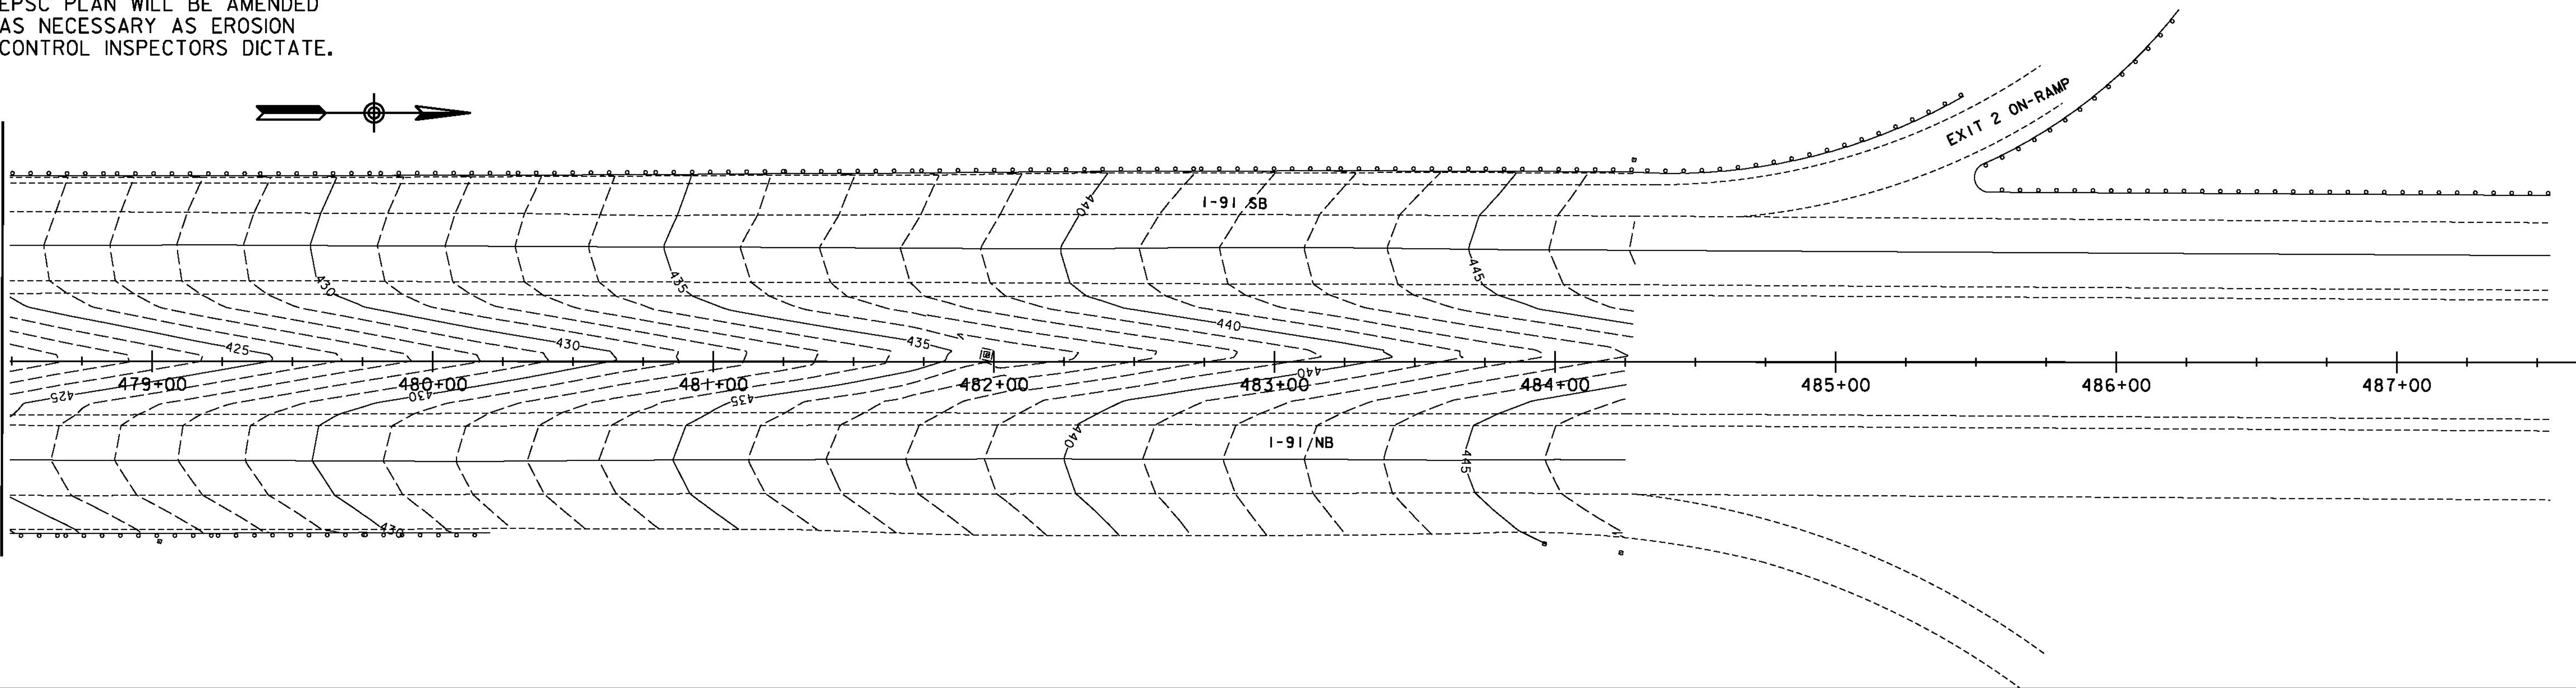

**AS BUILT  
 RECORD PLANS**

**RFC WORK PACKAGE #1C  
 03/18/2011**

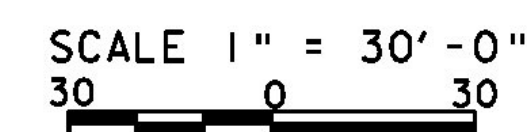

**BECK & BELLUCCI, INC.**

**TYLIN INTERNATIONAL**

PROJECT NAME: I-91 BRIDGE IMPROVEMENTS	
PROJECT NUMBER: BRATTLEBORO AC IM 091-(150)	
FILE NAME: EPSC 8.DGN	PLOT DATE: 3/18/2011
PROJECT LEADER: Brian W. Clogston P.E.	DRAWN BY: Brian Waehler
DESIGNED BY: Brian Waehler P.E.	CHECKED BY: John St. John
EPSC PLAN PHASE I - EXISTING CONDITIONS SHEET 8 OF 20	