

**NOTES:**

1. THIS EPSC PLAN IS INTENDED TO BE A DYNAMIC PLAN. AS CONDITIONS CHANGE, THE EPSC PLAN WILL BE AMENDED AS NECESSARY AS EROSION CONTROL INSPECTORS DICTATE.
2. CONTRACTOR SHALL DESIGNATE A CONCRETE WASHOUT AREA ADJACENT TO PROPOSED BRIDGE 6N.


REMOVE AND REINSTALL RIPRAP ON EXCAVATED SLOPE REQUIRED FOR TEMPORARY TRESTLE CONSTRUCTION

INSTALL SEDIMENT CURTAIN AROUND PERIMETER OF TEMPORARY PIERS DURING INSTALLATION AND REMOVAL WITHIN THE BROOK AND ANCHOR WITH SAND BAGS

ACCESS ROAD FOR TEMPORARY TRESTLE TO BE CONSTRUCTED OF A 3-INCH LAYER OF 1½-INCH CRUSHED STONE OVER 6-INCH THICK LAYER OF GRANULAR MATERIAL

PROPOSED TEMPORARY CHANNEL MATTING (NORTH AMERICAN GREEN SC 150 BN OR APPROVED EQUAL) (TYP)

PROPOSED SILT FENCE (TYP)

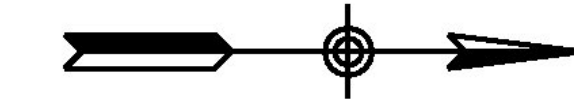

MATCH LINE SEE PREVIOUS SHEET

STABILIZE EXPOSED SLOPES ASSOCIATED WITH CROSSOVER CONSTRUCTION WITH WOOD CHIP MULCH OR TEMPORARY SEEDING IF THE SEASON ALLOWS (TYP)

MAINTAIN STABILIZED RIPRAP SURFACE AT PIERS AND ABUTMENTS

MONITOR EXPOSED SELECT MATERIALS TO ENSURE STABLE SURFACE

BRIDGE 6N

WHETSTONE BROOK

STONE CHECK DAM (TYP)

MAINTAIN STABILIZED RIPRAP SURFACE AT PIERS AND ABUTMENTS

REFER TO SHEET 15 FOR EPSC MEASURES TO BE IMPLEMENTED IN THE BRIDGE 6N AREA DURING CROSSOVER CONSTRUCTION

REFER TO SHEET 14 FOR EPSC MEASURES TO BE IMPLEMENTED DURING CONSTRUCTION OF THE WILLIAMS STREET DETOUR

**LEGEND**

- SILT FENCE
- STONE AND BLOCK DROP INLET PROTECTION
- BF - BF BARRIER FENCE (WITHIN 100 FT OF WATER RESOURCE)
- PDF - PDF PROJECT DEMARCATION FENCE
- ⊕ PIPE INLET PROTECTION
- ⊙ ROLLED EROSION CONTROL PRODUCT SIDE SLOPE
- ⊖ STONE CHECK DAM

**AS BUILT RECORD PLANS**

SCALE 1" = 30'-0"  
30 0 30

**RFC WORK PACKAGE #1C  
03/18/2011**

BECK & BELLUCCI, INC.

TYLIN INTERNATIONAL

PROJECT NAME: I-91 BRIDGE IMPROVEMENTS

PROJECT NUMBER: BRATTLEBORO AC IM 091-(150)

FILE NAME: EPSC I3.DGN

PLOT DATE: 3/18/2011

PROJECT LEADER: Brian W. Clogston P.E.

DRAWN BY: Brian Waehler

DESIGNED BY: Brian Waehler P.E.

CHECKED BY: John St. John

EPSC PLAN PHASE I - TEMPORARY CONDITIONS SHEET 13 OF 20