



NOTES:  
 1. THIS EPSC PLAN IS INTENDED TO BE A DYNAMIC PLAN. AS CONDITIONS CHANGE, THE EPSC PLAN WILL BE AMENDED AS NECESSARY AS EROSION CONTROL INSPECTORS DICTATE.

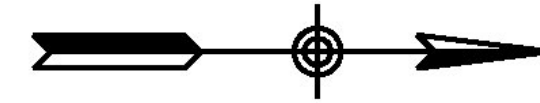


MATCH LINE SEE PREVIOUS SHEET

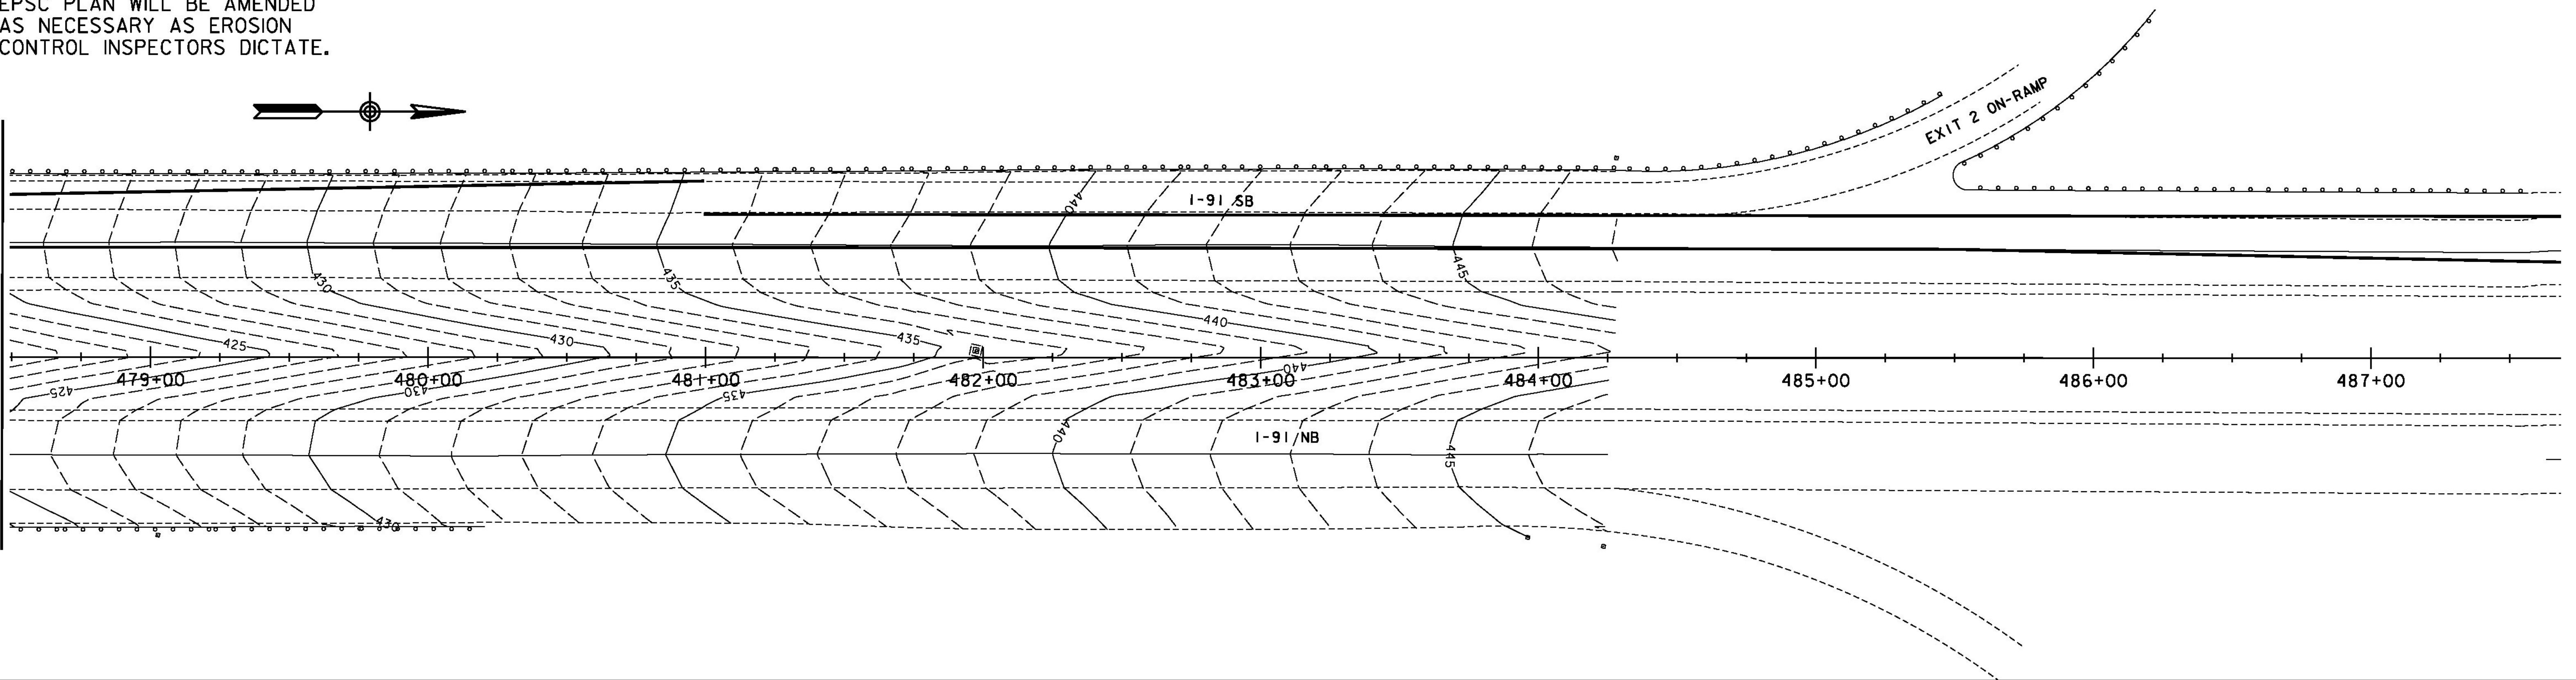

**LEGEND**

- DIRECTION OF TRAVEL
- BRIDGE CONSTRUCTION ZONE
- CONCRETE BARRIER
- ROLLED EROSION CONTROL PRODUCT SIDE SLOPE
- BARRIER FENCE (WITHIN 100 FT OF WATER RESOURCE)
- PROJECT DEMARCATION FENCE
- SILT FENCE
- STONE AND BLOCK DROP INLET PROTECTION
- PIPE INLET PROTECTION
- STONE CHECK DAM

**AS BUILT RECORD PLANS**

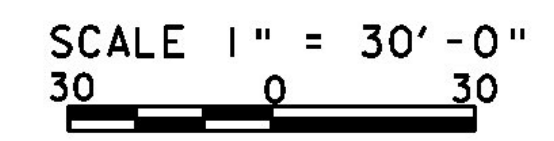

RFC WORK PACKAGE #1C  
 03/18/2011

**BECK & BELLUCCI, INC.** **TYLIN INTERNATIONAL**

PROJECT NAME: I-91 BRIDGE IMPROVEMENTS	
PROJECT NUMBER: BRATTLEBORO AC IM 091-(150)	
FILE NAME: EPSC 16.DGN	PLOT DATE: 3/18/2011
PROJECT LEADER: Brian W. Clogston P.E.	DRAWN BY: Brian Waehler
DESIGNED BY: Brian Waehler P.E.	CHECKED BY: John St. John
EPSC PLAN PHASE I - TEMPORARY CONDITIONS SHEET 16 OF 20	