
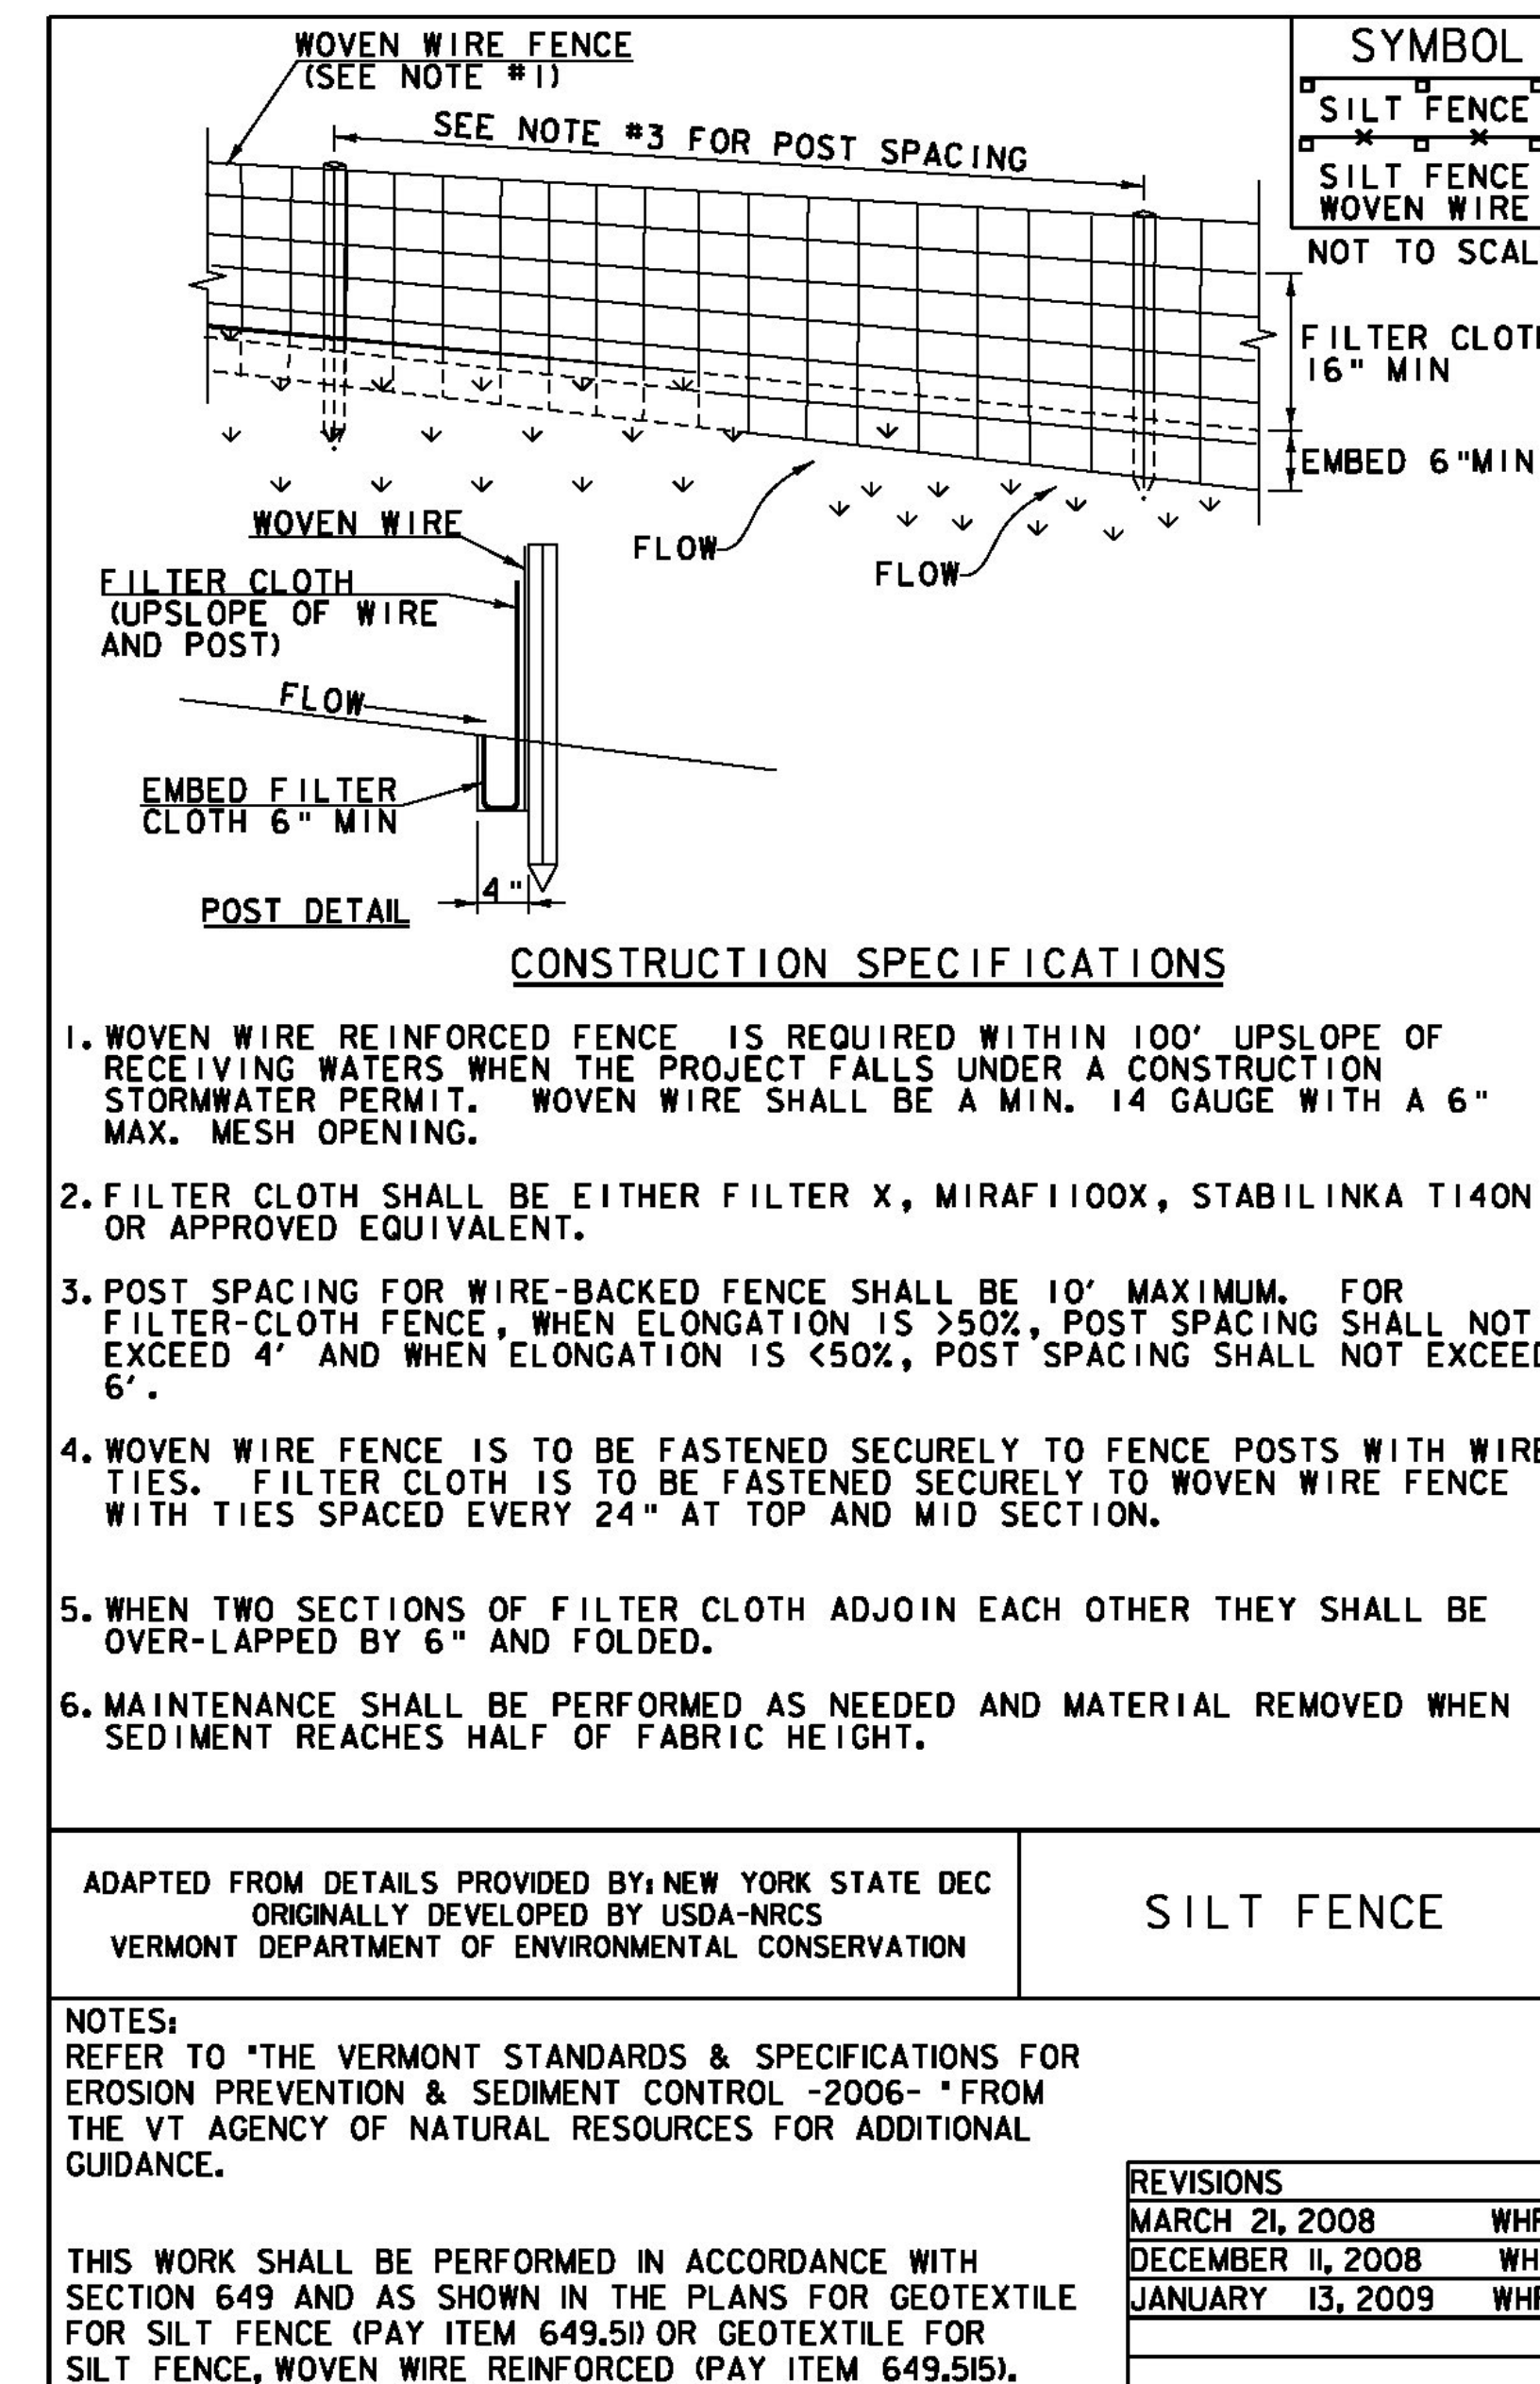
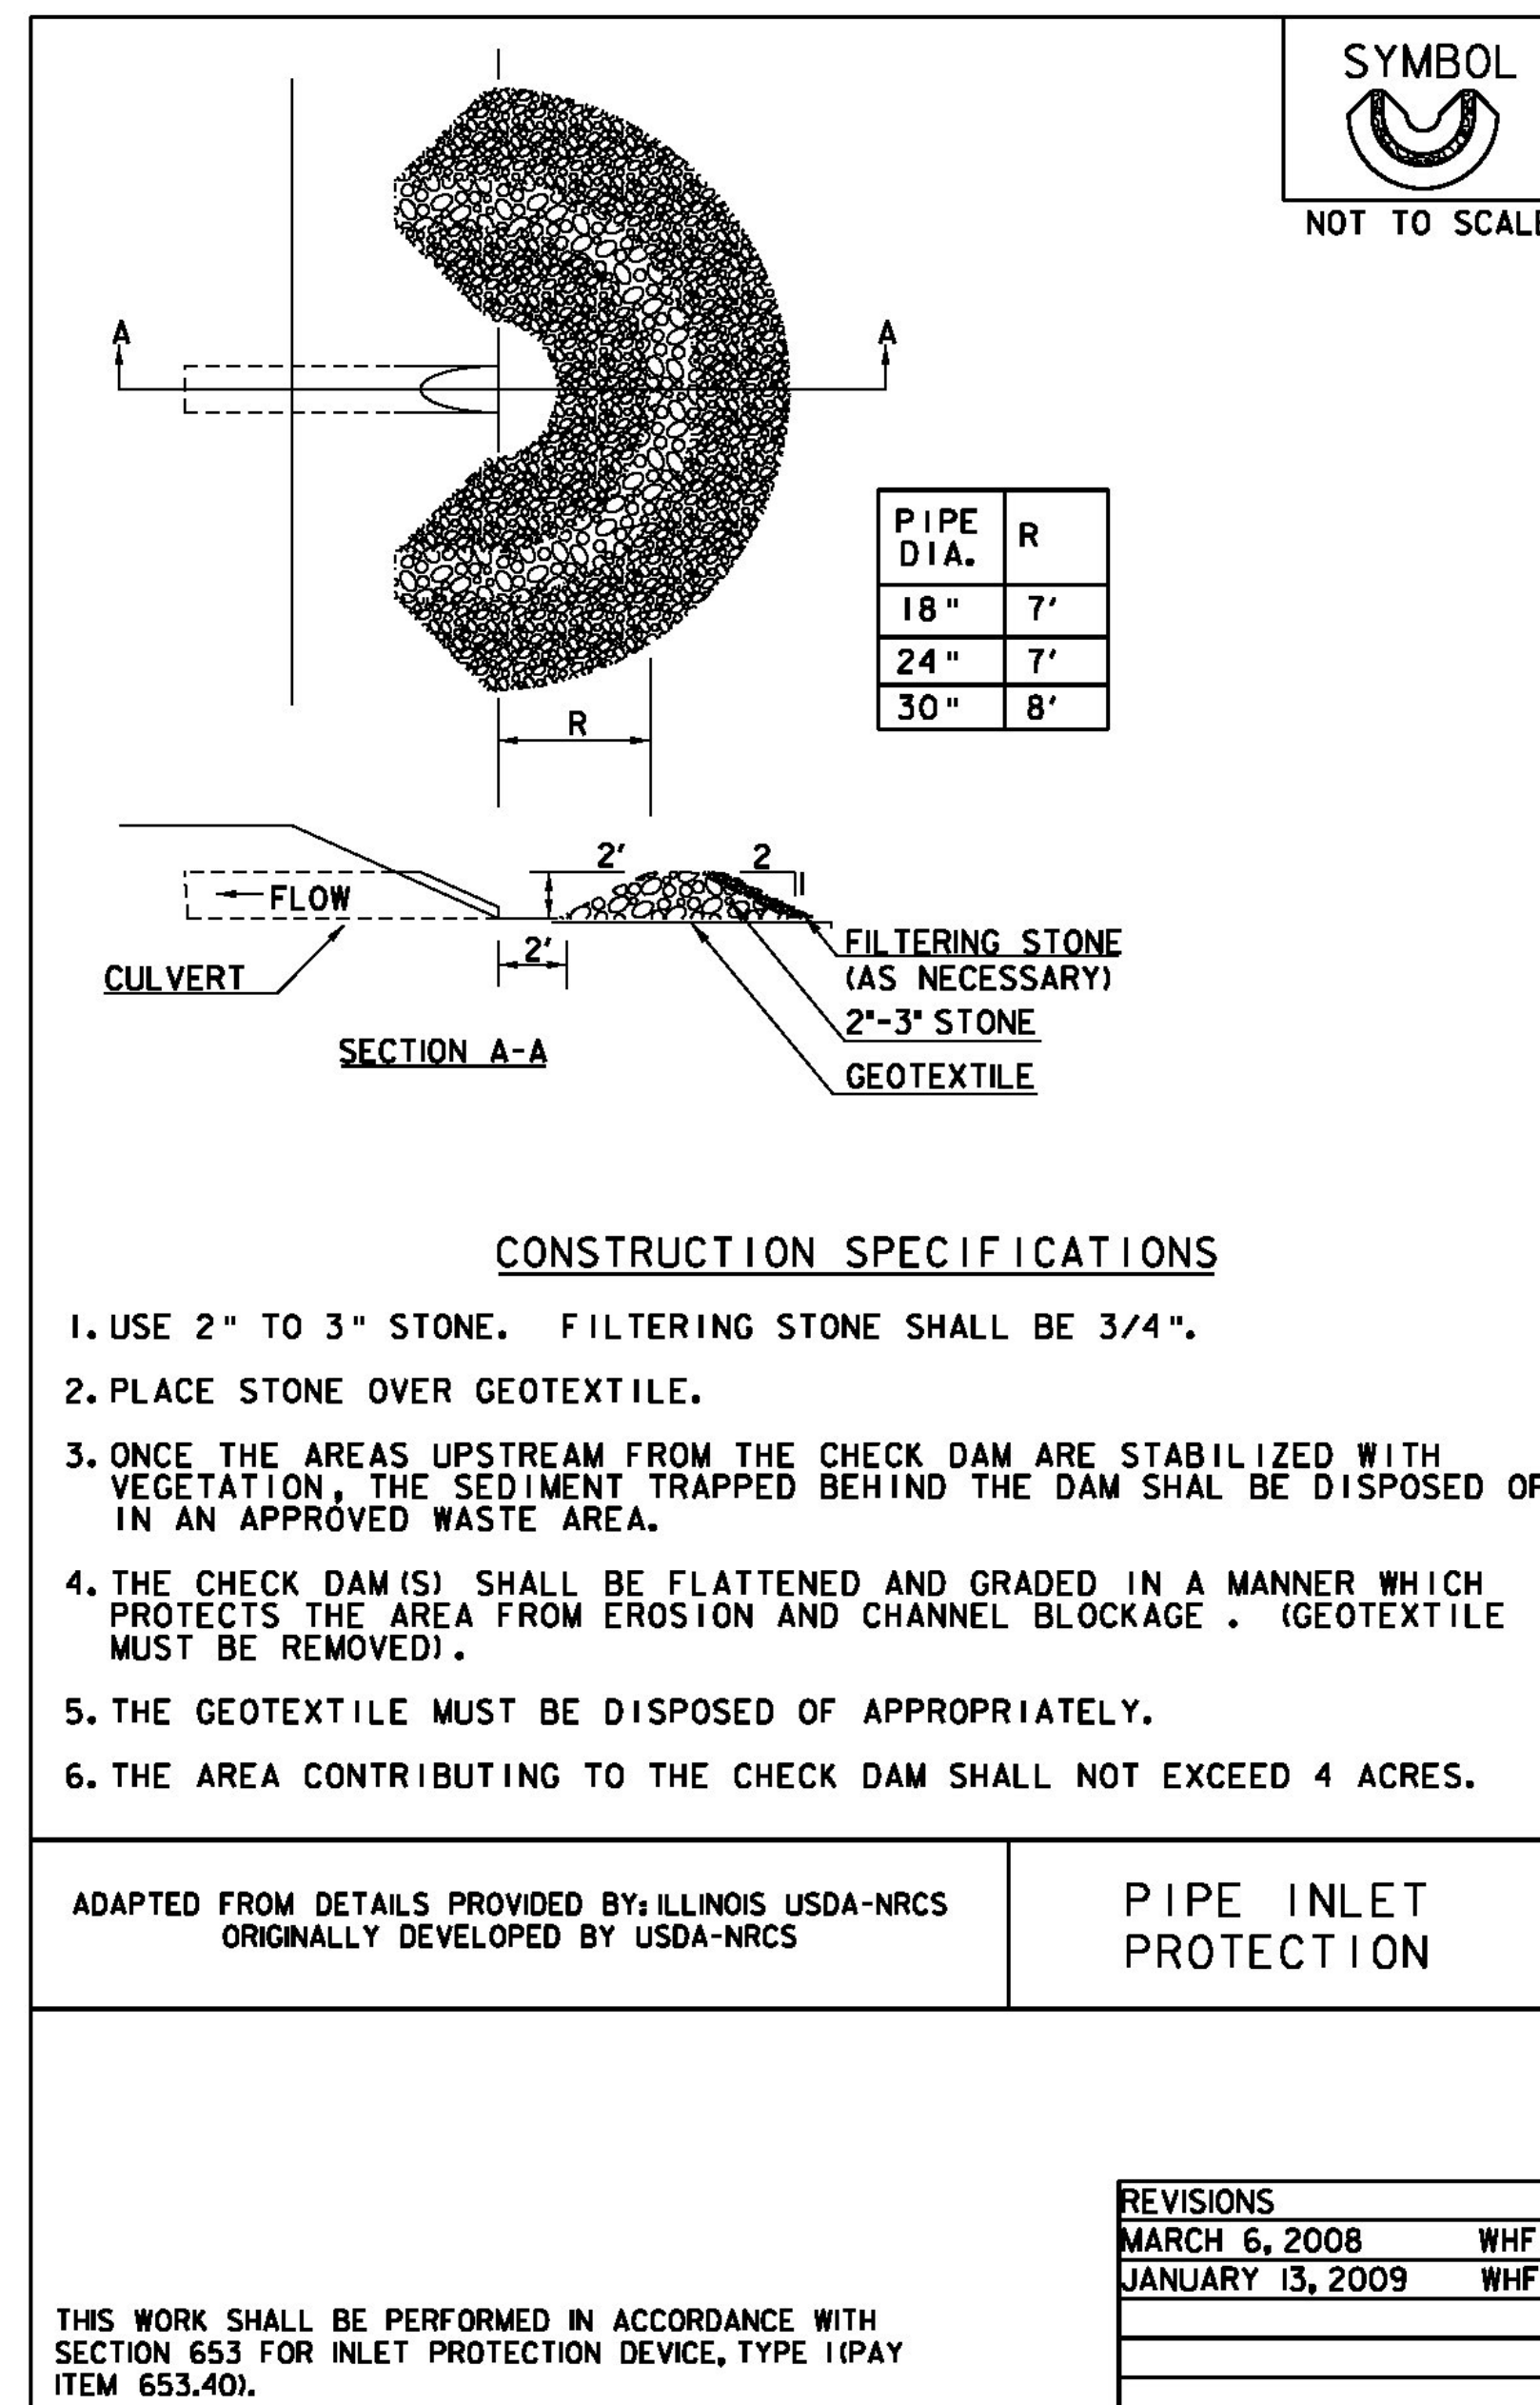


NOTES:  
 1. THIS EPSC PLAN IS INTENDED TO BE A DYNAMIC PLAN. AS CONDITIONS CHANGE, THE EPSC PLAN WILL BE AMENDED AS NECESSARY AS EROSION CONTROL INSPECTORS DICTATE.

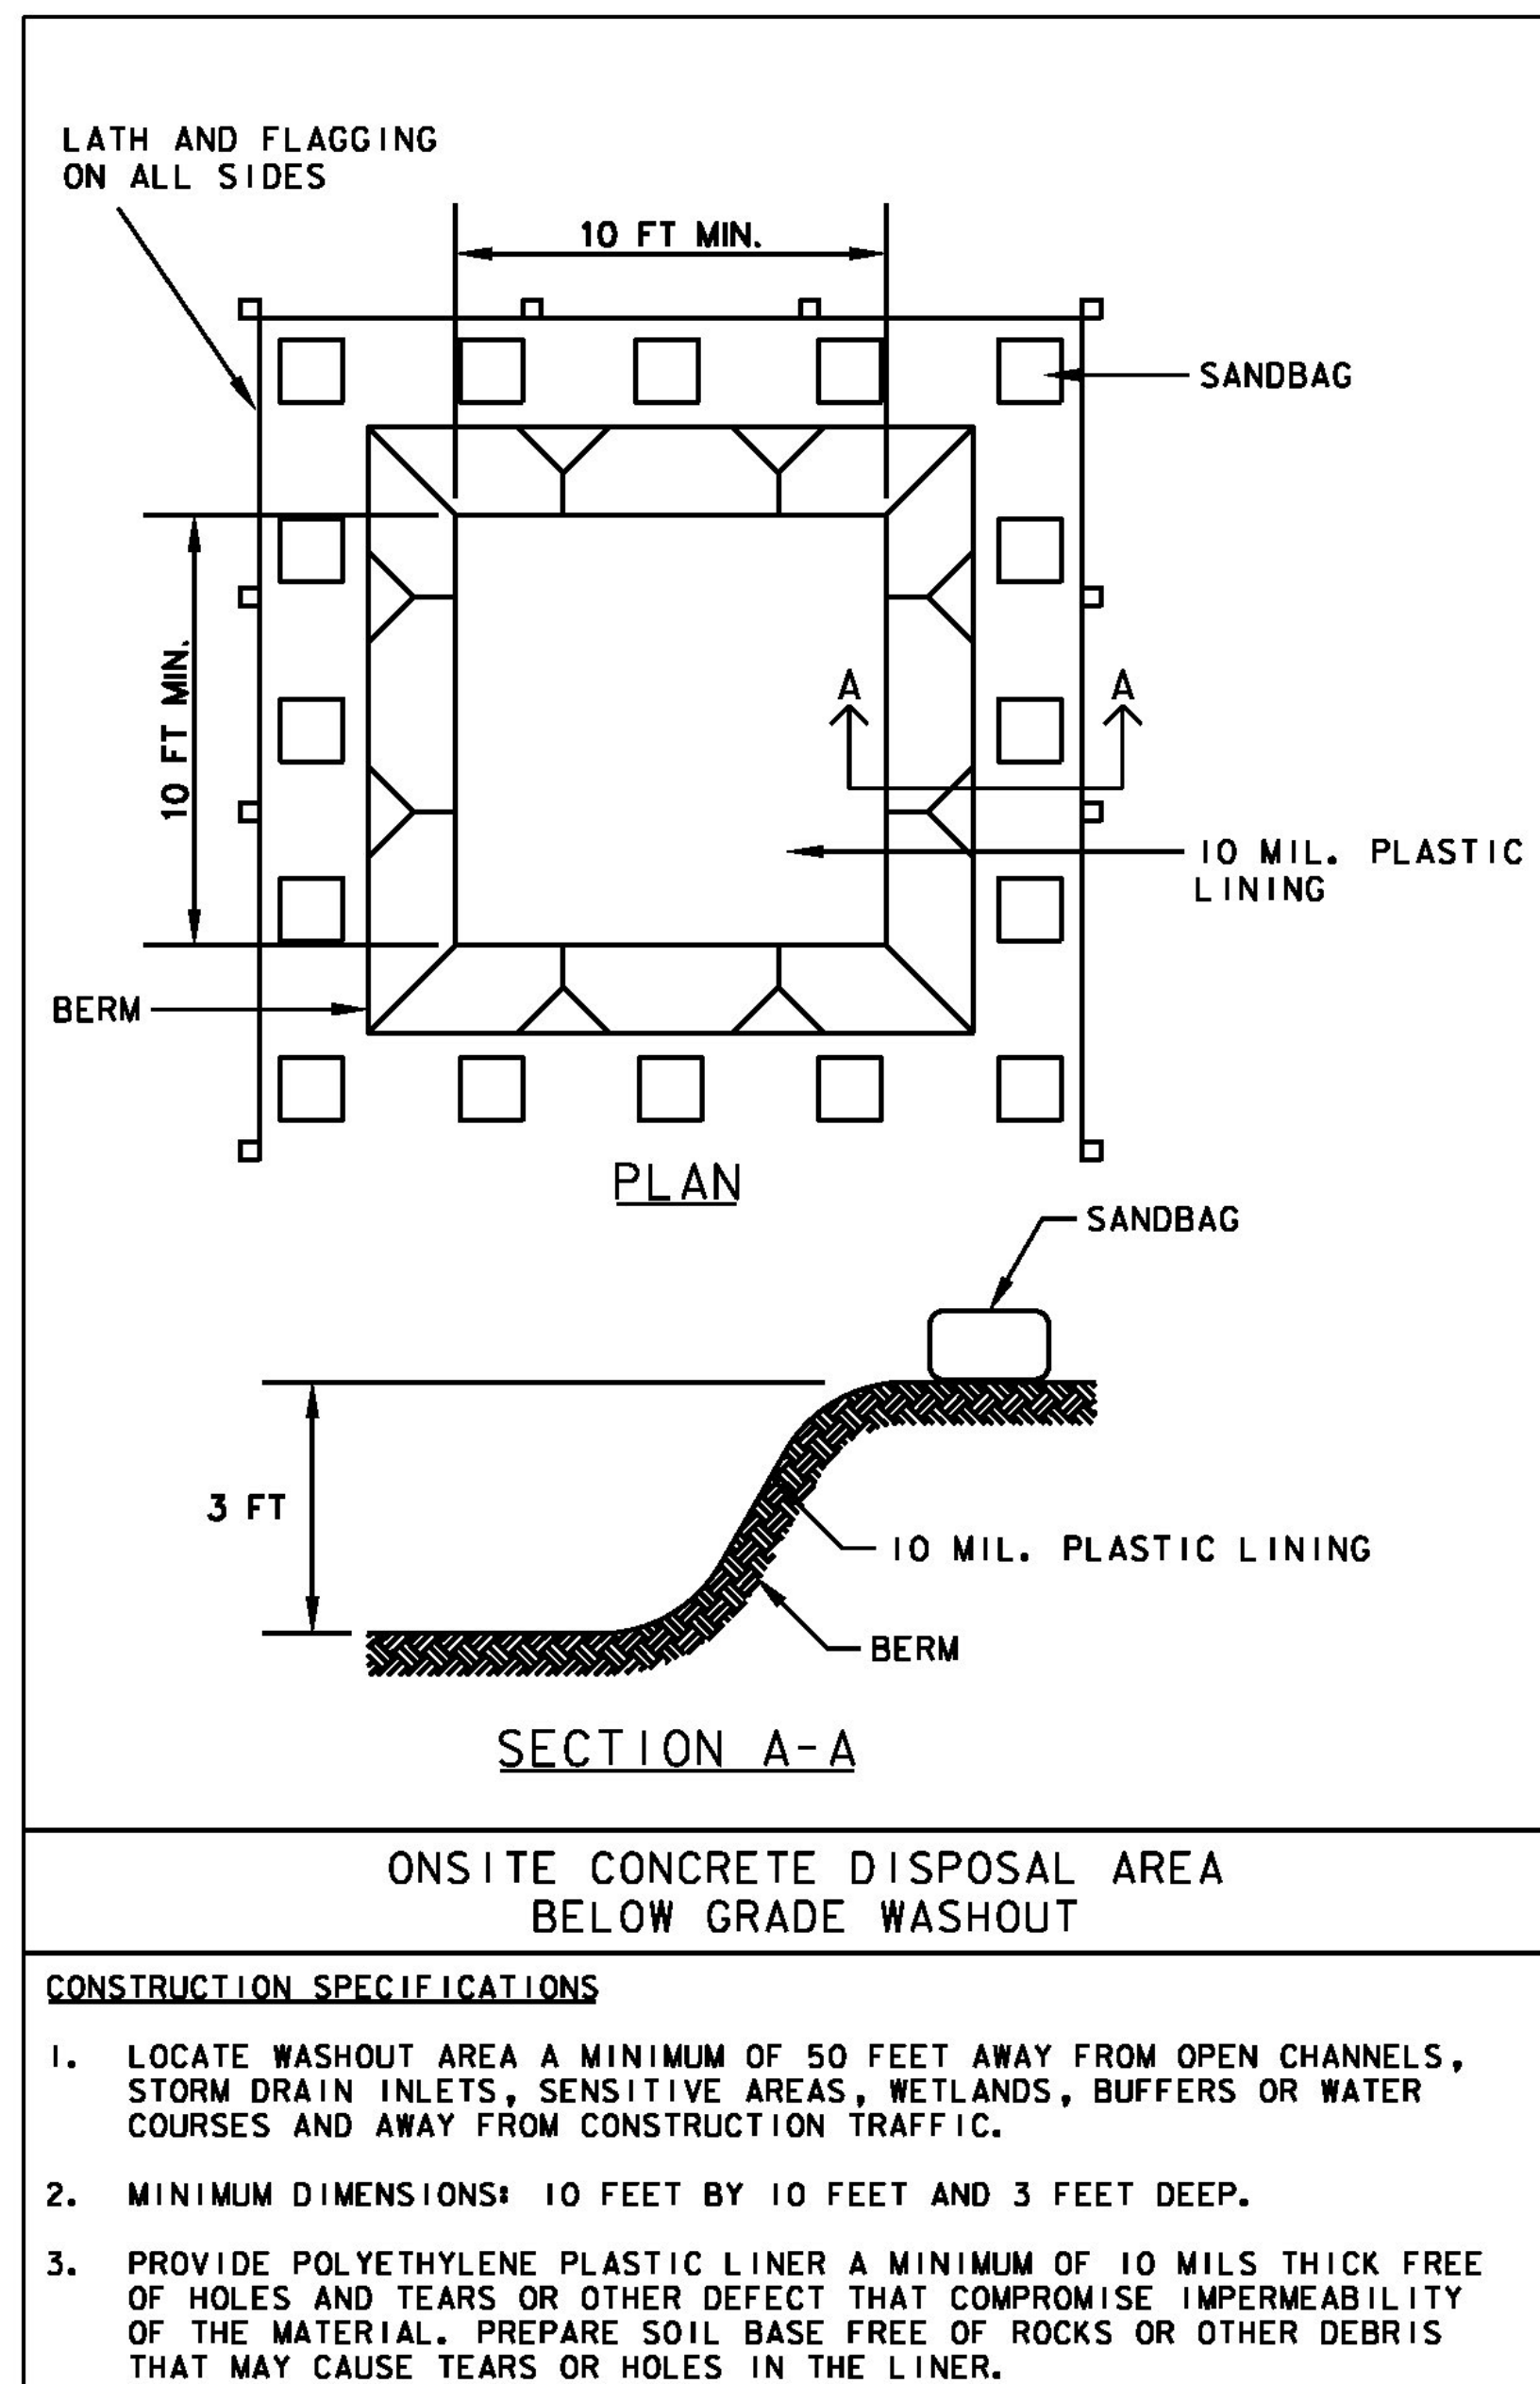

**AS BUILT  
RECORD PLANS**

**RFC WORK PACKAGE #1C  
03/18/2011**

<b>BECK &amp; BELLUCCI, INC.</b>	<b>TYLIN INTERNATIONAL</b>	PROJECT NAME: I-91 BRIDGE IMPROVEMENTS	PLOT DATE: 3/18/2011
		PROJECT NUMBER: BRATTLEBORO AC IM 091-(150)	DRAWN BY: Brian Waehler
		FILE NAME: EPSC 17.DGN	CHECKED BY: John St. John
		PROJECT LEADER: Brian W. Clogston P.E.	SHEET 17 OF 20
		DESIGNED BY: Brian Waehler P.E.	
		EPSC PLAN PHASE I - DETAIL SHEET	