


EXIT 1 - RAMPS G & H NORTHBOUND ON RAMP

SEE STANDARDS E-191, E-192 AND E-193
FOR PAVEMENT MARKING GUIDELINES


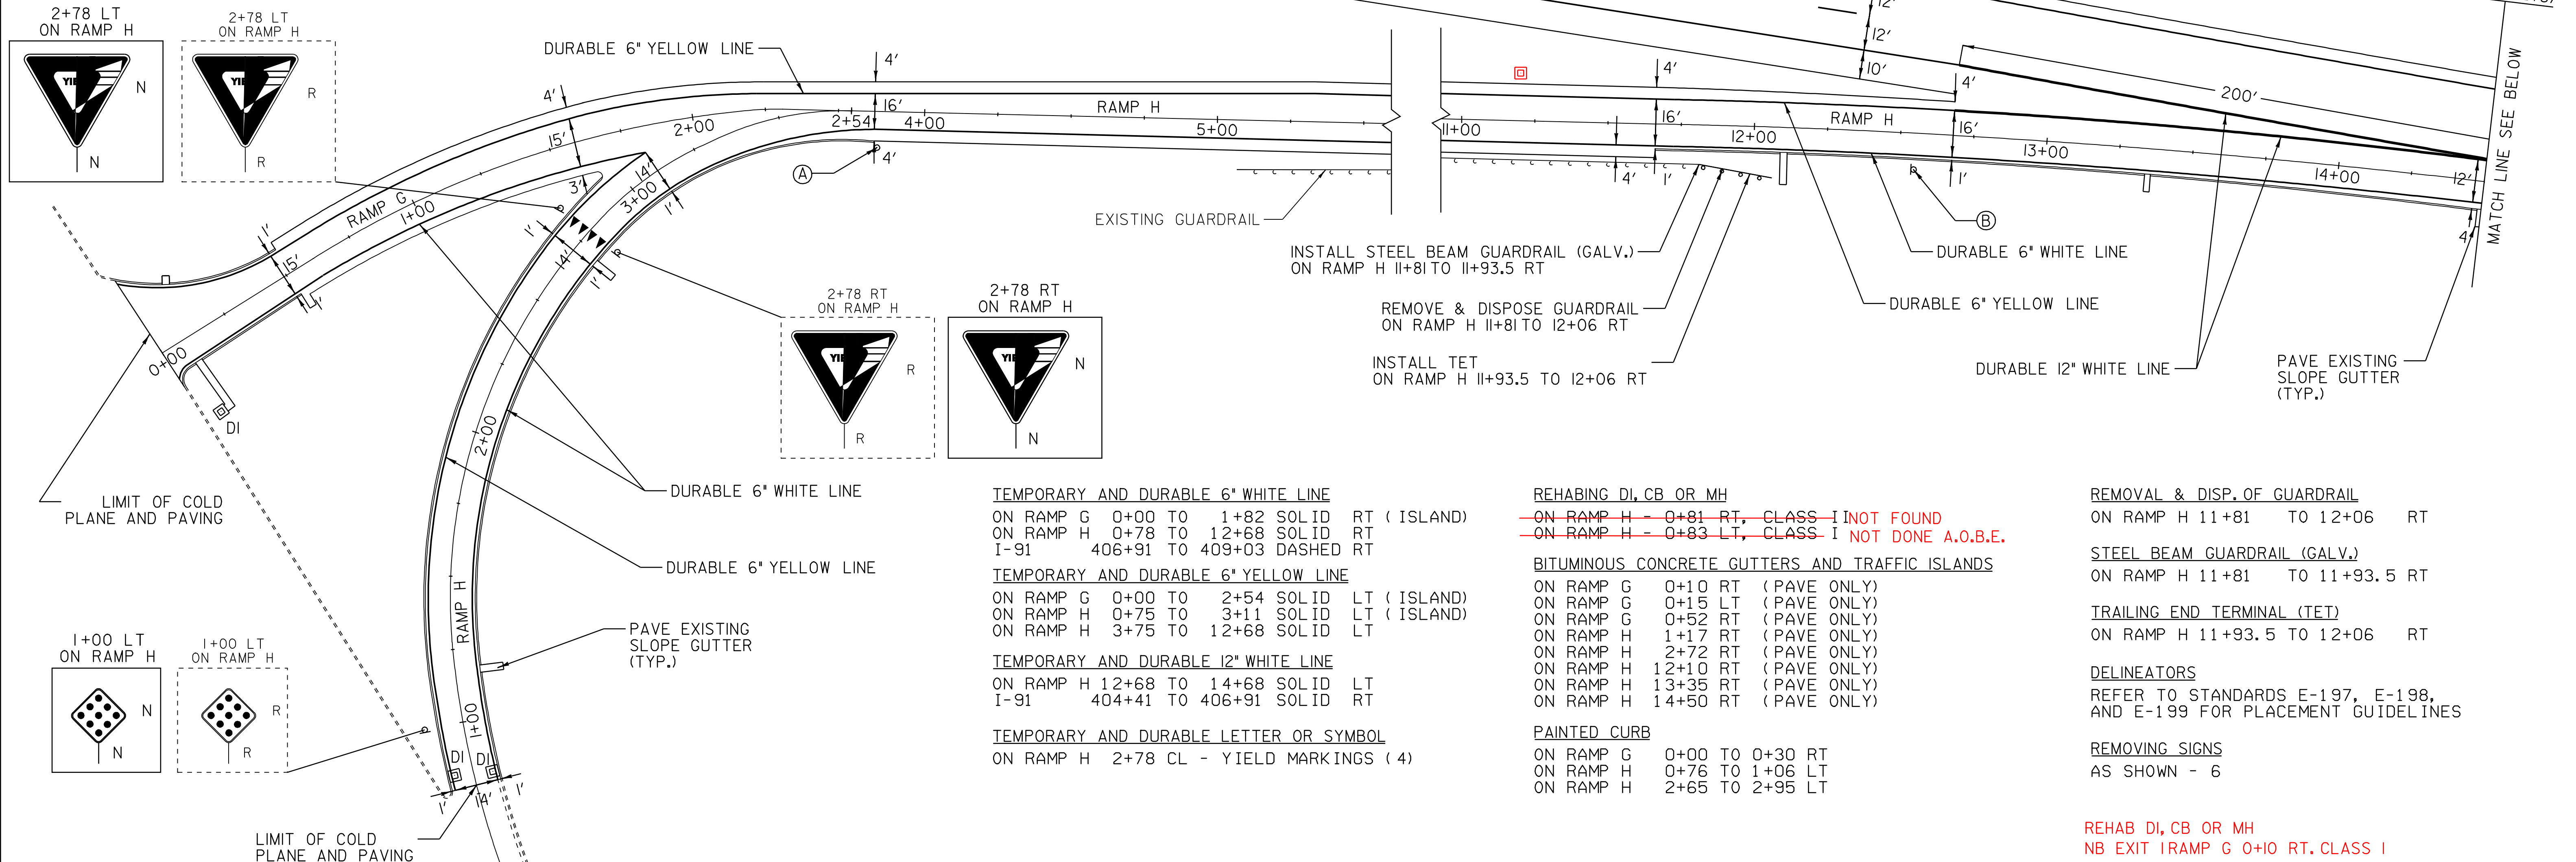


- TEMPORARY AND DURABLE 6" WHITE LINE**
 - ON RAMP G 0+00 TO 1+82 SOLID RT (ISLAND)
 - ON RAMP H 0+78 TO 12+68 SOLID RT
 - I-91 406+91 TO 409+03 DASHED RT
- TEMPORARY AND DURABLE 6" YELLOW LINE**
 - ON RAMP G 0+00 TO 2+54 SOLID LT (ISLAND)
 - ON RAMP H 0+75 TO 3+11 SOLID LT (ISLAND)
 - ON RAMP H 3+75 TO 12+68 SOLID LT
- TEMPORARY AND DURABLE 12" WHITE LINE**
 - ON RAMP H 12+68 TO 14+68 SOLID LT
 - I-91 404+41 TO 406+91 SOLID RT
- TEMPORARY AND DURABLE LETTER OR SYMBOL**
 - ON RAMP H 2+78 CL - YIELD MARKINGS (4)

- REHABING DI, CB OR MH**
 - ~~ON RAMP H 0+81 RT, CLASS I NOT FOUND~~
 - ~~ON RAMP H 0+83 LT, CLASS I NOT DONE A.O.B.E.~~
- BITUMINOUS CONCRETE GUTTERS AND TRAFFIC ISLANDS**
 - ON RAMP G 0+10 RT (PAVE ONLY)
 - ON RAMP G 0+15 LT (PAVE ONLY)
 - ON RAMP G 0+52 RT (PAVE ONLY)
 - ON RAMP H 1+17 RT (PAVE ONLY)
 - ON RAMP H 2+72 RT (PAVE ONLY)
 - ON RAMP H 12+10 RT (PAVE ONLY)
 - ON RAMP H 13+35 RT (PAVE ONLY)
 - ON RAMP H 14+50 RT (PAVE ONLY)
- PAINTED CURB**
 - ON RAMP G 0+00 TO 0+30 RT
 - ON RAMP H 0+76 TO 1+06 LT
 - ON RAMP H 2+65 TO 2+95 LT

- REMOVAL & DISP. OF GUARDRAIL**
 - ON RAMP H 11+81 TO 12+06 RT
- STEEL BEAM GUARDRAIL (GALV.)**
 - ON RAMP H 11+81 TO 11+93.5 RT
- TRAILING END TERMINAL (TET)**
 - ON RAMP H 11+93.5 TO 12+06 RT
- DELINEATORS**
 - REFER TO STANDARDS E-197, E-198, AND E-199 FOR PLACEMENT GUIDELINES
- REMOVING SIGNS**
 - AS SHOWN - 6

REHAB DI, CB OR MH
NB EXIT 1 RAMP G 0+10 RT, CLASS I
NB EXIT 1 RAMP H 11+35 +/- LT CLASS II

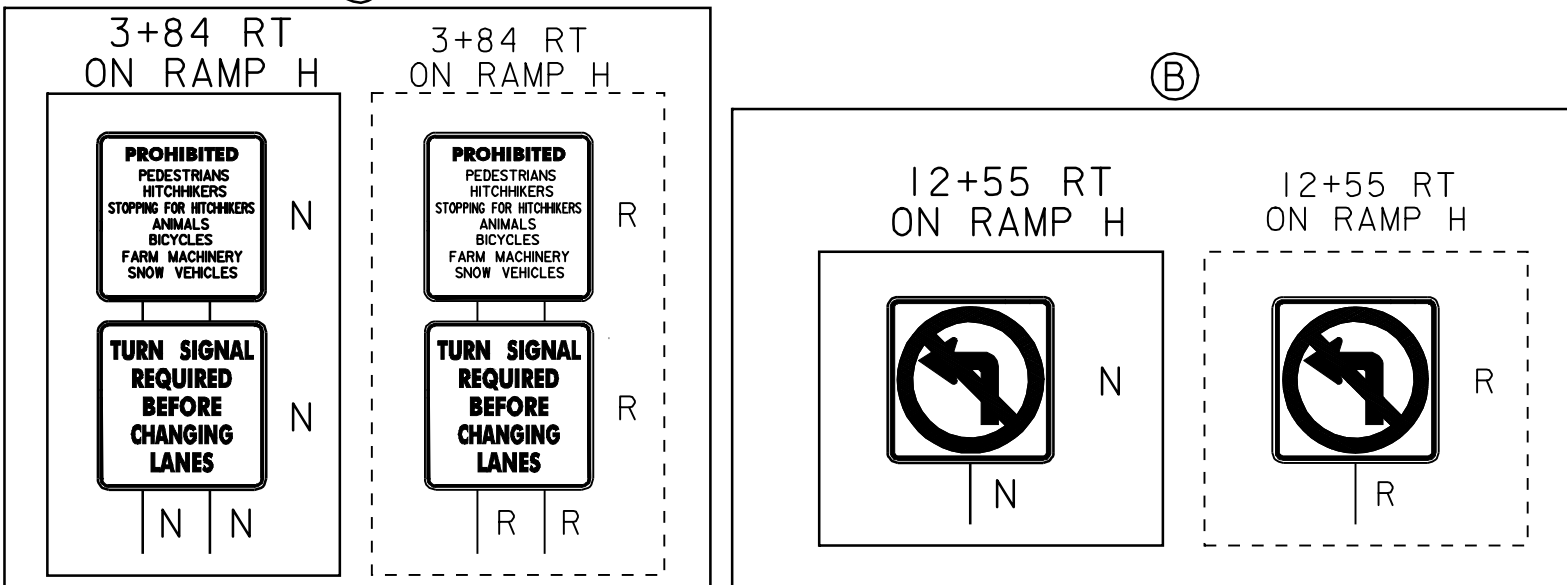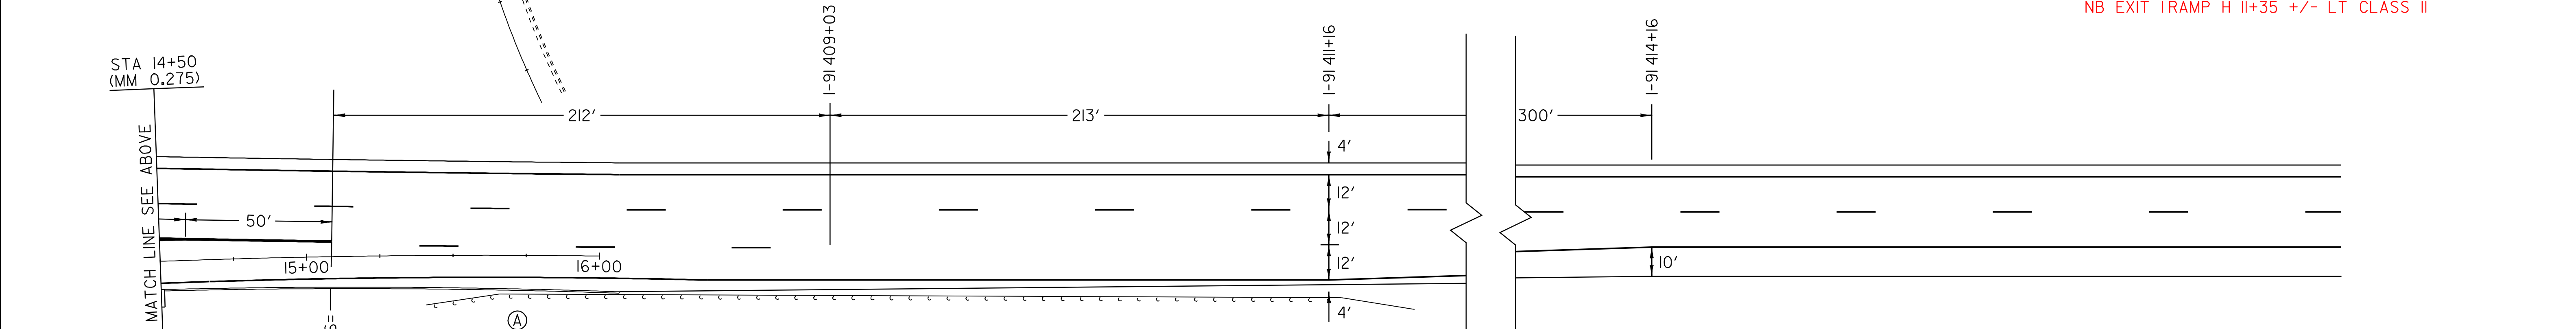

- LEGEND**
- R = REMOVE EXISTING
 - S = SALVAGE
 - R & S = REMOVE AND SALVAGE
 - N = NEW
 - RET = RETAIN
 - B-B = BACK TO BACK
 - = NEW RAIL
 - = EXISTING RAIL

**RAMP
DETAIL #2**

PROJECT NAME: GUILFORD-BRATTLEBORO	PLOT DATE: 22-JAN-2009 13:3
PROJECT NUMBER: AC IM 091-1(51)	DRAWN BY: JCS
FILE NAME: 03A020rmp2.1	CHECKED BY: NLL
PROJECT LEADER: CRB	CLD REF. NO. 04-0398
DESIGNED BY: CLD	SHEET 22 OF 69

DATUM
VERTICAL _____
HORIZONTAL _____

NOT TO SCALE