
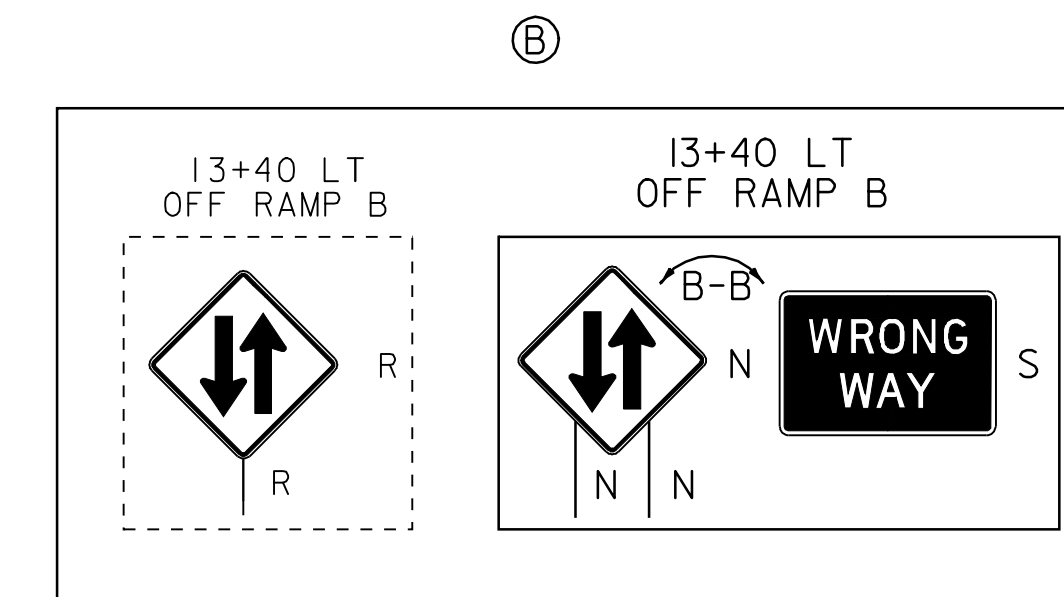


# EXIT 2 - RAMPS A & B NORTHBOUND ON & OFF RAMPS

SEE STANDARDS E-191, E-192 AND E-193  
FOR PAVEMENT MARKING GUIDELINES

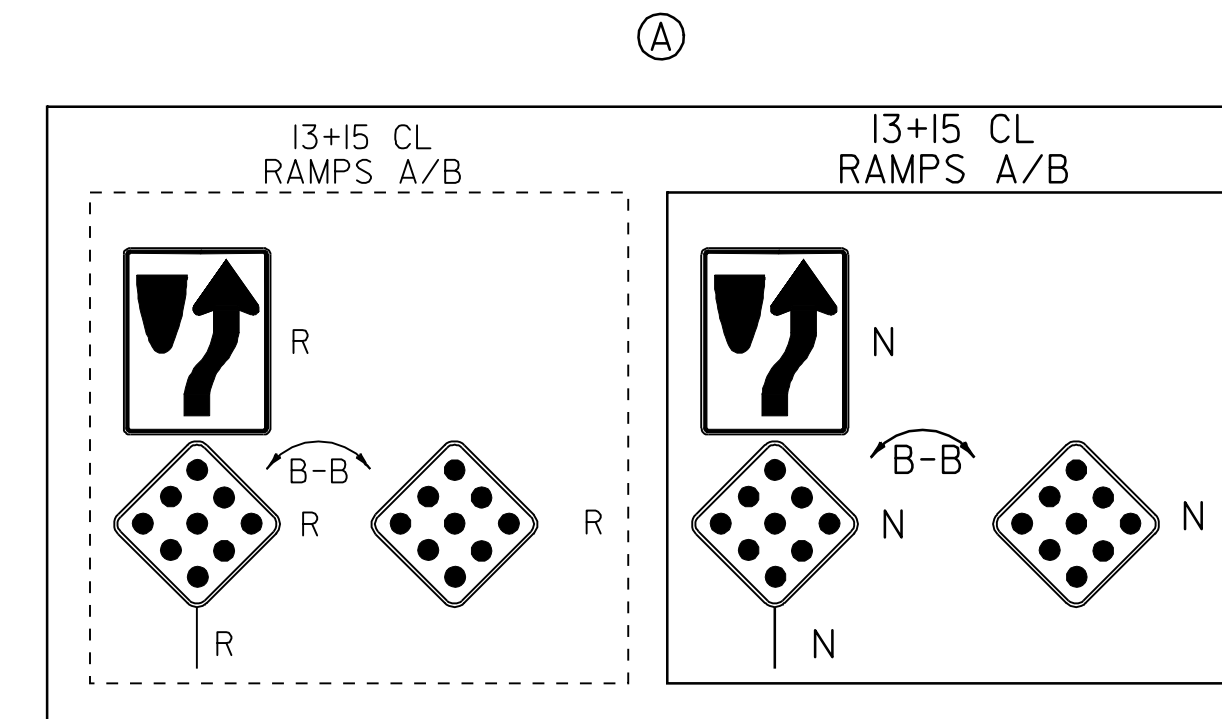

**TEMPORARY AND DURABLE 6" WHITE LINE**

OFF RAMP B	0+00 TO 7+03	SOLID	LT
ON RAMP A	0+00 TO 8+75	SOLID	RT
ON RAMP A	11+00 TO 13+64	SOLID	RT
OFF RAMP B	11+00 TO 13+64	SOLID	LT
I-91	472+92 TO 474+92	DASHED	RT
I-91	468+52 TO 472+92	DOTTED	RT

**TEMPORARY AND DURABLE 6" YELLOW LINE**

ON RAMP A	0+00 TO 8+75	SOLID	LT
OFF RAMP B	0+00 TO 7+03	SOLID	RT
ON RAMP A	10+75 TO 13+64	SOLID	RT
OFF RAMP B	10+75 TO 13+64	SOLID	LT

**TEMPORARY AND DURABLE 12" WHITE LINE**

OFF RAMP B	7+03 TO 8+00	SOLID	RT
GORE STRIPES	7+03 TO 7+75	SOLID	RT
I-91	474+92 TO 475+92	SOLID	RT

**REHABING DI, CB, OR MH**  
ON RAMP A - 13+17 RT, CLASS ~~XX~~I

**BITUMINOUS CONCRETE GUTTERS AND TRAFFIC ISLANDS**

OFF RAMP B	- 4+13	LT (PAVE ONLY)
OFF RAMP B	- 5+64	LT (PAVE ONLY)
OFF RAMP B	- 6+82	LT (PAVE ONLY)
OFF RAMP B	- 8+12	LT (PAVE ONLY)
OFF RAMP B	- 13+12	LT (PAVE ONLY)

**PAINTED CURB**

ON RAMP A	13+11 TO 13+41	RT
OFF RAMP B	13+11 TO 13+41	LT

**REMOVAL & DISP. OF GUARDRAIL**  
ON RAMP A 11+00 TO 11+92 RT

**STEEL BEAM GUARDRAIL (GALV.)**  
ON RAMP A 11+00 TO 11+73.5 RT

**MANUFACTURED TERMINAL SECTION (MTS)**  
ON RAMP A 11+73.5 TO 12+11 RT (FLARED)  
**ON RAMP B 12+30 TO 12+67.5 RT DELINEATORS**

REFER TO STANDARDS E-197, E-198, AND E-199 FOR PLACEMENT GUIDELINES

**ERECTING SALVAGED SIGNS**  
AS SHOWN - 1

**REMOVING SIGNS**  
AS SHOWN - 6


REPLACE EXISTING MELT W/MTS  
EXISTING GUARDRAIL

INSTALL MTS (FLARED)  
ON RAMP 11+73.5 TO 12+11 RT

REMOVE & DISPOSE GUARDRAIL  
ON RAMP 11+00 TO 11+92 RT

INSTALL STEEL BEAM GUARDRAIL (GALV.)  
ON RAMP 11+00 TO 11+73.5 RT

STA 469+40  
(MM 8.890)

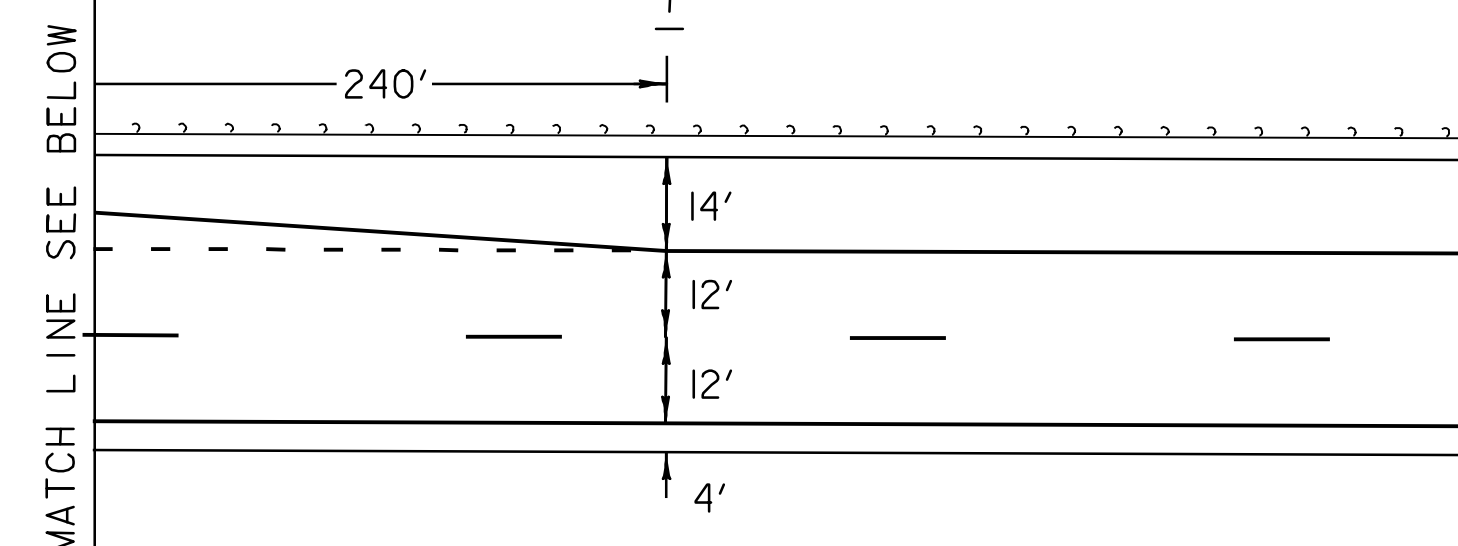

I-91 470+92

STA 469+40  
(MM 8.890)

MATCH LINE SEE ABOVE

**LEGEND**

- R = REMOVE EXISTING
- S = SALVAGE
- R & S = REMOVE AND SALVAGE
- N = NEW
- RET = RETAIN
- B-B = BACK TO BACK
- = NEW RAIL
- - - = EXISTING RAIL

**RAMP  
DETAIL #4**

PROJECT NAME: GUILFORD-BRATTLEBORO  
PROJECT NUMBER: AC IM 091-1(51)

FILE NAME: 03A020rmp4.1  
PROJECT LEADER: CRB  
DESIGNED BY: CLD  
CLD REF. NO. 04-0398

PLOT DATE: 22-JAN-2009 13:3  
DRAWN BY: JCS  
CHECKED BY: NLL  
SHEET 24 OF 69

NOT TO SCALE