

TEMPORARY AND DURABLE 6" WHITE LINE

ON RAMP A 8+75 TO 11+05 SOLID RT
I-91 485+65 TO 490+65 DASHED LT

TEMPORARY AND DURABLE 6" YELLOW LINE

ON RAMP A 8+75 TO 11+05 SOLID LT

TEMPORARY AND DURABLE 12" WHITE LINE

ON RAMP A 11+05 TO 11+77 SOLID LT
I-91 483+95 TO 485+65 SOLID RT

BITUMINOUS CONCRETE GUTTERS AND TRAFFIC ISLANDS

ON RAMP A - 9+89 RT (PAVE ONLY)

DELINEATORS


REFER TO STANDARDS E-197, E-198,
AND E-199 FOR PLACEMENT GUIDELINES

REMOVING SIGNS

AS SHOWN - 1

EXIT 2 - RAMP A NORTHBOUND ON RAMP

SEE STANDARDS E-191, E-192 AND E-193
FOR PAVEMENT MARKING GUIDELINES

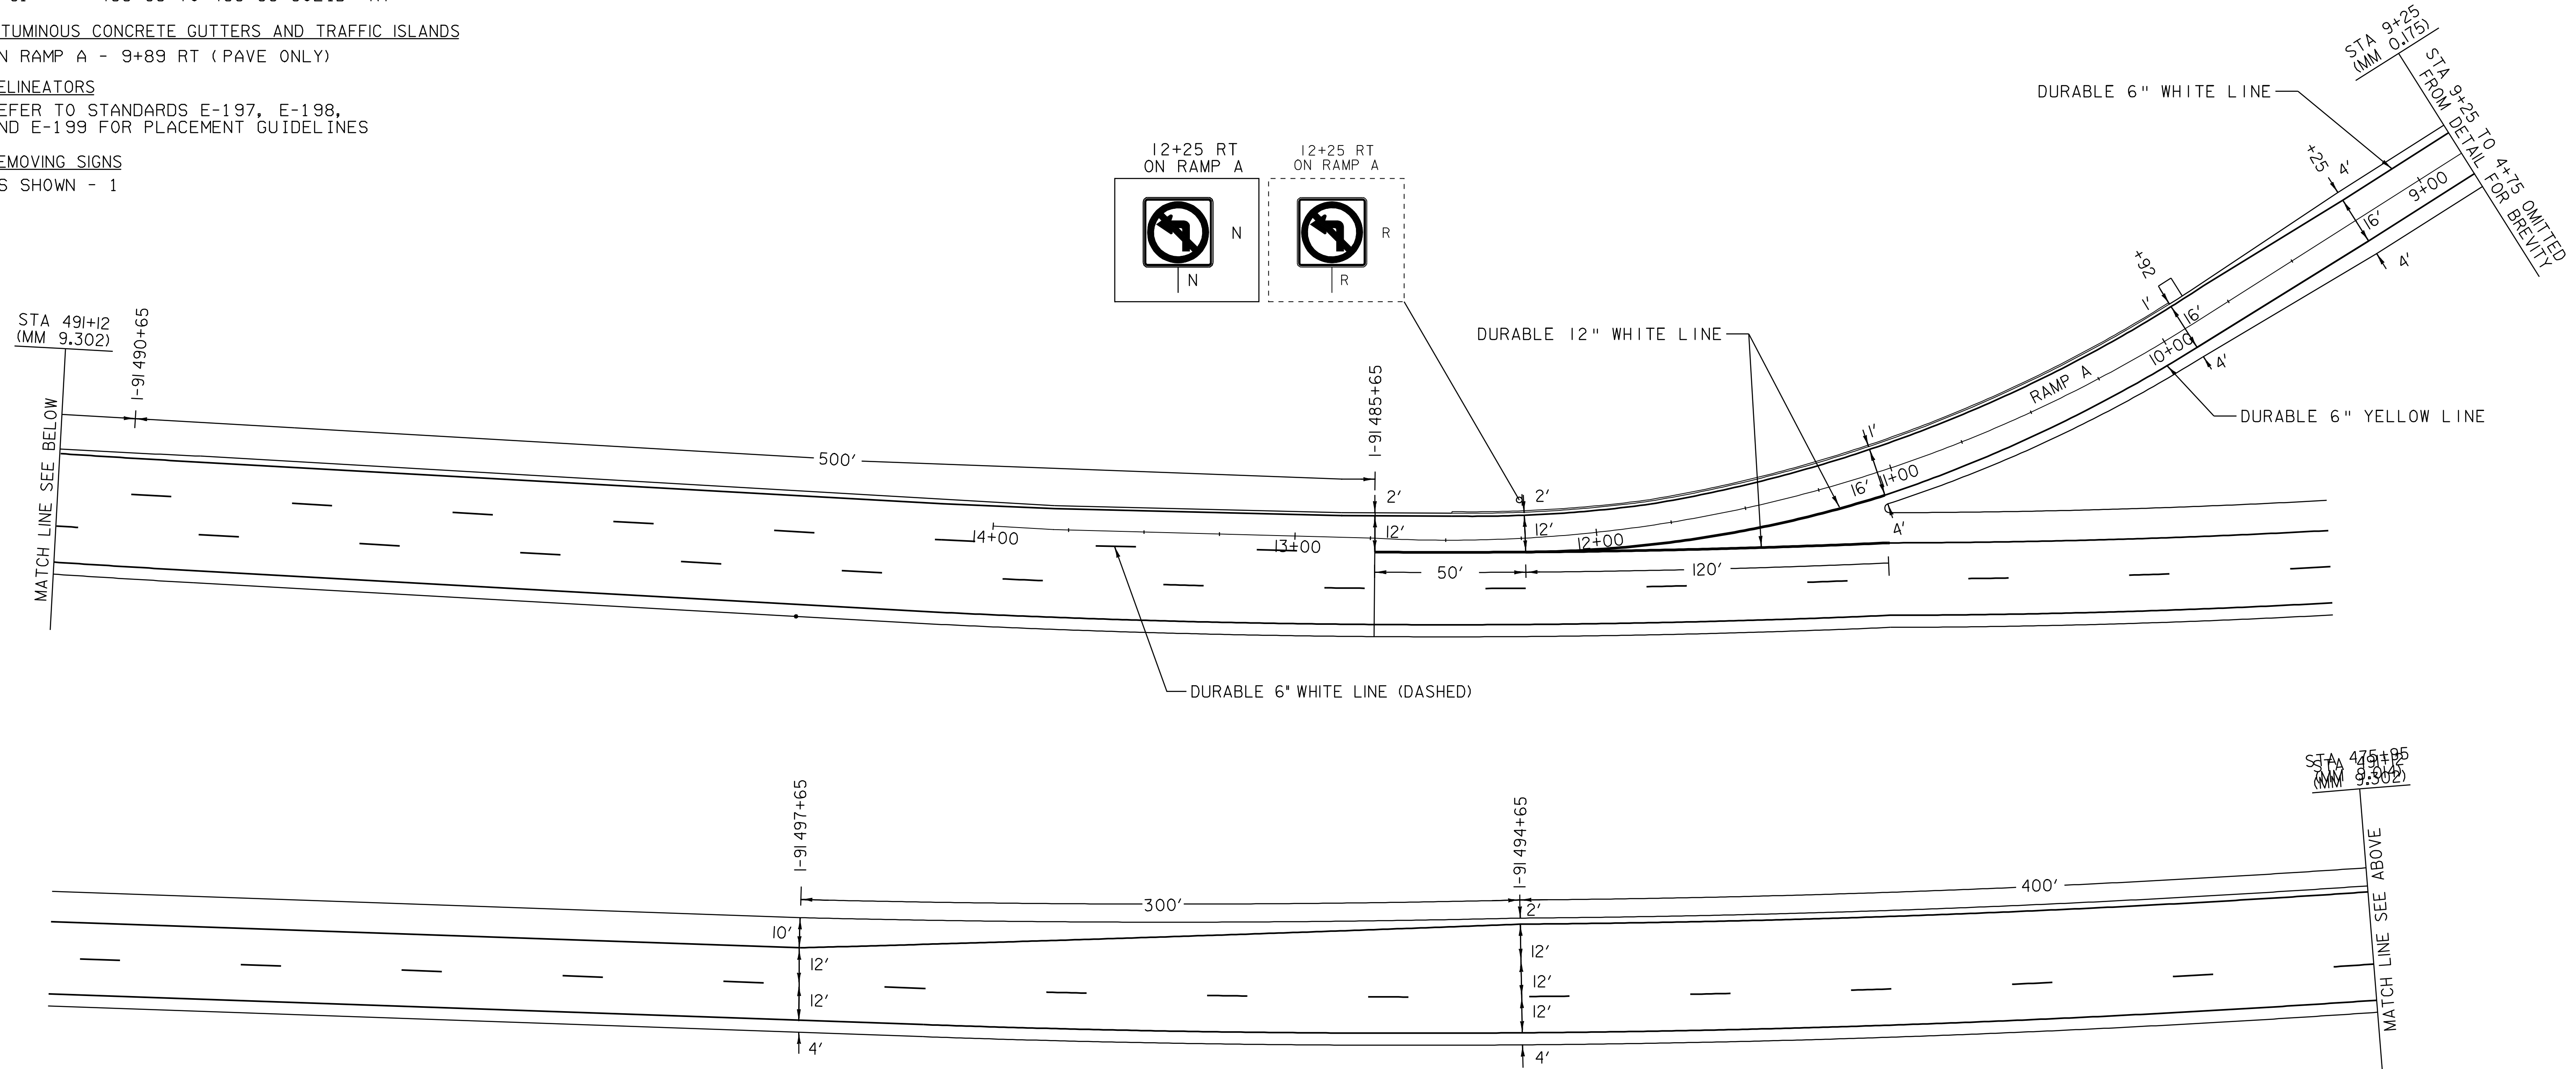

- LEGEND**
- R = REMOVE EXISTING
 - S = SALVAGE
 - R & S = REMOVE AND SALVAGE
 - N = NEW
 - RET = RETAIN
 - B-B = BACK TO BACK
 - = NEW RAIL
 - = EXISTING RAIL

NOT TO SCALE

DATUM	
VERTICAL	_____
HORIZONTAL	_____

RAMP DETAIL #5	PROJECT NAME: GUILFORD-BRATTLEBORO	PLOT DATE: 22-JAN-2009 13:3
	PROJECT NUMBER: AC IM 091-1(51)	DRAWN BY: JCS
	FILE NAME: 03A020rmp5.1	CHECKED BY: NLL
	DESIGNED BY: CLD	SHEET 25 OF 69
	CLD REF. NO. 04-0398	