



**OLD WELCOME CENTER
STATION 11+09
(MM 0.21)**

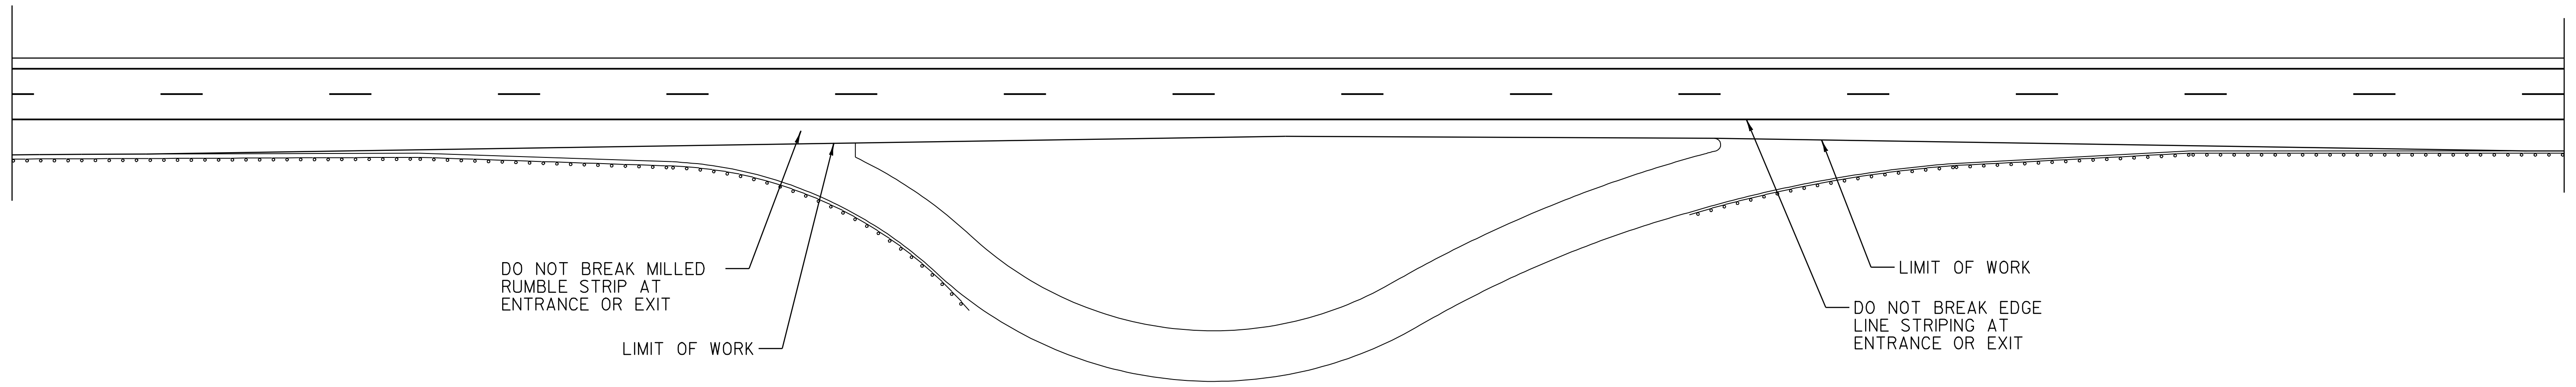

**WEIGH STATION
STATION 59+14
(MM 1.12)**

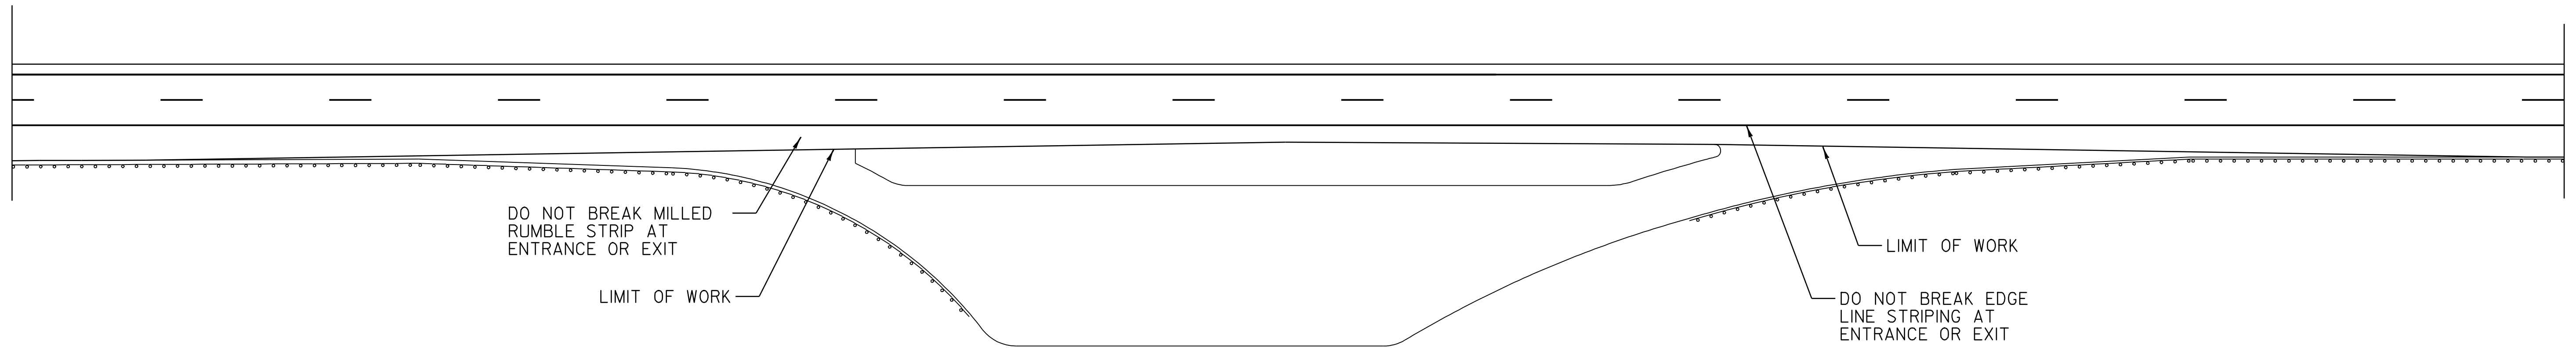

DATUM
VERTICAL _____
HORIZONTAL _____

NOT TO SCALE

**WEIGH STATION
AND
WELCOME CENTER
DETAILS**

PROJECT NAME: GUILFORD-BRATTLEBORO
PROJECT NUMBER: AC IM 09I-1(5I)

FILE NAME: 03A020rmp8.1
PROJECT LEADER: CRB
DESIGNED BY: CLD
CLD REF. NO. 04-0398

PLOT DATE: 22-JAN-2009 13:3
DRAWN BY: NLL
CHECKED BY:
SHEET 28 OF 69