


TEMPORARY AND DURABLE 6" WHITE LINE

I-91 285+15 TO 290+65 DOTTED RT
 I-91 290+65 TO 293+15 DASHED RT
 I-91 307+20 TO 309+55 DASHED RT

TEMPORARY AND DURABLE 12" WHITE LINE

I-91 293+15 TO 294+55 SOLID RT
 I-91 293+65 TO 294+55 SOLID RT
 GORE STRIP 293+65 TO 294+55 SOLID RT
 I-91 305+00 TO 306+10 SOLID RT
 I-91 305+00 TO 307+20 SOLID RT

**NEW WELCOME CENTER
 STATION 285+12
 (MM 5.40)**

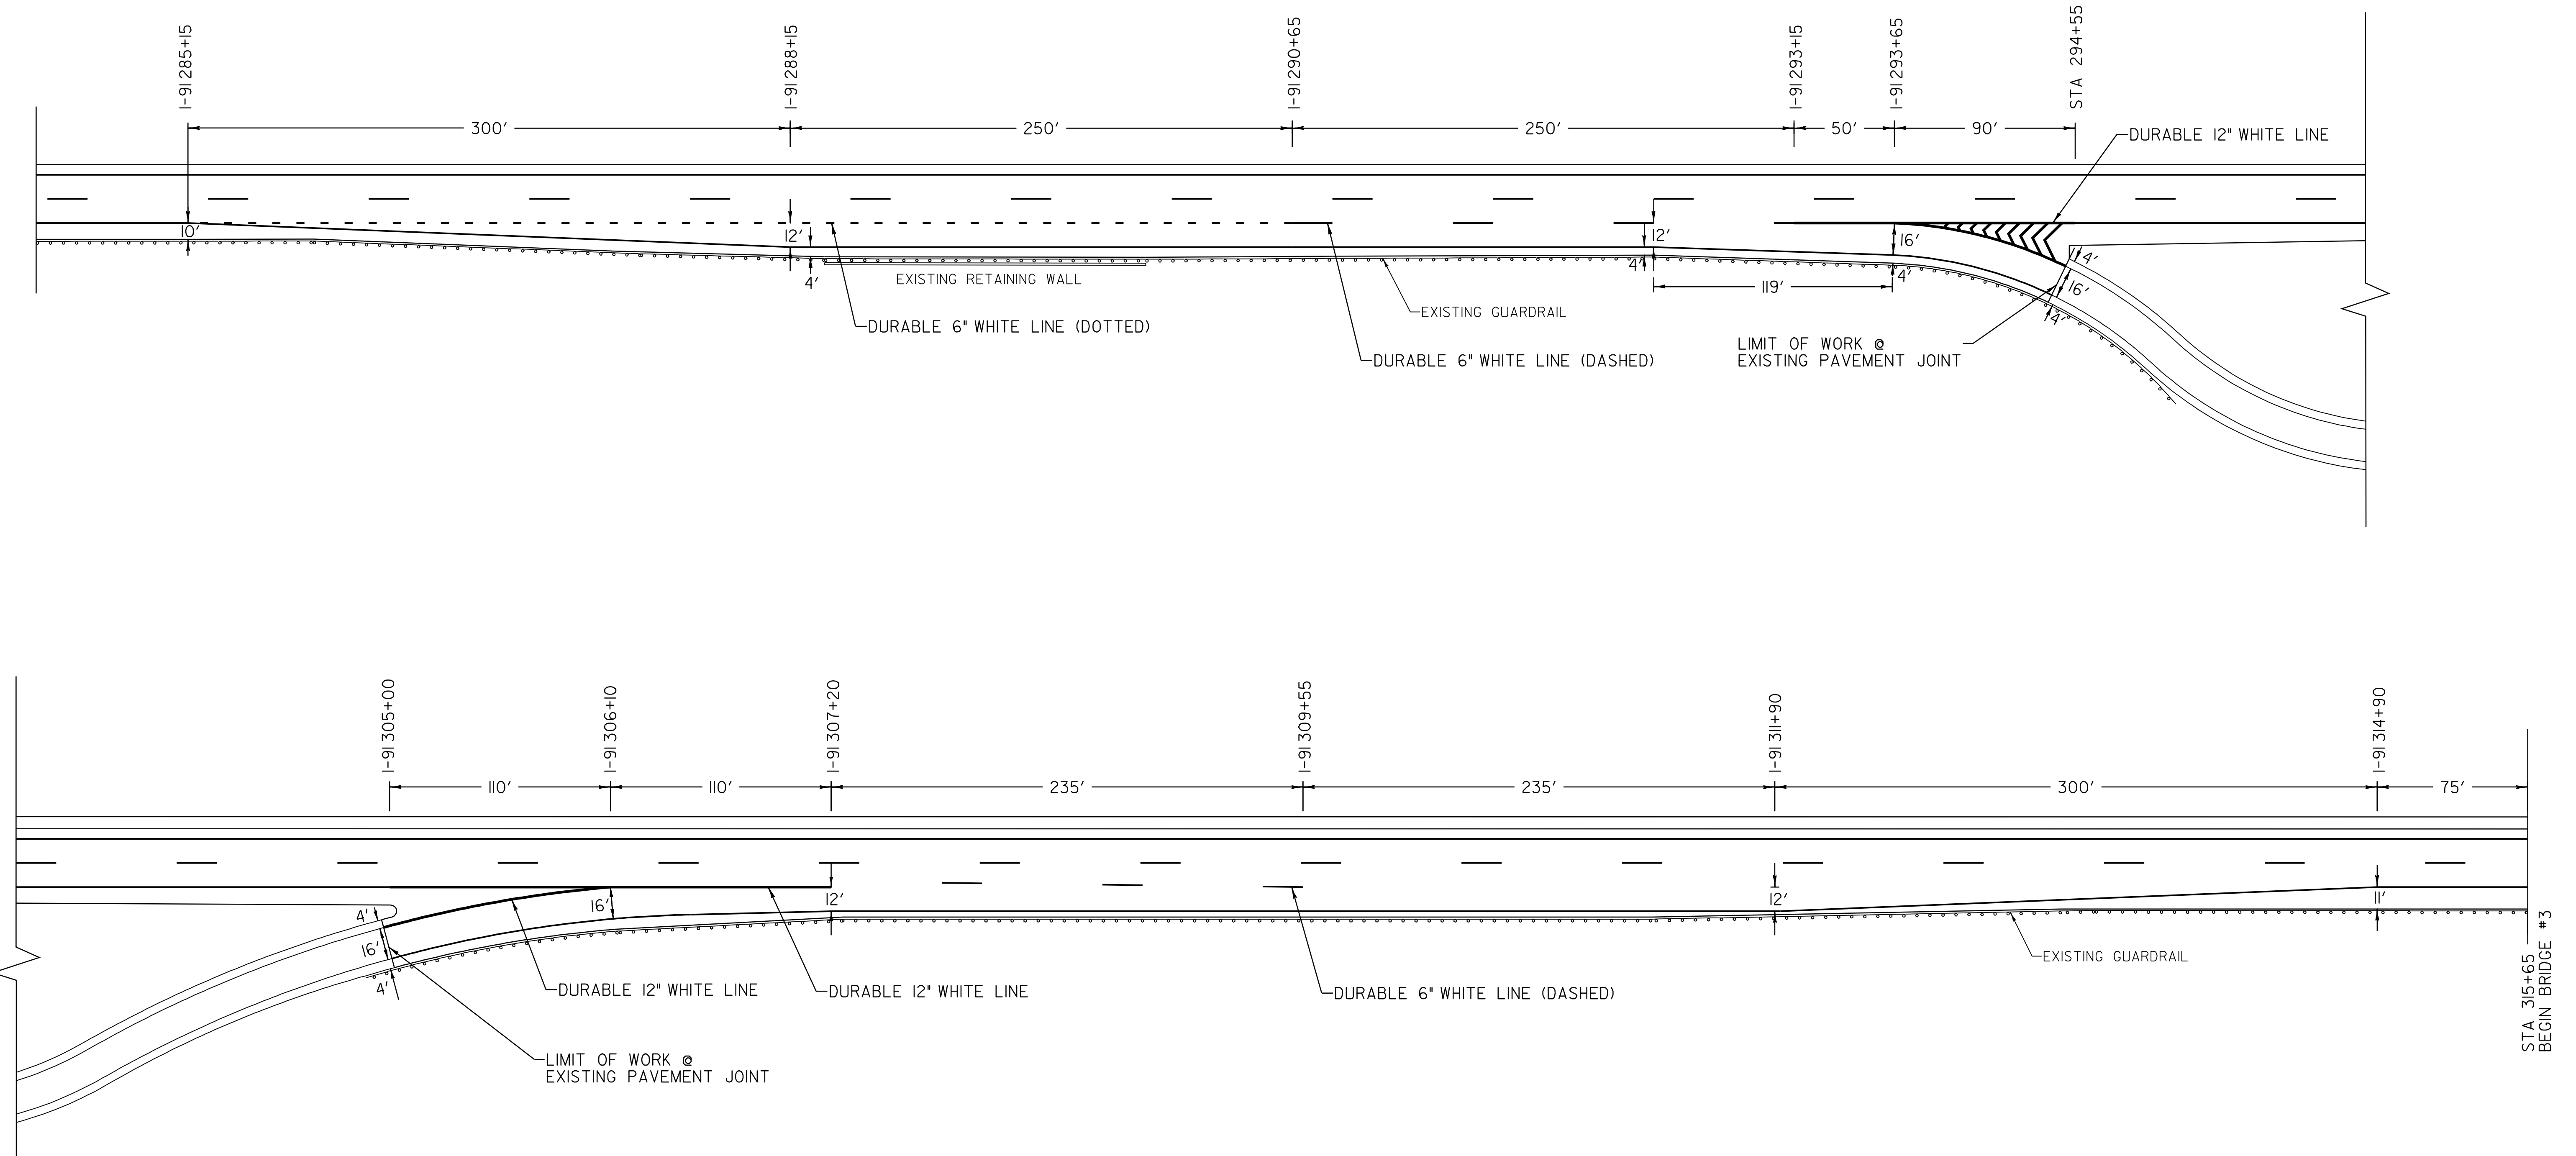

DATUM	_____
VERTICAL	_____
HORIZONTAL	_____

NOT TO SCALE

**WELCOME
 CENTER
 DETAILS**

PROJECT NAME: GUILFORD-BRATTLEBORO
 PROJECT NUMBER: AC IM 091-1(51)

FILE NAME: 03A020rmp9.1
 PROJECT LEADER: CRB
 DESIGNED BY: CLD
 CLD REF. NO. 04-0398

PLOT DATE: 22-JAN-2009 13:3
 DRAWN BY: NLL
 CHECKED BY:
 SHEET 29 OF 69