

TEMPORARY AND DURABLE 6" WHITE LINE
 STA 0+00 TO 448+80 SOLID LT
 STA 0+00 TO 448+80 DASHED CL
 TEMPORARY AND DURABLE 6" YELLOW LINE
 STA 0+00 TO 448+80 SOLID RT

REMOVAL & DISP. OF GUARDRAIL
 STA 07+78 TO 13+85 RT
 STA 212+95 TO 213+20 LT
 STA 249+47 TO 249+72 LT
 STA 258+29 TO 258+54 RT
 STA 276+96 TO 281+19 RT
 STA 275+64 TO 275+89 LT
 STA 277+17 TO 284+20 LT
 STA 310+52 TO 310+77 LT
 STA 330+92 TO 344+40 LT
 STA 424+63 TO 424+88 RT
 STA 431+39 TO 431+64 LT
 STA 433+19 TO 442+70 RT
 STA 445+50 TO 450+51 LT

STEEL BEAM GUARDRAIL (GALV.)
 STA 07+94 TO 13+44 LT
 STA 213+07.5 TO 213+20 LT
 STA 249+59.5 TO 249+72 LT
 STA 258+41.5 TO 258+54 RT
 STA 275+76.5 TO 275+89 LT
 STA 277+46 TO 280+83.5 RT
 STA 277+67 TO 283+79.5 LT
 STA 310+64.5 TO 310+77 LT
 STA 331+02.5 TO 344+02.5 LT
 STA 424+75.5 TO 424+88 RT
 STA 431+51.5 TO 431+64 LT
 STA 433+69 TO 442+31.5 RT
 STA 445+63.5 TO 450+26 LT

H.D. STEEL BEAM GUARDRAIL (GALV.)
 STA 276+96 TO 277+46 RT
 STA 277+17 TO 277+67 LT
 STA 433+19 TO 433+69 RT
 TRAILING END TERMINAL (TET)
 STA 7+81.5 TO 7+94 LT
 STA 212+95 TO 213+07.5 LT
 STA 249+47 TO 249+59.5 LT
 STA 258+29 TO 258+41.5 RT
 STA 275+64 TO 275+76.5 LT
 STA 310+52 TO 310+64.5 LT
 STA 330+90 TO 331+02.5 LT
 STA 424+63 TO 424+75.5 RT
 STA 431+39 TO 431+51.5 RT
 STA 445+51 TO 445+63.5 LT


MANUFACTURED TERMINAL SECTION (MTS)
 STA 13+44 TO 13+81.5 LT (FLARED)
 STA 280+83.5 TO 281+21 RT (FLARED)
 STA 283+79.5 TO 284+17 LT (FLARED)
 STA 344+02.5 TO 344+40 LT (FLARED)
 STA 442+31.5 TO 442+69 RT (FLARED)
 SNOW BARRIER - GALVANIZED
 BRIDGE #1 (OVERPASS) 65 FT EACH SIDE

TRAFFIC SIGNS, TYPE A
 STA 0+00 RT NO U-TURN
 STA 0+00 LT MM PLAQUE (0.00)
 STA 4+75 RT NO U-TURN
 STA 52+80 LT MM PLAQUE (1.00)
 STA 102+43 RT NO U-TURN
 STA 105+60 LT MM PLAQUE (2.00)
 STA 158+40 LT MM PLAQUE (3.00)
 STA 211+20 LT MM PLAQUE (4.00)
 STA 221+23 RT NO U-TURN
 STA 264+00 LT MM PLAQUE (5.00)
 STA 307+30 RT NO U-TURN
 STA 316+80 LT MM PLAQUE (6.00)
 STA 348+48 RT NO U-TURN
 STA 369+60 LT MM PLAQUE (7.00)
 STA 419+76 RT NO U-TURN
 STA 422+40 LT MM PLAQUE (8.00)

INTERSTATE ROUTE 91 SB
STA 0+00
(MM 0.000)
BEGIN PROJECT
AC IM 091-1 (54)

REMOVING SIGNS
 STA 0+00 RT NO U-TURN
 STA 0+00 LT MM PLAQUE (0.00)
 STA 4+75 RT NO U-TURN
 STA 52+80 LT MM PLAQUE (1.00)
 STA 102+43 RT NO U-TURN
 STA 105+60 LT MM PLAQUE (2.00)
 STA 158+40 LT MM PLAQUE (3.00)
 STA 211+20 LT MM PLAQUE (4.00)
 STA 221+23 RT NO U-TURN
 STA 264+00 LT MM PLAQUE (5.00)
 STA 307+30 RT NO U-TURN
 STA 316+80 LT MM PLAQUE (6.00)
 STA 348+48 RT NO U-TURN
 STA 369+60 LT MM PLAQUE (7.00)
 STA 419+76 RT NO U-TURN
 STA 422+40 LT MM PLAQUE (8.00)

DELINEATORS
 REFER TO STANDARDS E-197, E-198
 AND E-199 FOR PLACEMENT GUIDELINES

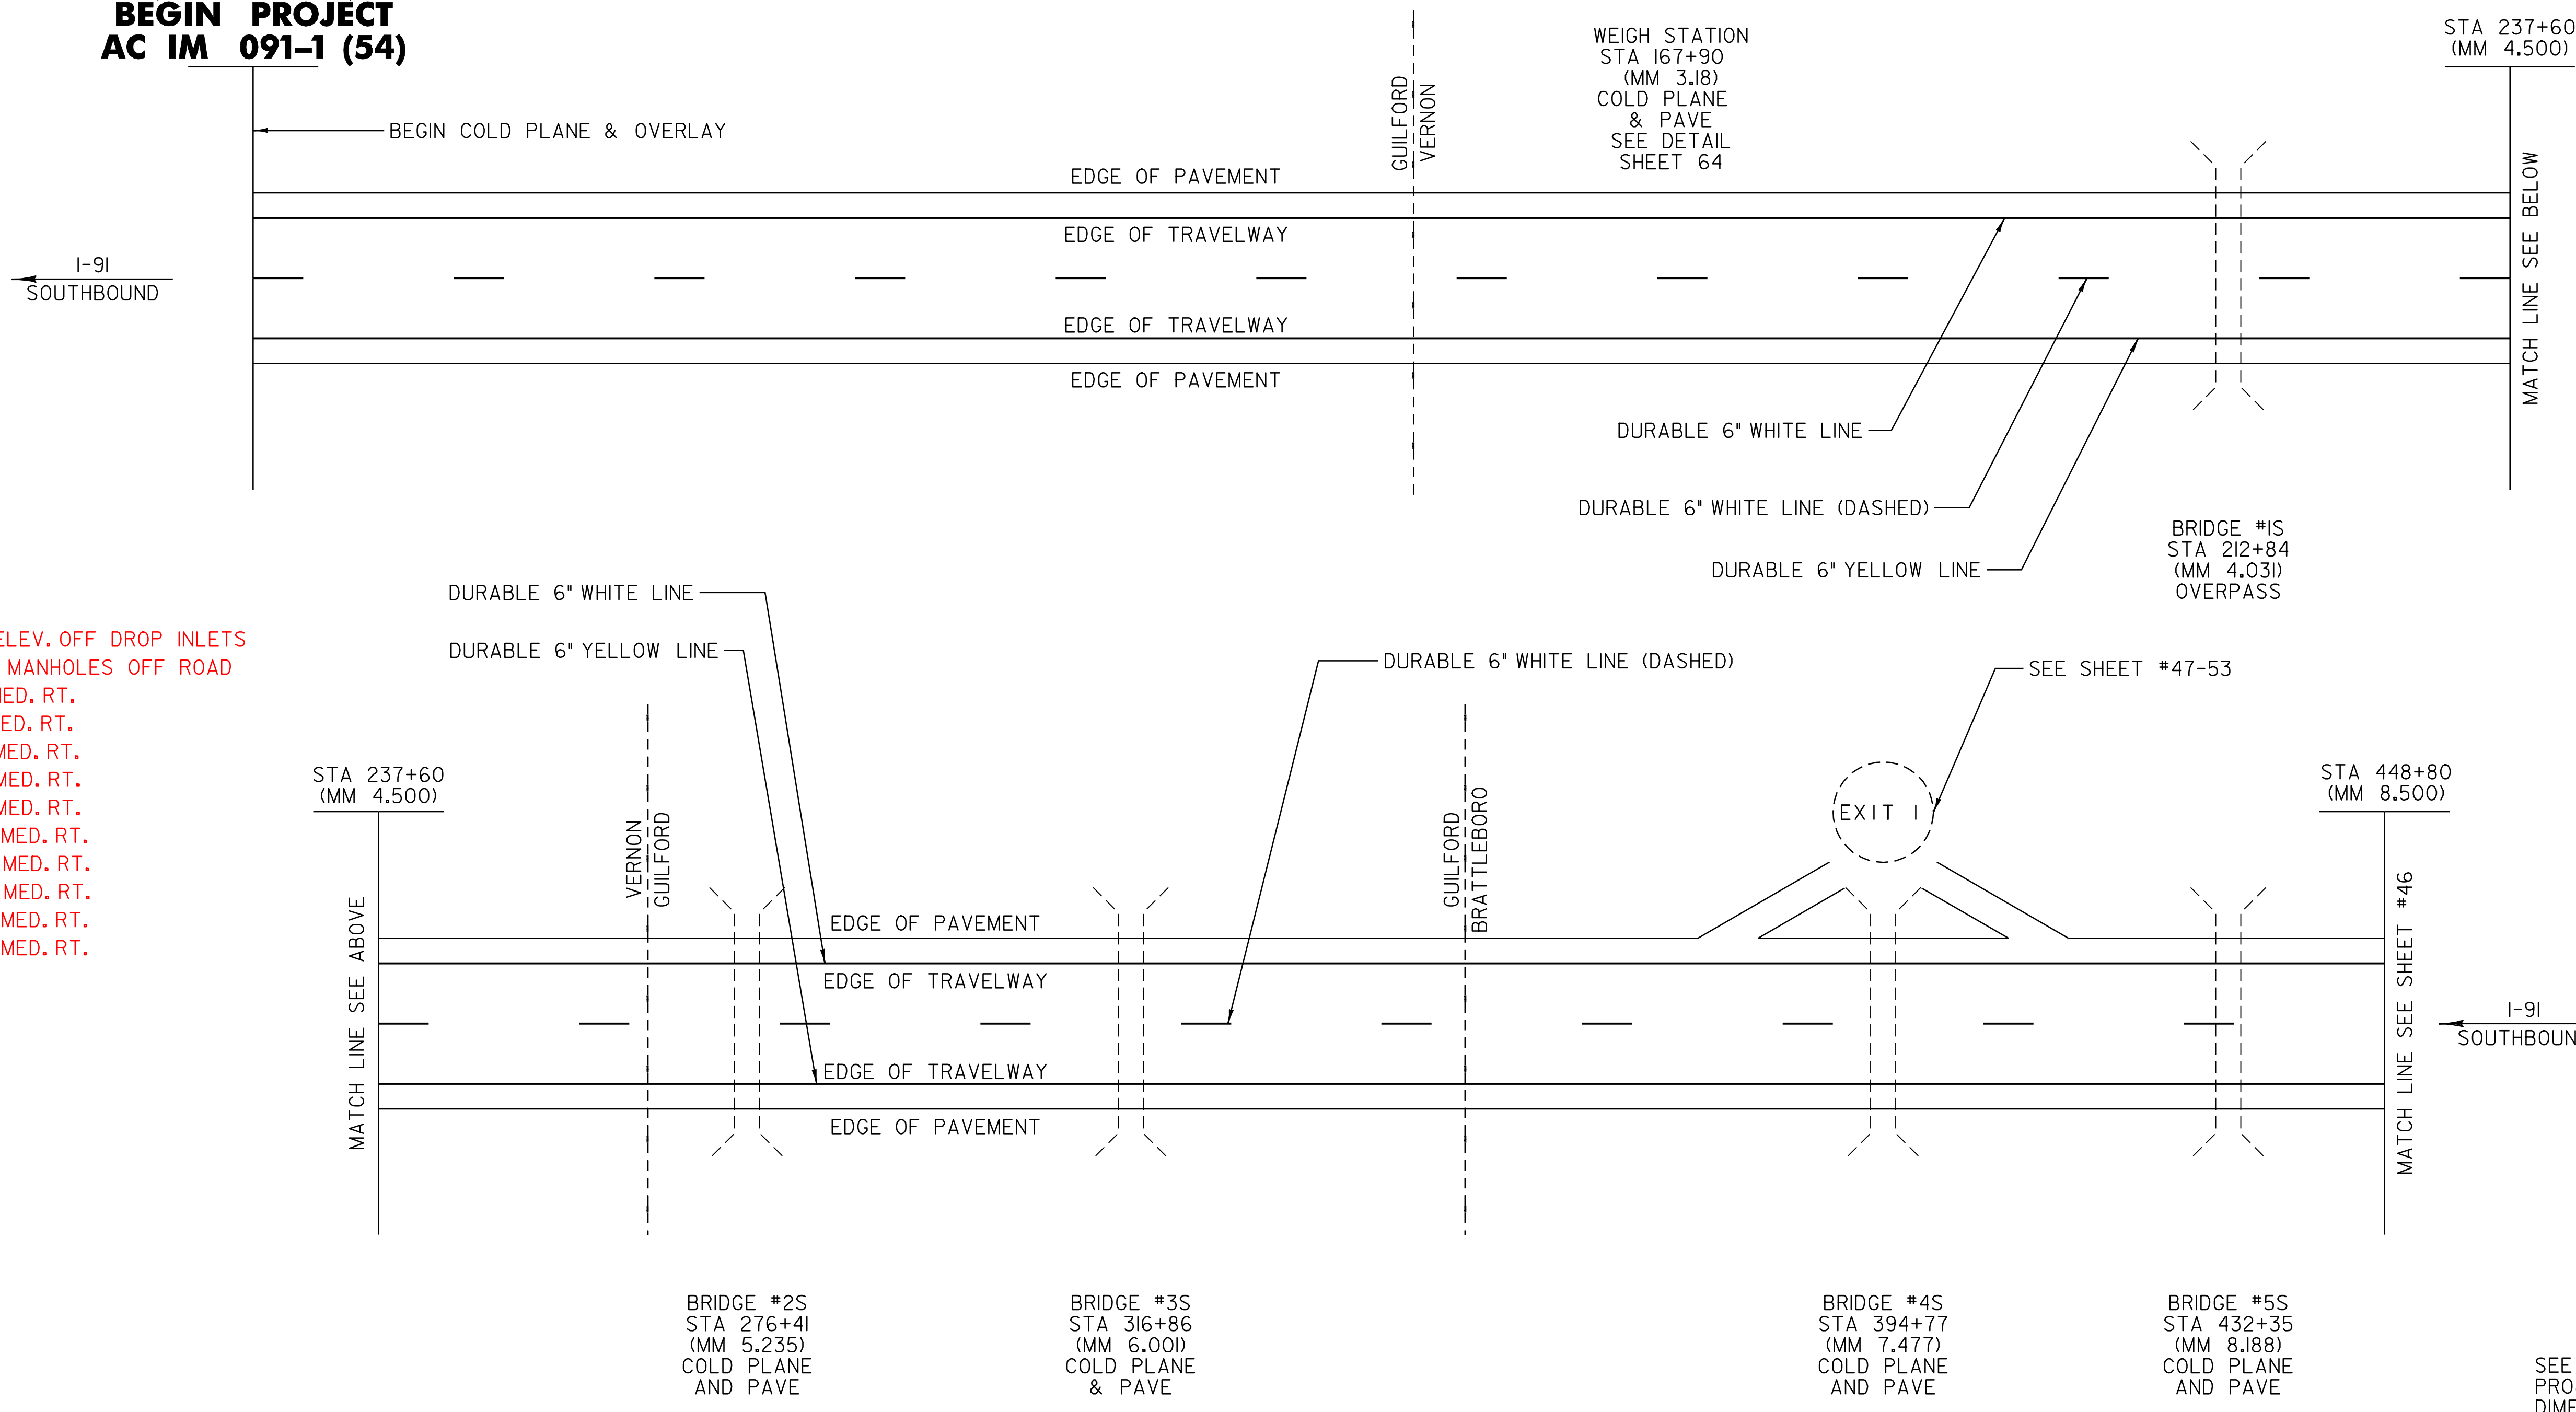

604.40 CHANGE ELEV. OFF DROP INLETS
 CATCH BASINS, + MANHOLES OFF ROAD
 SB STA 52+09 MED. RT.
 SB STA 100+12 MED. RT.
 SB STA 146+54 MED. RT.
 SB STA 162+46 MED. RT.
 SB STA 168+96 MED. RT.
 SB STA 238+96 MED. RT.
 SB STA 250+80 MED. RT.
 SB STA 264+00 MED. RT.
 SB STA 287+76 MED. RT.
 SB STA 445+56 MED. RT.

604.412 REHAB DI CB + MH CLASS I OFF ROAD
 SB STA 129+96 MEDIAN RT
 SB STA 135+49 MEDIAN RT

SEE PROJECT PAVING LIMITS TABLE ON
 PROJECT TYPICAL SHEET 1 FOR ROADWAY
 DIMENSIONS.

DATUM	
VERTICAL	_____
HORIZONTAL	_____

NOT TO SCALE

PAVING PROJECT LAYOUT #1	PROJECT NAME: GUILFORD-BRATTLEBORO
	PROJECT NUMBER: AC IM 091-1(54)
FILE NAME: 05A0141s01.i	PLOT DATE: 22-JAN-2009 13:4
PROJECT LEADER: CRB	DRAWN BY: MRS
DESIGNED BY: CLD	CHECKED BY: NLL
CLD REF. NO. 05-0387	SHEET 45 OF 69