

TEMPORARY AND DURABLE 6" WHITE LINE
 STA 448+80 TO 629+38 SOLID LT
 STA 448+80 TO 629+38 DASHED CL
 TEMPORARY AND DURABLE 6" YELLOW LINE
 STA 448+80 TO 629+38 SOLID RT

CHANGING ELEV. OF DROP INLET,
 CATCH BASIN, MANHOLE
~~STA 459+98 LT~~
~~STA 461+94 LT~~
~~STA 462+94 LT~~
~~STA 464+48 LT~~
~~STA 465+43 LT~~
~~STA 467+01 LT~~
~~STA 552+72 LT~~

REMOVAL & DISP. OF GUARDRAIL
 STA 455+59 TO 462+26 LT
 STA 455+65 TO 457+92 RT
 STA 485+13 TO 487+63 LT
 STA 593+70 TO 595+98 LT
 STA 606+65 TO 606+90 LT

STEEL BEAM GUARDRAIL (GALV.)
 STA 456+09 TO 462+21.5 LT
 STA 456+15 TO 457+52.5 RT
 STA 485+13 TO 487+25.5 LT
 STA 593+80.5 TO 598+43 LT
 STA 606+77.5 TO 606+90 LT

H.D. STEEL BEAM GUARDRAIL (GALV.)
 STA 450+26 TO 450+51 LT
 STA 455+59 TO 456+09 LT
 STA 455+65 TO 456+15 RT
 TRAILING END TERMINAL (TET)
 STA 593+98 TO 593+80.5 LT


MANUFACTURED TERMINAL SECTION (MTS)
 STA 457+52.5 TO 457+90 RT (FLARED)
 STA 487+25.5 TO 487+63 LT (FLARED)
 STA 598+43 TO 598+80.5 LT (FLARED)
 ANCHOR
 STA 462+21.5 LT (BURIED END)
 SNOW BARRIER - GALVANIZED
 BRIDGE #7 (OVERPASS) 65 FT EACH SIDE
 BRIDGE #10 (OVERPASS) 65 FT EACH SIDE

TRAFFIC SIGNS, TYPE A
 STA 463+06 RT NO U-TURN
 STA 475+20 LT MM PLAQUE (9.00)
 STA 498+96 RT NO U-TURN
 STA 528+00 LT MM PLAQUE (10.00)
 STA 580+80 LT MM PLAQUE (11.00)
 STA 591+36 RT NO U-TURN
 STA 628+32 RT NO U-TURN

REMOVING SIGNS
 STA 463+06 RT NO U-TURN
 STA 475+20 LT MM PLAQUE (9.00)
 STA 498+96 RT NO U-TURN
 STA 528+00 LT MM PLAQUE (10.00)
 STA 580+80 LT MM PLAQUE (11.00)
 STA 591+36 RT NO U-TURN
 STA 628+32 RT NO U-TURN

DELINEATORS
 REFER TO STANDARDS E-197, E-198
 AND E-199 FOR PLACEMENT GUIDELINES

604.40 CHANGING ELEV. OF DROP
 INLET, CB, MANHOLE, OFF ROAD
 SB STA 513+29 MED. RT.
 SB STA 599+90 MED. RT.
 SB STA 607+35 MED. RT.

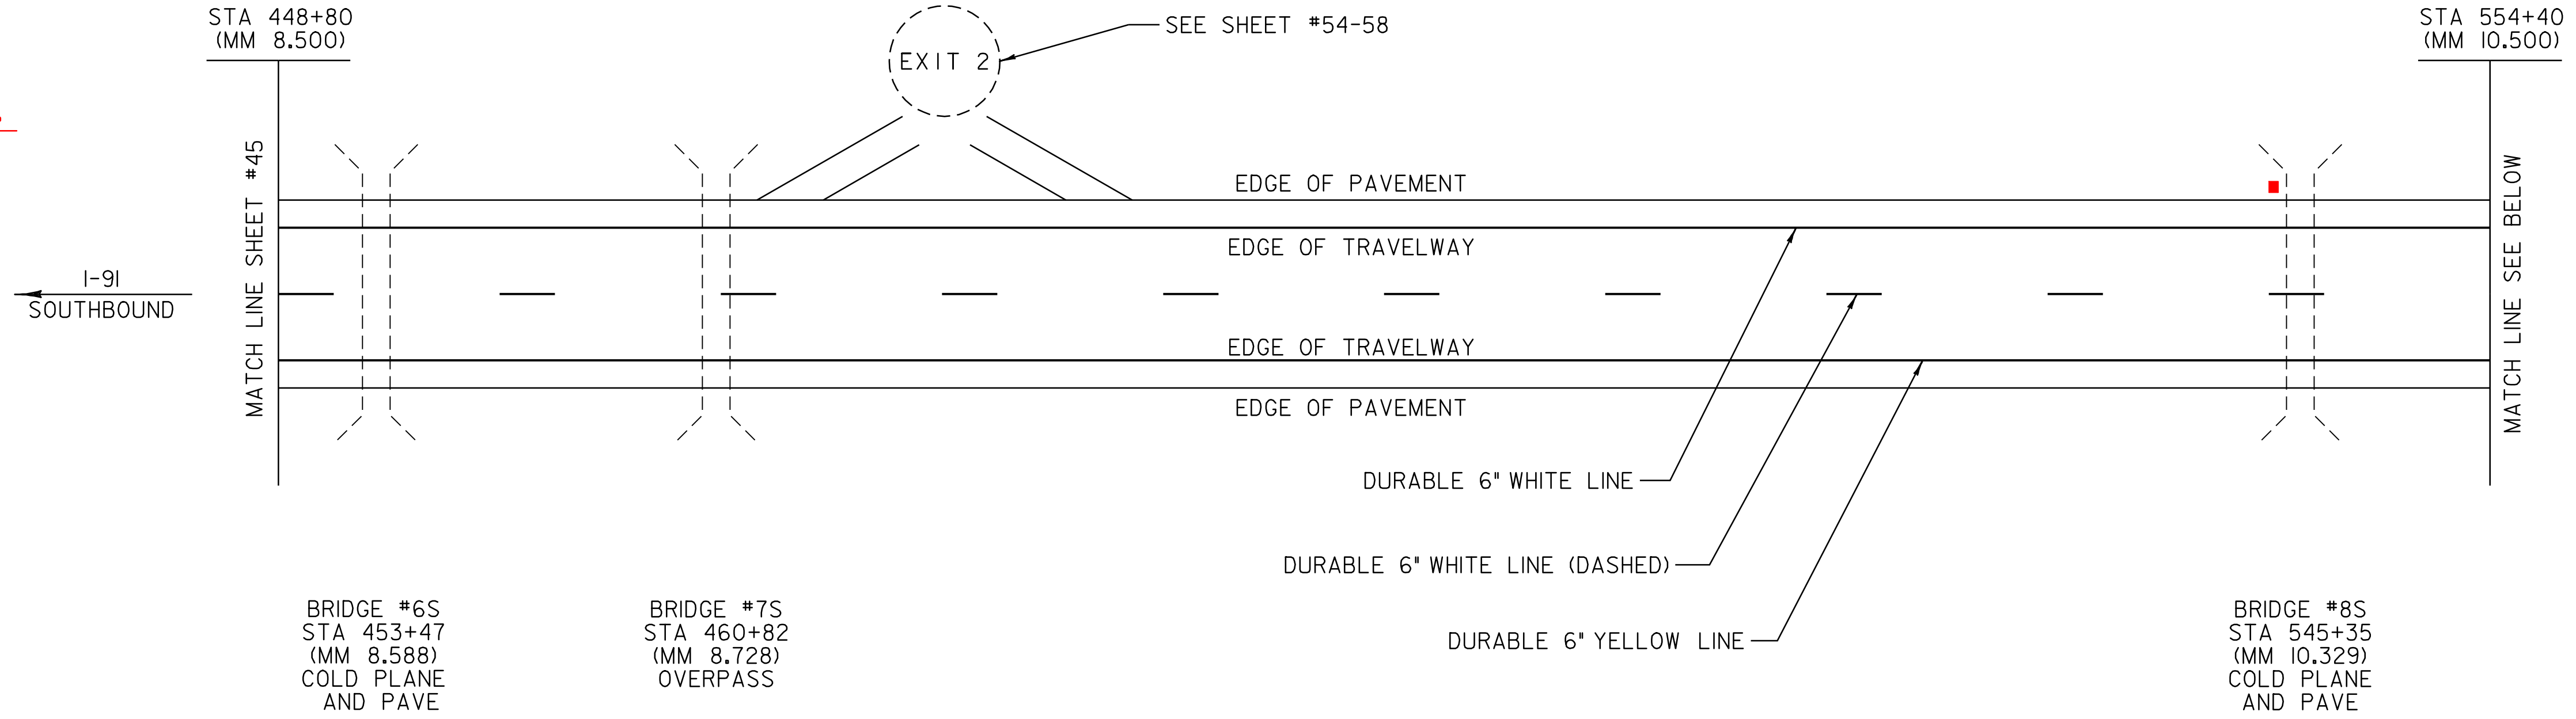


BRIDGE #6S
 STA 453+47
 (MM 8.588)
 COLD PLANE
 AND PAVE

BRIDGE #7S
 STA 460+82
 (MM 8.728)
 OVERPASS

BRIDGE #8S
 STA 545+35
 (MM 10.329)
 COLD PLANE
 AND PAVE

**INTERSTATE ROUTE 91 SB
 STA 629+38
 (MM 11.920)
 END PROJECT
 AC IM 091-1 (54)**

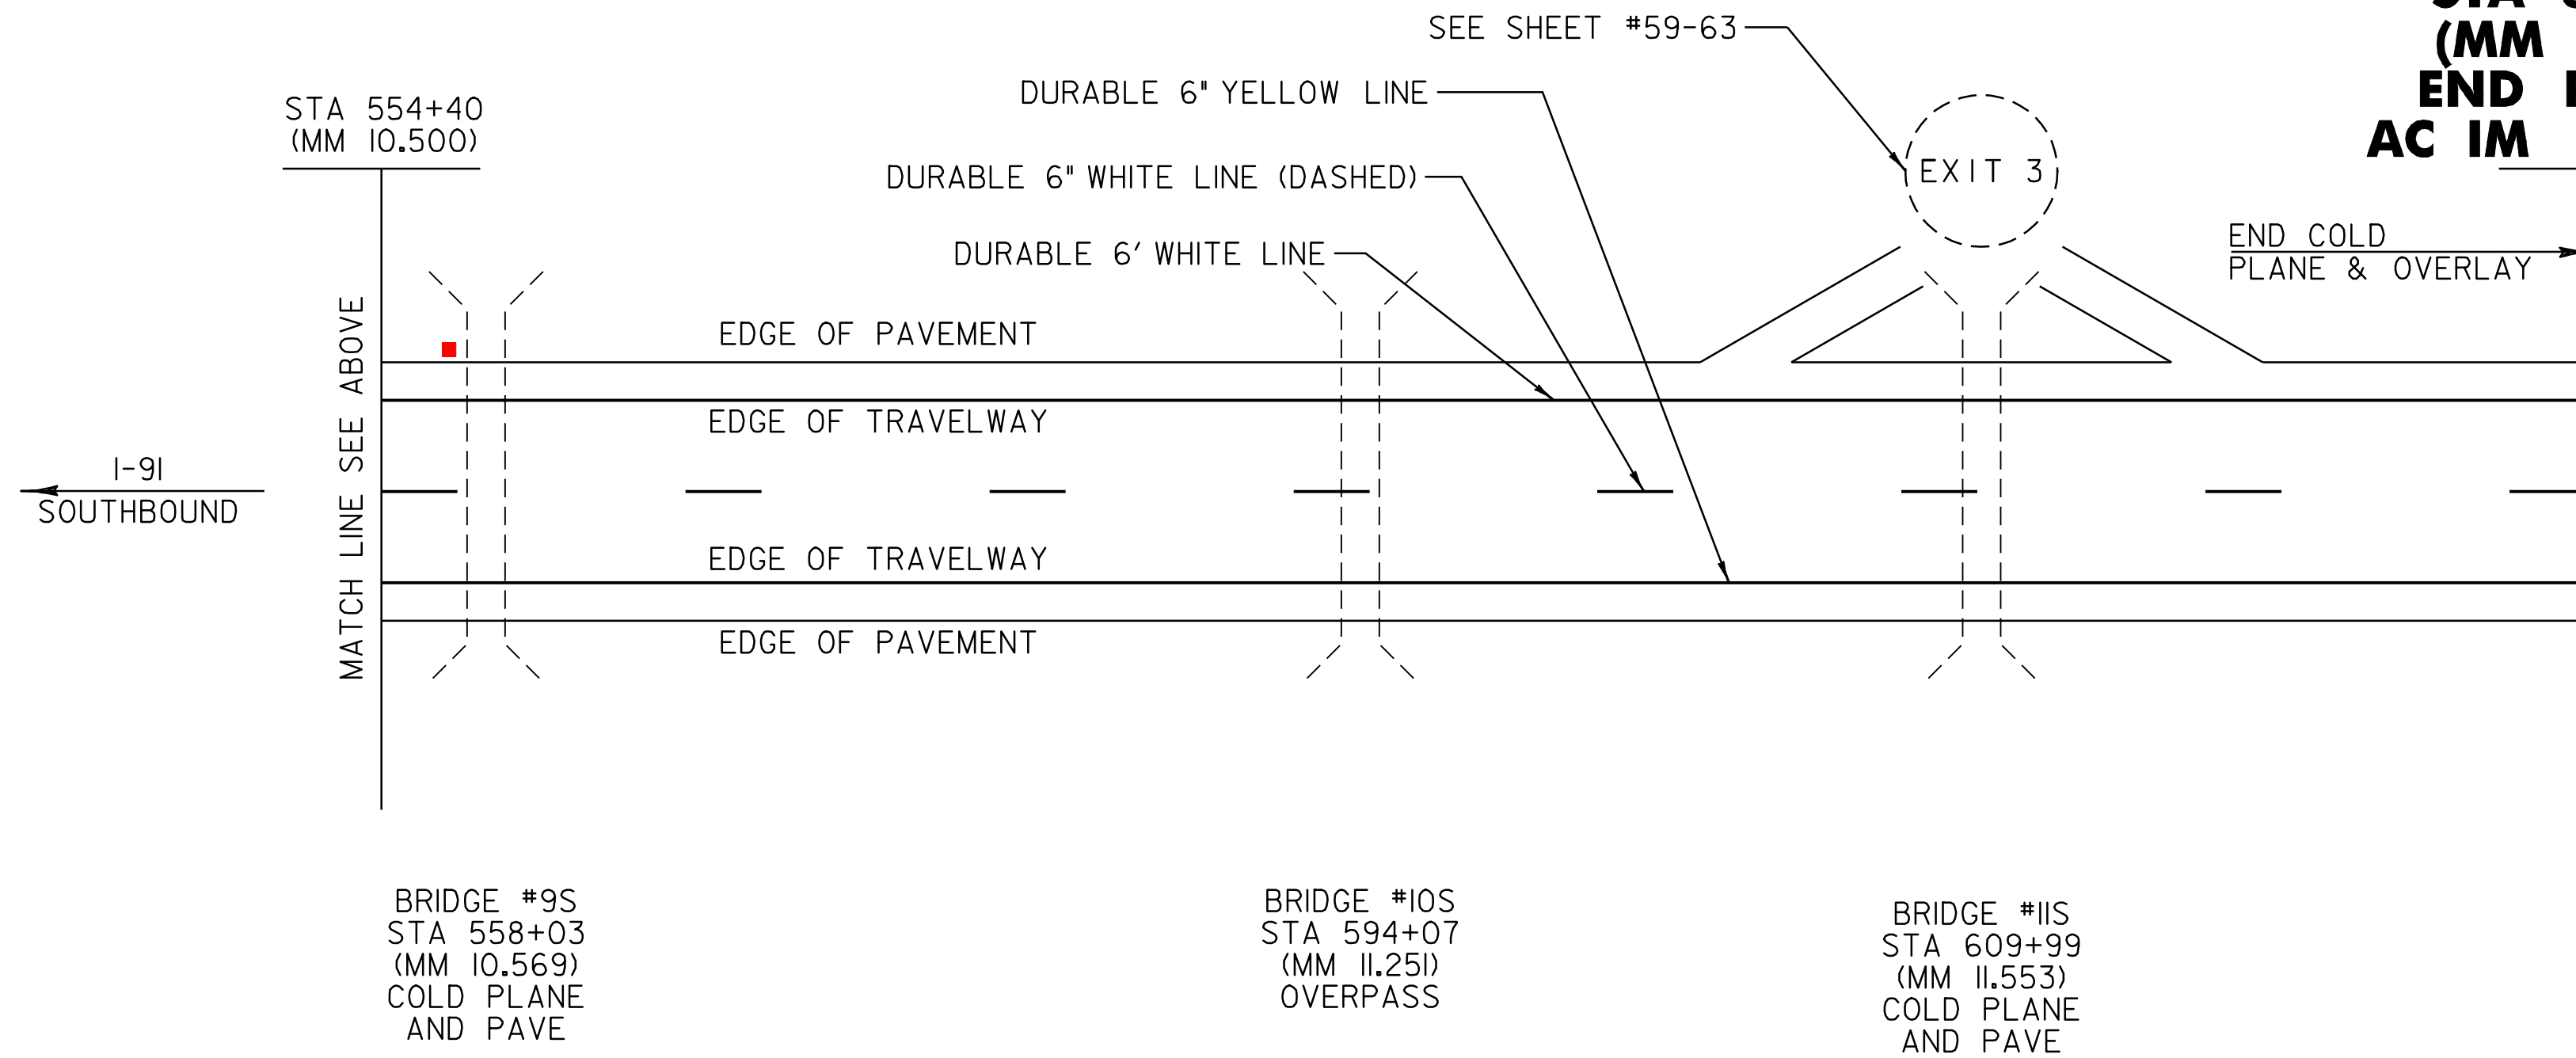

BRIDGE #9S
 STA 558+03
 (MM 10.569)
 COLD PLANE
 AND PAVE

BRIDGE #10S
 STA 594+07
 (MM 11.251)
 OVERPASS

BRIDGE #11S
 STA 609+99
 (MM 11.553)
 COLD PLANE
 AND PAVE

604.412 REHAB DI CB + MH CLASS I

STA 459+98 LT
 STA 461+94 LT
 STA 462+94 LT
 STA 464+48 LT
 STA 475+25 LT
 STA 465+43 LT
 STA 467+01 LT
 STA 467+01 MED. RT OFF ROAD
 STA 451+00 MED. RT OFF ROAD
 STA 552+25 MED. RT OFF ROAD
 @ SOUTH SIDE BR. 8S
 @ SOUTH SIDE BR. 9S

SEE PROJECT PAVING LIMITS TABLE ON
 PROJECT TYPICAL SHEET 1 FOR ROADWAY
 DIMENSIONS.

DATUM	
VERTICAL	_____
HORIZONTAL	_____

NOT TO SCALE

PAVING PROJECT LAYOUT #2	PROJECT NAME: GUILFORD-BRATTLEBORO
	PROJECT NUMBER: AC IM 091-1(54)
	FILE NAME: 05A0141s02.1
	DESIGNED BY: CLD
	PLOT DATE: 22-JAN-2009 13:4
	DRAWN BY: MRS
	CHECKED BY: NULL
	SHEET 46 OF 69