

TEMPORARY AND DURABLE 6" WHITE LINE
ON RAMP 1+48 TO 10+00 SOLID RT
TEMPORARY AND DURABLE 6" YELLOW LINE
ON RAMP 1+48 TO 10+00 SOLID LT
REHABING DI, CB OR MH



ON OFF RAMP 1+58 RT (RAMP A) CLASS I
ON OFF RAMP 3+62 RT (RAMP A) CLASS I
ON OFF RAMP 5+60 RT (RAMP A) CLASS I
ON OFF RAMP 8+09 RT (RAMP A) CLASS I
ON OFF RAMP 9+51 RT (RAMP A) CLASS I

DELINEATORS
REFER TO STANDARDS E-197, E-198
AND E-199 FOR PLACEMENT GUIDELINES

REMOVING SIGNS
AS SHOWN - 3

EXIT 1 - RAMP A SOUTHBOUND ON RAMP

SEE STANDARDS E-191, E-192 AND E-193
FOR PAVEMENT MARKING GUIDELINES

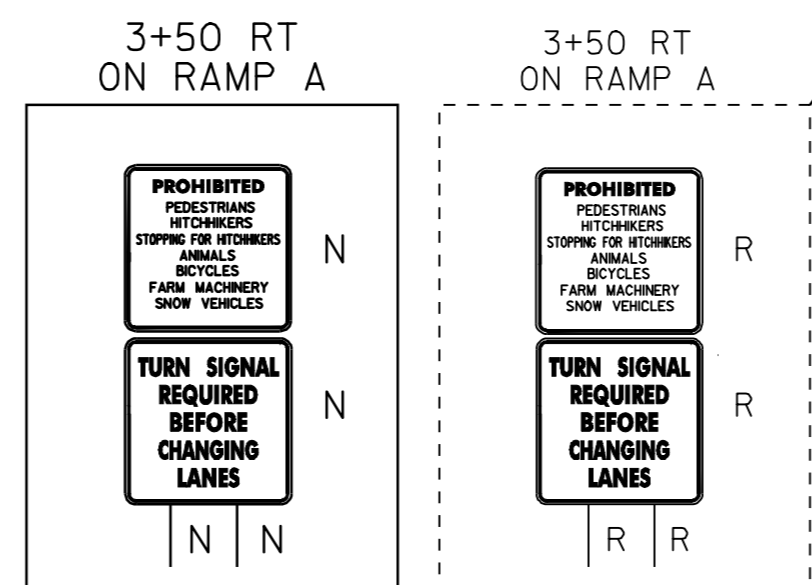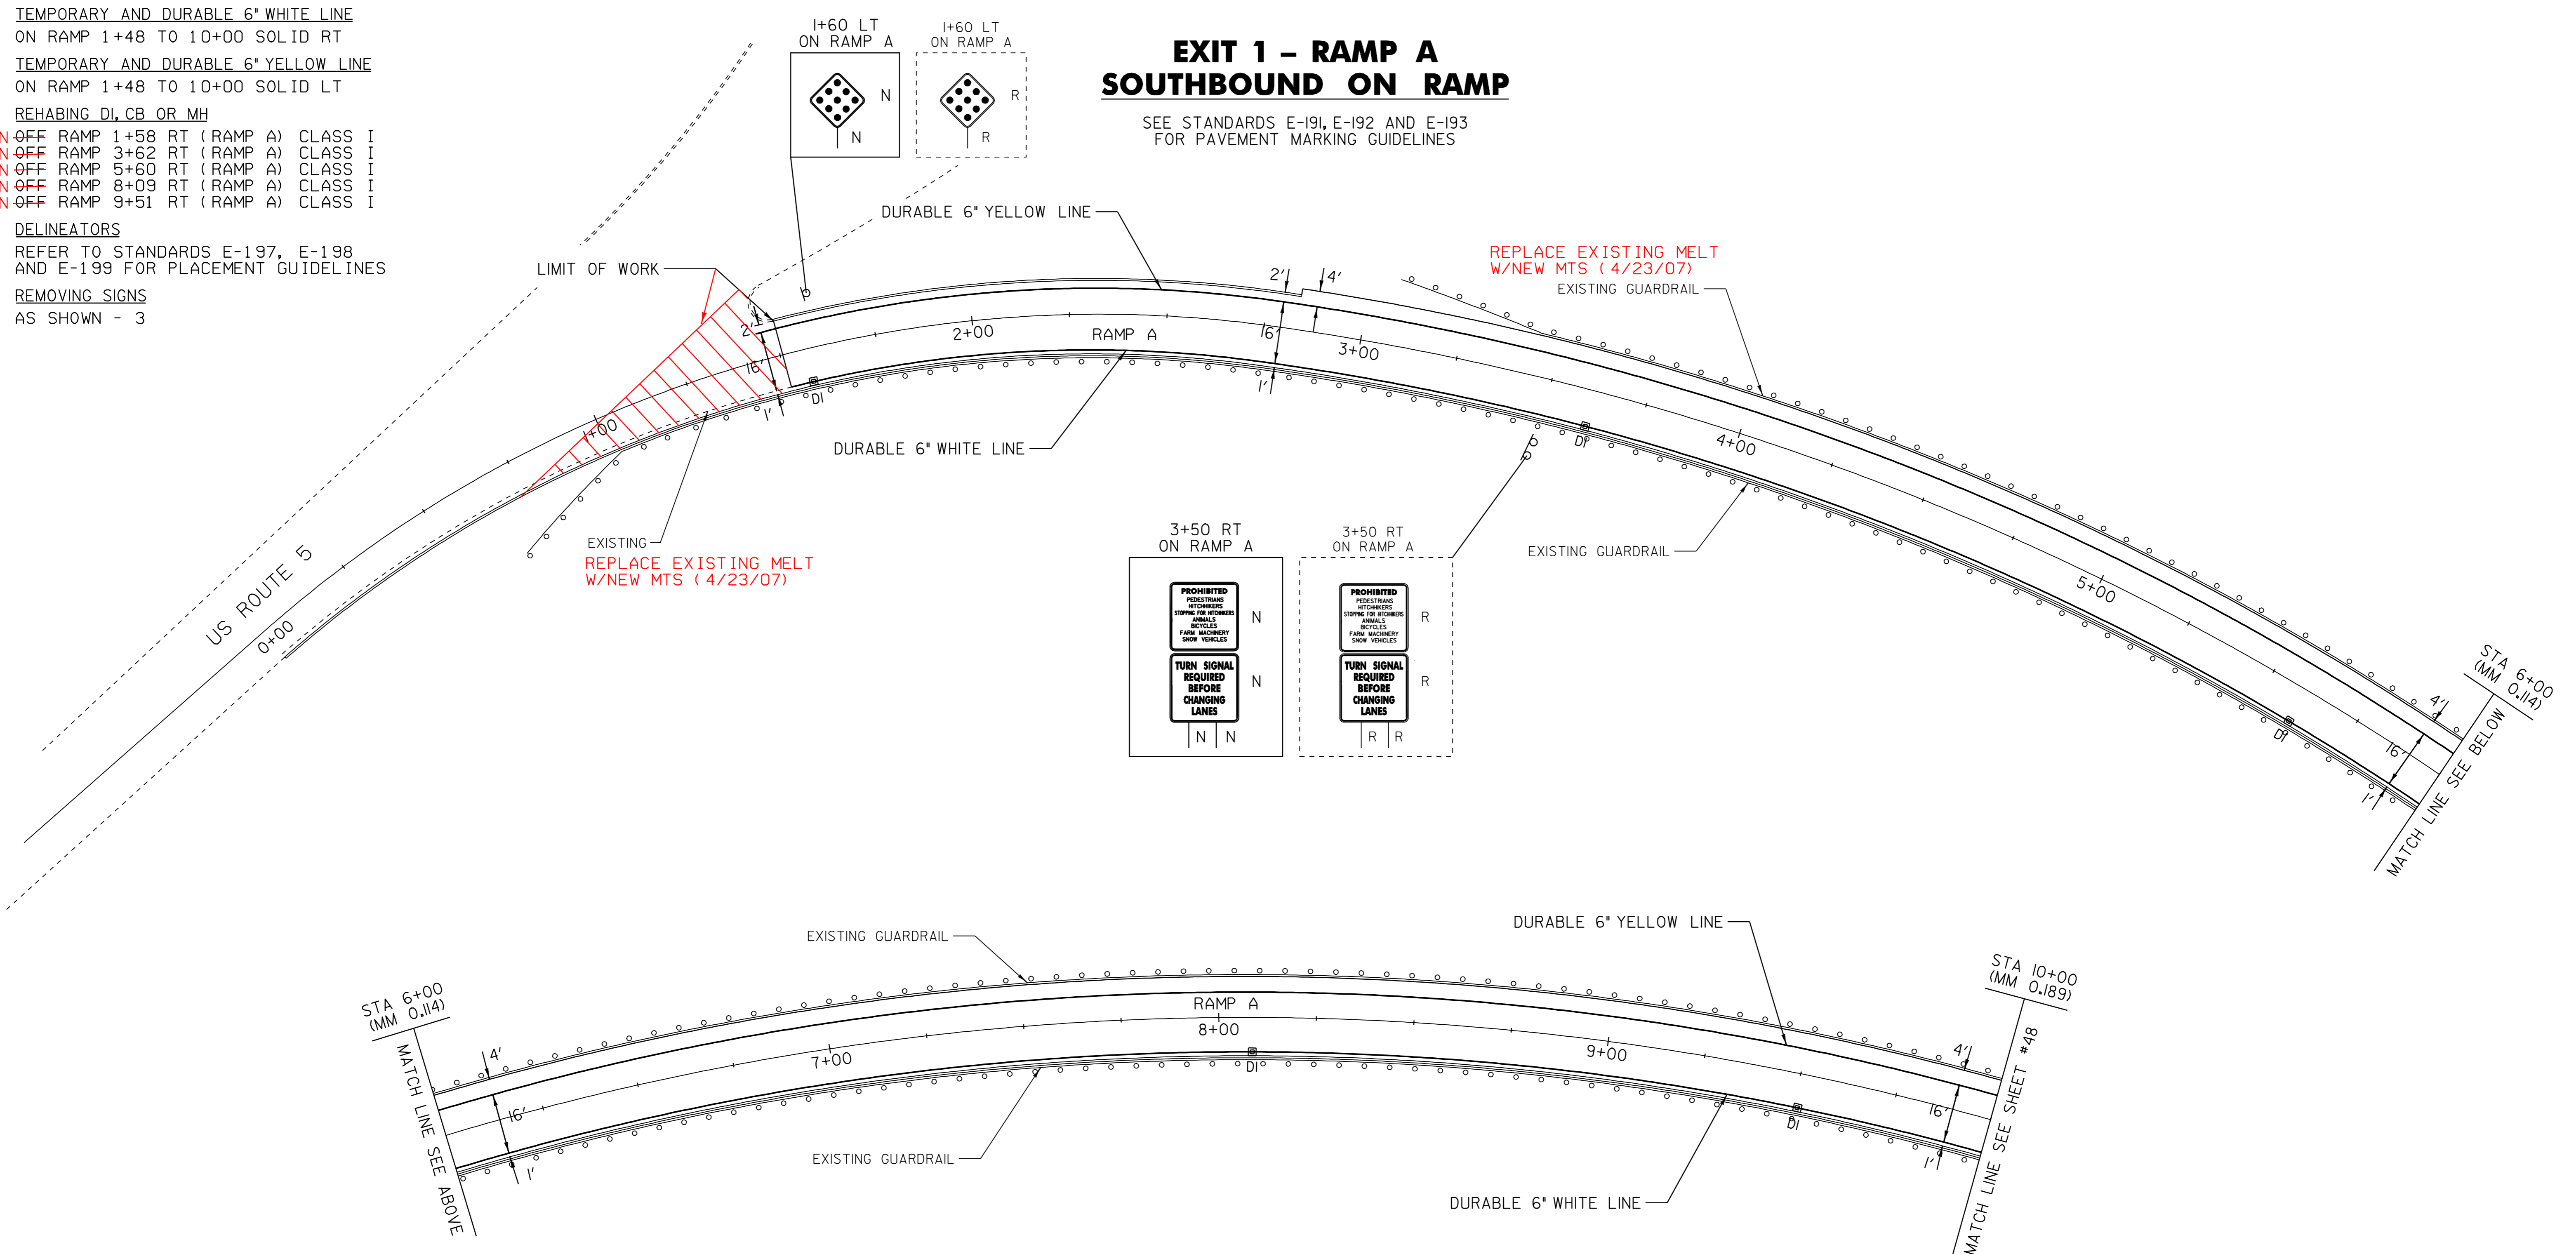

DATUM	
VERTICAL	_____
HORIZONTAL	_____

NOT TO SCALE

LEGEND	
R	= REMOVE EXISTING
S	= SALVAGE
R & S	= REMOVE AND SALVAGE
N	= NEW
RET	= RETAIN
B-B	= BACK TO BACK
○	= NEW RAIL
—○—	= EXISTING RAIL

**RAMP
DETAIL #1**

PROJECT NAME:	GUILFORD-BRATTLEBORO
PROJECT NUMBER:	AC IM 091-1(54)
FILE NAME:	05A014-rd01.I
PROJECT LEADER:	CRB
DESIGNED BY:	CLD
CLD REF. NO.	05-0387
PLOT DATE:	22-JAN-2009 13:40
DRAWN BY:	MRS
CHECKED BY:	NLL
SHEET	47 OF 69