

TEMPORARY AND DURABLE 6" WHITE LINE  
 OFF RAMP 6+00 TO 12+00 SOLID LT (RAMP D)  
 ON RAMP 6+00 TO 12+00 SOLID RT (RAMP C)

TEMPORARY AND DURABLE 6" YELLOW LINE  
 OFF RAMP 6+00 TO 12+00 SOLID LT (RAMP D)  
 ON RAMP 6+00 TO 12+00 SOLID RT (RAMP C)

TEMPORARY AND DURABLE LETTER OR SYMBOL  
 OFF RAMP 6+52 LT - "AHEAD" (RAMP D)  
 OFF RAMP 6+92 LT - "STOP" (RAMP D)


BITUMINOUS CONCRETE GUTTERS AND TRAFFIC ISLANDS  
 OFF RAMP 9+35 LT (PAVE ONLY) (RAMP D)

DELINEATORS  
 REFER TO STANDARDS E-197, E-198  
 AND E-199 FOR PLACEMENT GUIDELINES

REMOVING SIGNS  
 AS SHOWN - 1

### EXIT 2 - RAMP CD SOUTHBOUND ON/OFF RAMP

SEE STANDARDS E-191, E-192 AND E-193  
 FOR PAVEMENT MARKING GUIDELINES

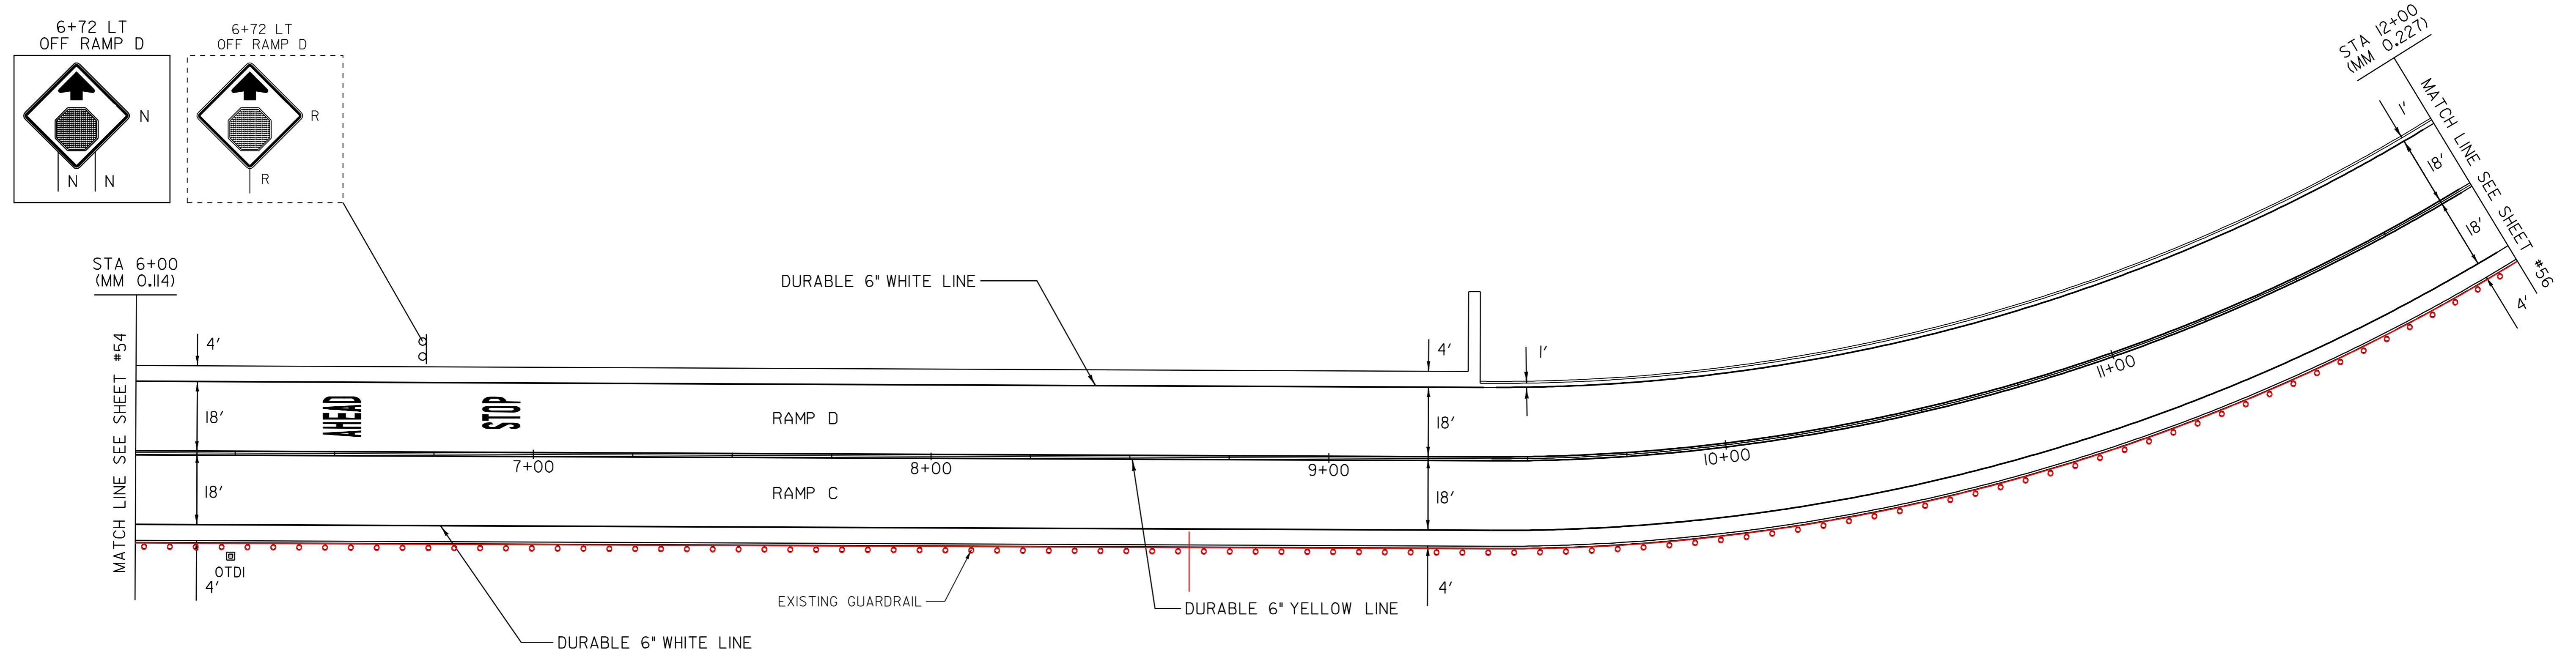

REPLACE EXISTING GR W/6' POSTS  
 STA 0+40 - STA 8+65 RT.

REPLACE EXISTING GR W/8' POSTS  
 STA 8+65 - STA 13+25 RT.

- LEGEND**
- R = REMOVE EXISTING
  - S = SALVAGE
  - R & S = REMOVE AND SALVAGE
  - N = NEW
  - RET = RETAIN
  - B-B = BACK TO BACK
  - = NEW RAIL
  - = EXISTING RAIL

**DATUM**

VERTICAL \_\_\_\_\_

HORIZONTAL \_\_\_\_\_

NOT TO SCALE

<b>RAMP DETAIL #9</b>	PROJECT NAME: GUILFORD-BRATTLEBORO
	PROJECT NUMBER: AC IM 091-1(54)
	FILE NAME: 05A014rd09.1
DESIGNED BY: CLD	PLOT DATE: 22-JAN-2009 13:41
CLD REF. NO. 05-0387	DRAWN BY: MRS
	CHECKED BY: NLL
	SHEET 55 OF 69