


TEMPORARY AND DURABLE 6" WHITE LINE
 I-91 471+72 TO 472+50 DASHED LT
 REMOVAL AND DISP. GUARDRAIL
 I-91 468+18 TO 472+50 LT
 STEEL BEAM GUARDRAIL (GALV.) (MOD.-8' POSTS)
 I-91 468+30.5 TO 472+50 LT
 TRAILING END TERMINAL (TET)
 I-91 468+18 TO 468+30.5 LT
 DELINEATORS
 REFER TO STANDARDS E-197, E-198
 AND E-199 FOR PLACEMENT GUIDELINES


EXIT 2 - RAMP C SOUTHBOUND ON RAMP

SEE STANDARDS E-191, E-192 AND E-193
 FOR PAVEMENT MARKING GUIDELINES

REMOVE AND RESET 285' OF
 GRANITE CURB TO STA 465+33

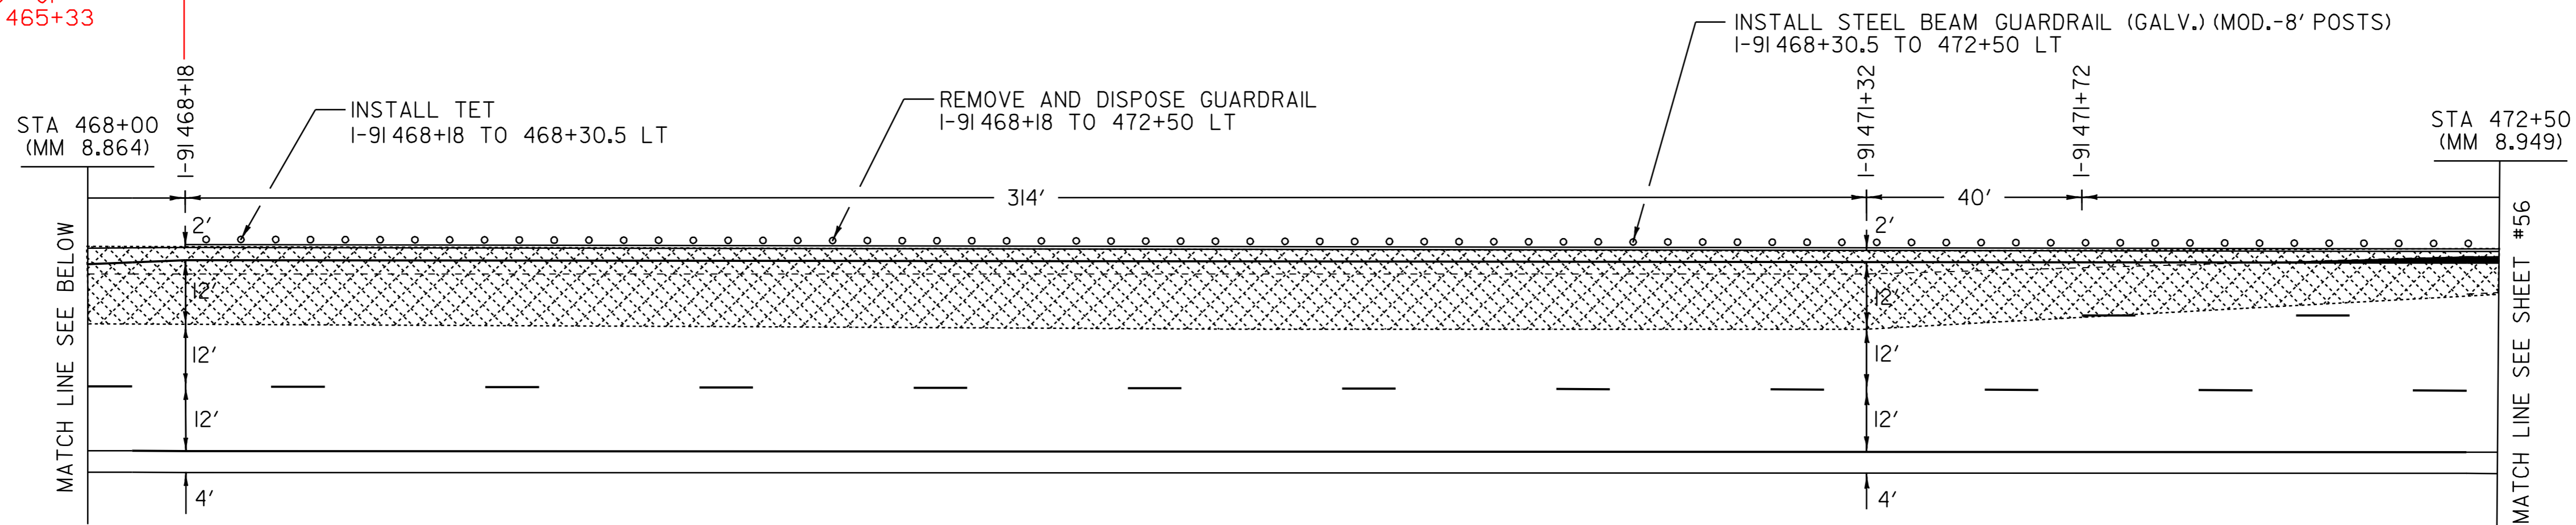

NOTE: REFER TO LANE WIDENING DETAILS ON SHEET 6.

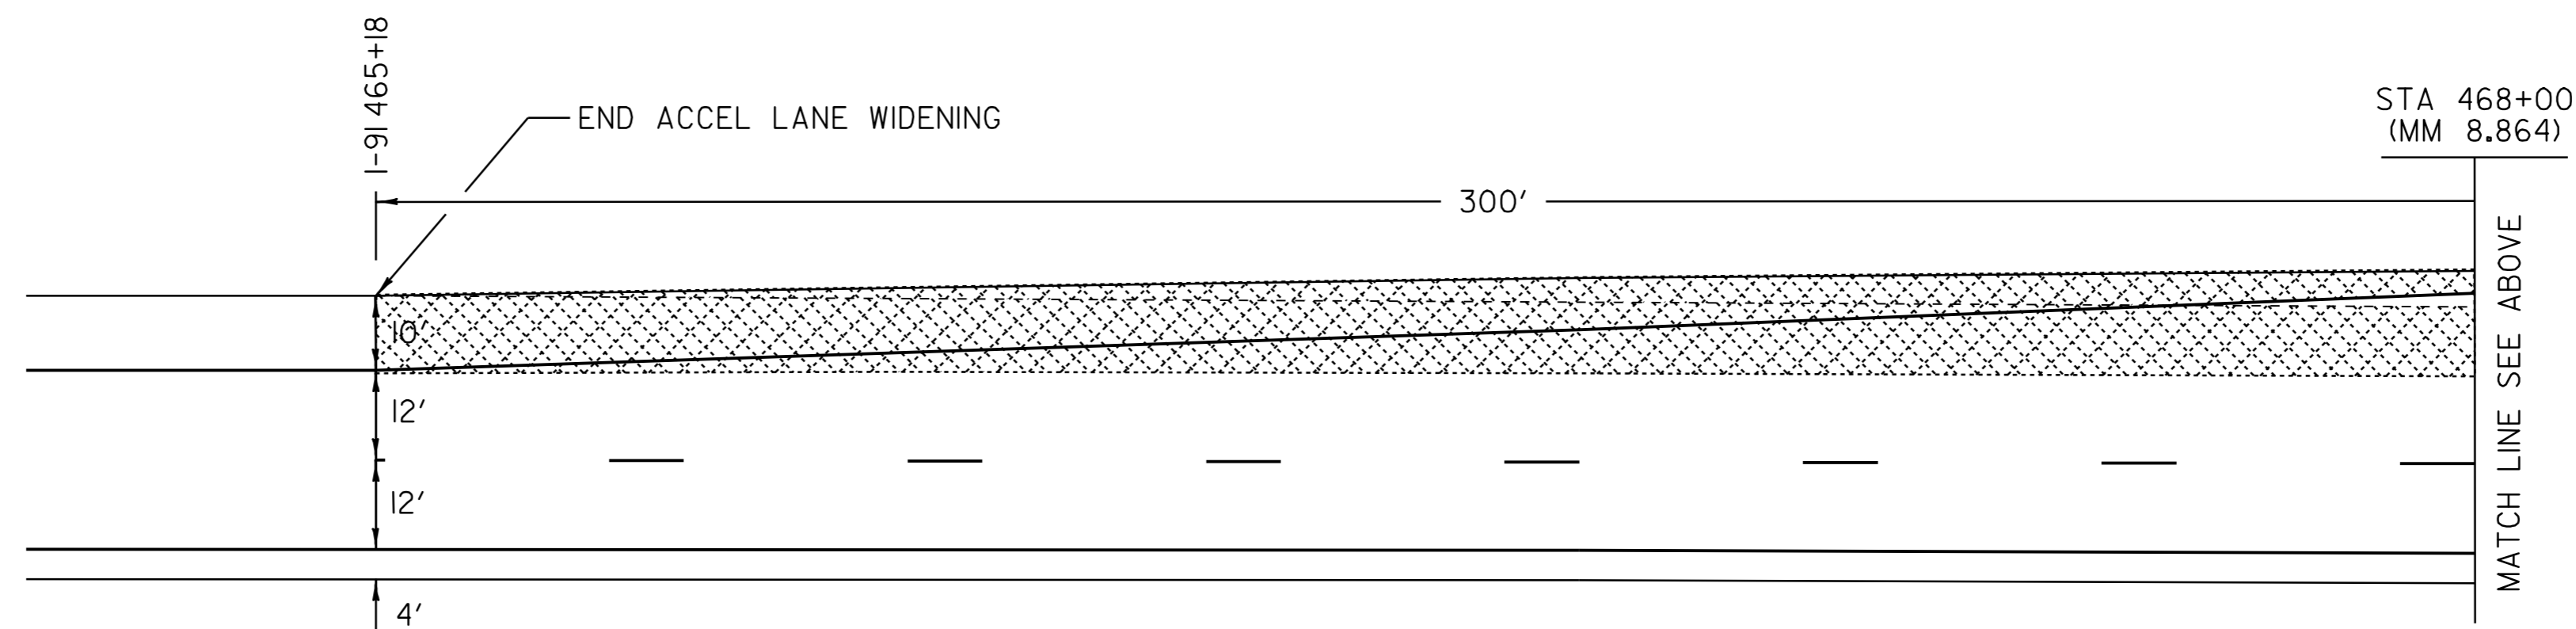

LEGEND

- R = REMOVE EXISTING
- S = SALVAGE
- R & S = REMOVE AND SALVAGE
- N = NEW
- RET = RETAIN
- B-B = BACK TO BACK
- = NEW RAIL
- = EXISTING RAIL
- ▨ = SHADED AREA EXCAVATE 6' / TYPE IS

NOT TO SCALE

RAMP DETAIL #11

PROJECT NAME: GUILFORD-BRATTLEBORO
 PROJECT NUMBER: AC IM 091-1(54)

FILE NAME: 05A014-rd11.1
 PROJECT LEADER: CRB
 DESIGNED BY: CLD
 CLD REF. NO. 05-0387

PLOT DATE: 22-JAN-2009 13:41
 DRAWN BY: MRS
 CHECKED BY: NLL
 SHEET 57 OF 69

DATUM	
VERTICAL _____	
HORIZONTAL _____	