

TEMPORARY AND DURABLE 6" WHITE LINE
 OFF RAMP 1+02 TO 5+00 SOLID RT (RAMP B)
 I-91 619+80 TO 620+50 DASHED LT

TEMPORARY AND DURABLE 6" YELLOW LINE
 OFF RAMP 1+02 TO 5+00 SOLID LT (RAMP B)

TEMPORARY AND DURABLE 12" WHITE LINE
 OFF RAMP 0+53 TO 1+02 SOLID LT (RAMP B)
 I-91 618+70 TO 619+80 SOLID LT
 GORE STRIPES 618+70 TO 619+30 SOLID LT

REMOVAL & DISP. OF GUARDRAIL
 OFF RAMP 1+60 TO 1+85 RT

STEEL BEAM GUARDRAIL (GALV.) (MOD.-8' POSTS)
 OFF RAMP 1+60 TO 1+72.5 RT


TRAILING END TERMINAL (TET)
 OFF RAMP 1+72.5 TO 1+85 RT

REHABING DI, CB OR MH
~~OFF RAMP 1+23 RT (RAMP B) CLASS III~~
~~OFF RAMP 2+97 RT (RAMP B) CLASS I~~
 OFF RAMP 1+23 RT (RAMP B) CLASS I
 DELINEATORS

REFER TO STANDARDS E-197, E-198
 AND E-199 FOR PLACEMENT GUIDELINES

EXIT 3 - RAMP B SOUTHBOUND OFF RAMP

SEE STANDARDS E-191, E-192 AND E-193
 FOR PAVEMENT MARKING GUIDELINES

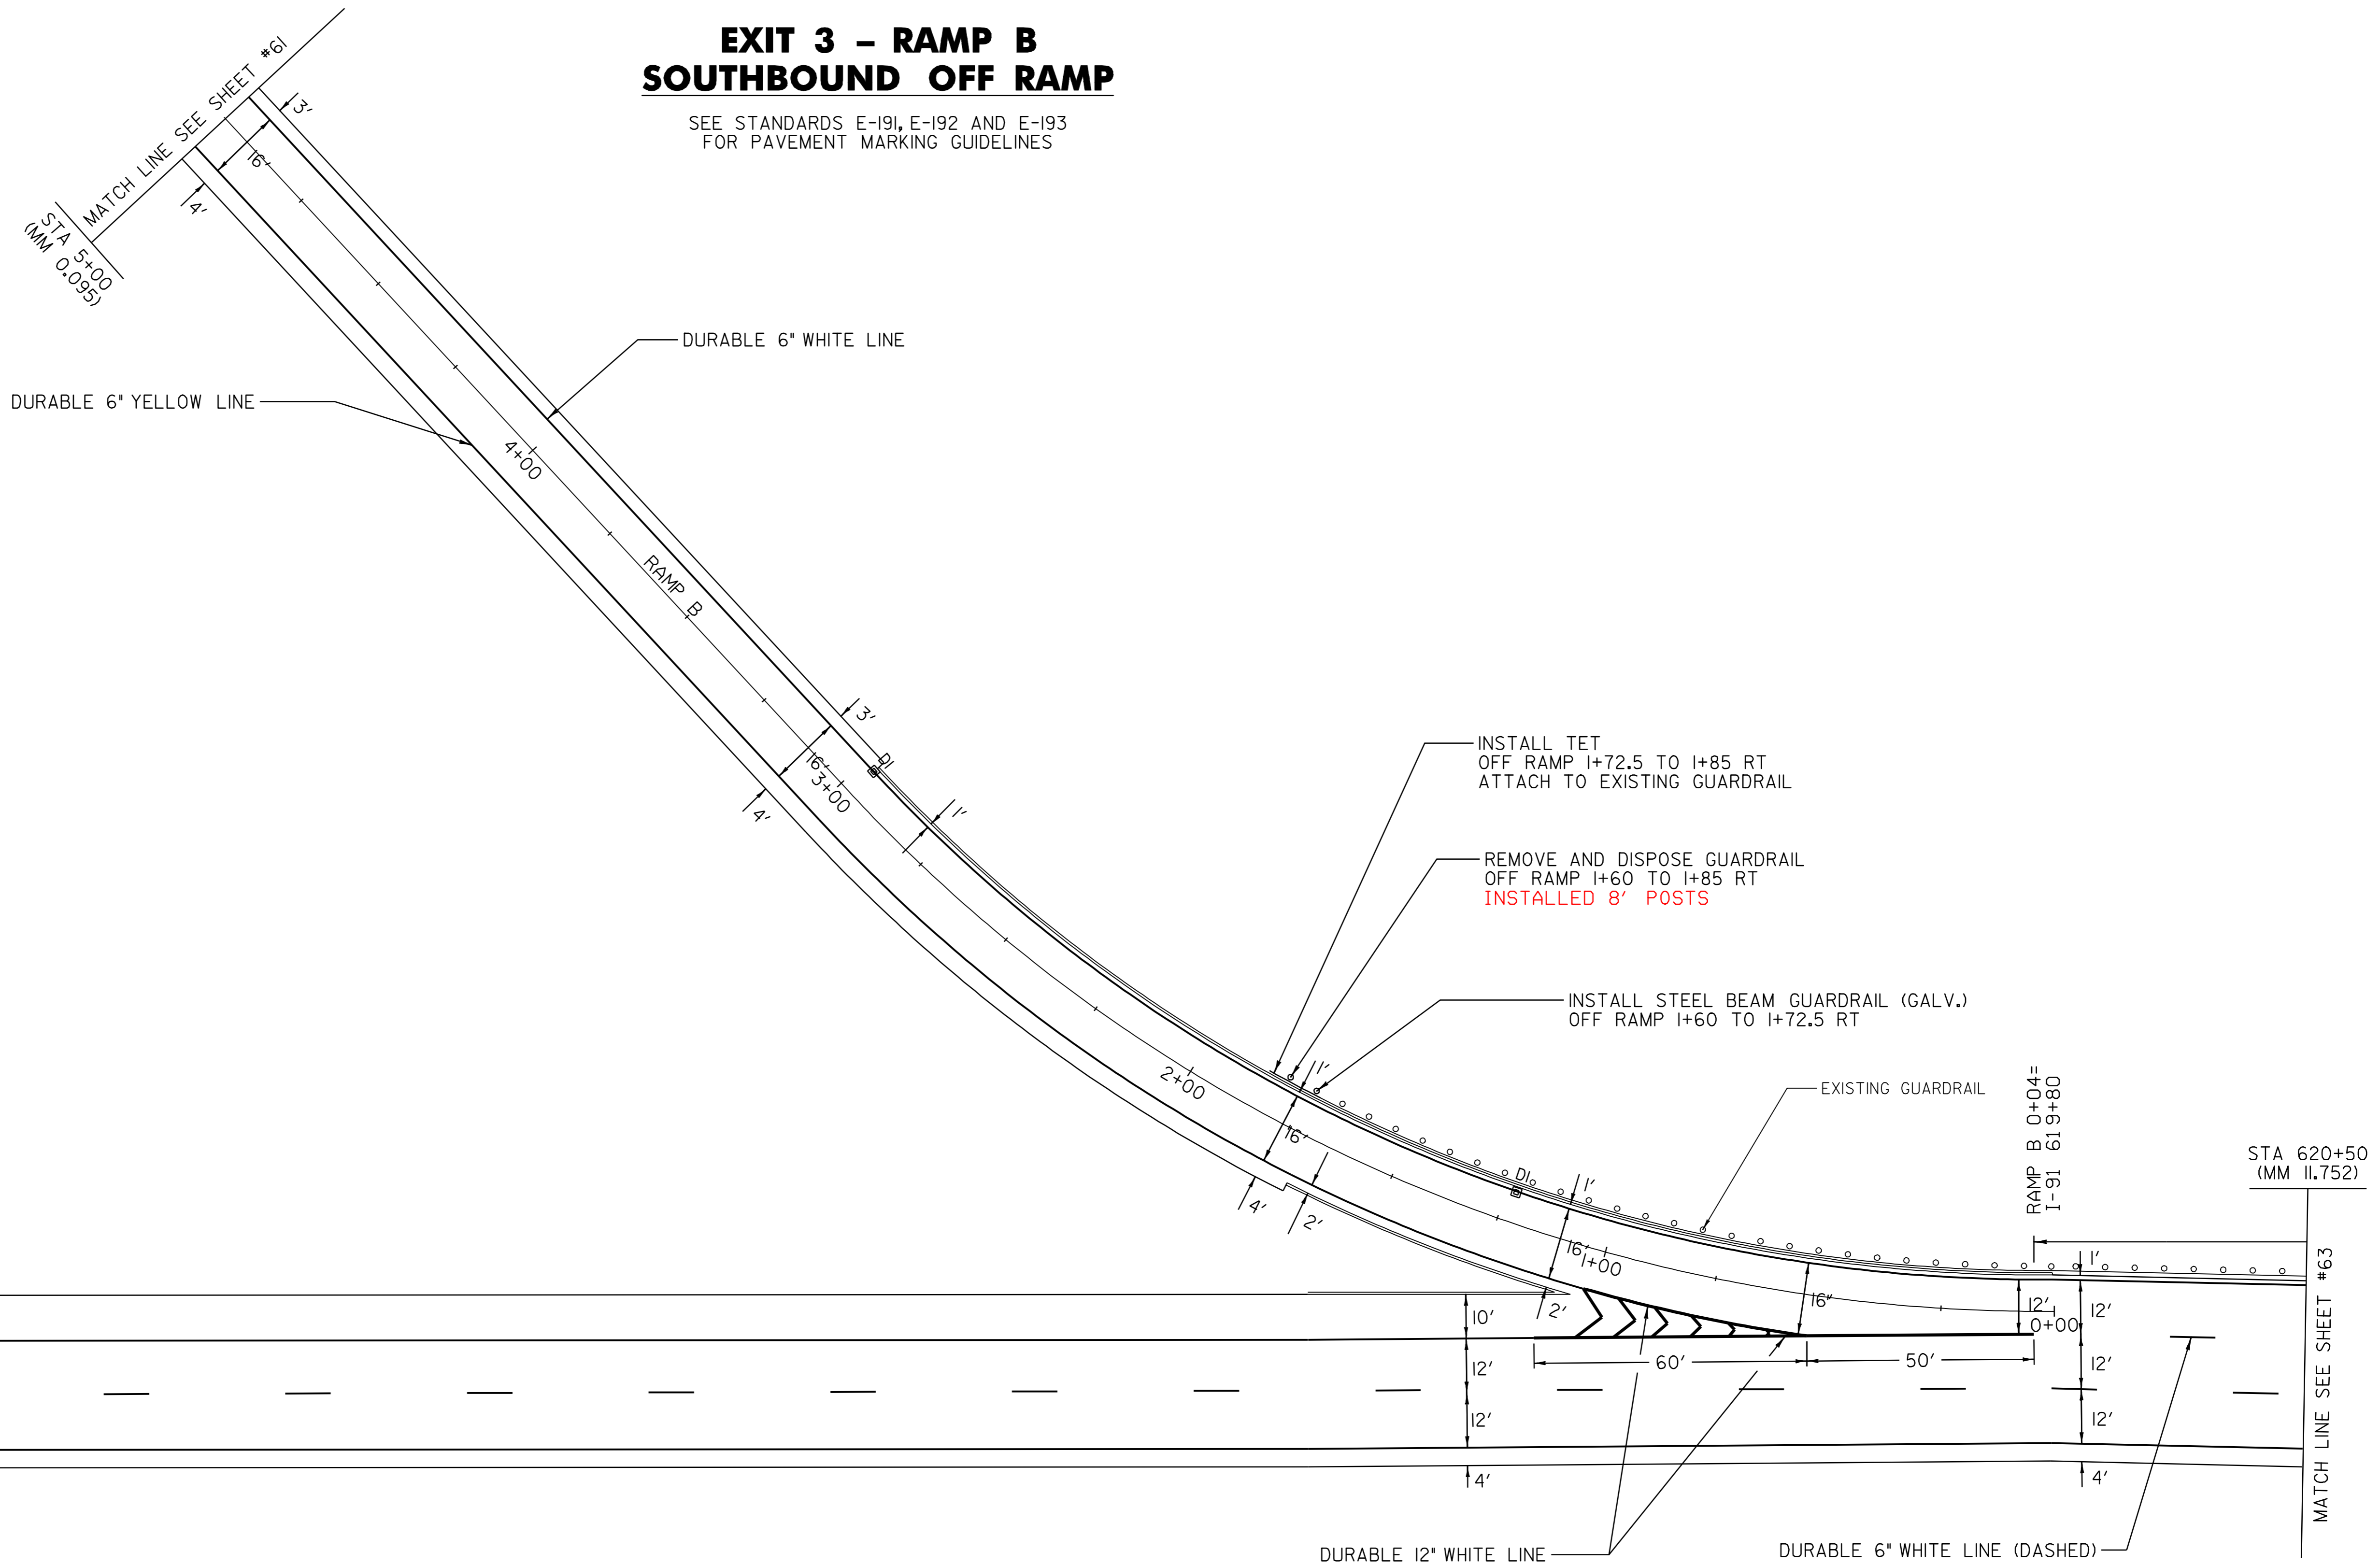

DATUM	
VERTICAL	_____
HORIZONTAL	_____

NOT TO SCALE

LEGEND

R	=	REMOVE EXISTING
S	=	SALVAGE
R & S	=	REMOVE AND SALVAGE
N	=	NEW
RET	=	RETAIN
B-B	=	BACK TO BACK
	=	NEW RAIL
	=	EXISTING RAIL

RAMP DETAIL #16	PROJECT NAME: GUILFORD-BRATTLEBORO
	PROJECT NUMBER: AC IM 091-I(54)
	FILE NAME: 05A014r.dwg
	CLD REF. NO. 05-0387
PLOT DATE: 22-JAN-2009 13:4	
DRAWN BY: MRS	
CHECKED BY: NLL	
SHEET 62 OF 69	