


RAMP APPROACH AREA DETAIL

LOCATION


- EXIT 8 - END OF SOUTHBOUND OFF RAMP (BETWEEN BR. # 41S AND BR. # 41N)
- EXIT 8 - BEGIN OF NORTHBOUND ON RAMP AT MONTPELIER STATE HIGHWAY
- EXIT 9 - END OF NORTHBOUND ON & OFF RAMPs (@ MIDDLESEX STATE HIGHWAY)
- EXIT 9 - END OF SOUTHBOUND ON & OFF RAMPs (@ MIDDLESEX STATE HIGHWAY)

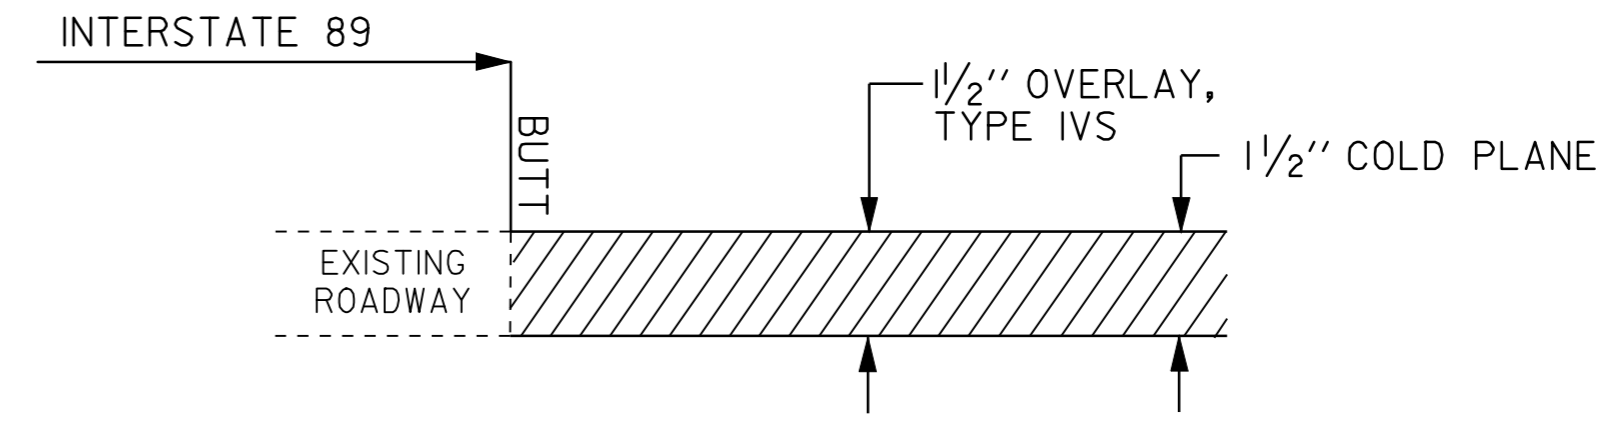

MAINLINE APPROACH AREA DETAIL

LOCATION

- BEGINNING OF PROJECT - STA 2801+04 (M.M. 53.05) SOUTHBOUND
- END OF PROJECT - SEE BRIDGE APPROACH DETAIL BR # 46S SOUTHBOUND
- BEGINNING OF PROJECT - STA 2800+72 (M.M. 53.044) NORTHBOUND
- END OF PROJECT - STA. 3300+00 (M.M. 62.50) NORTHBOUND

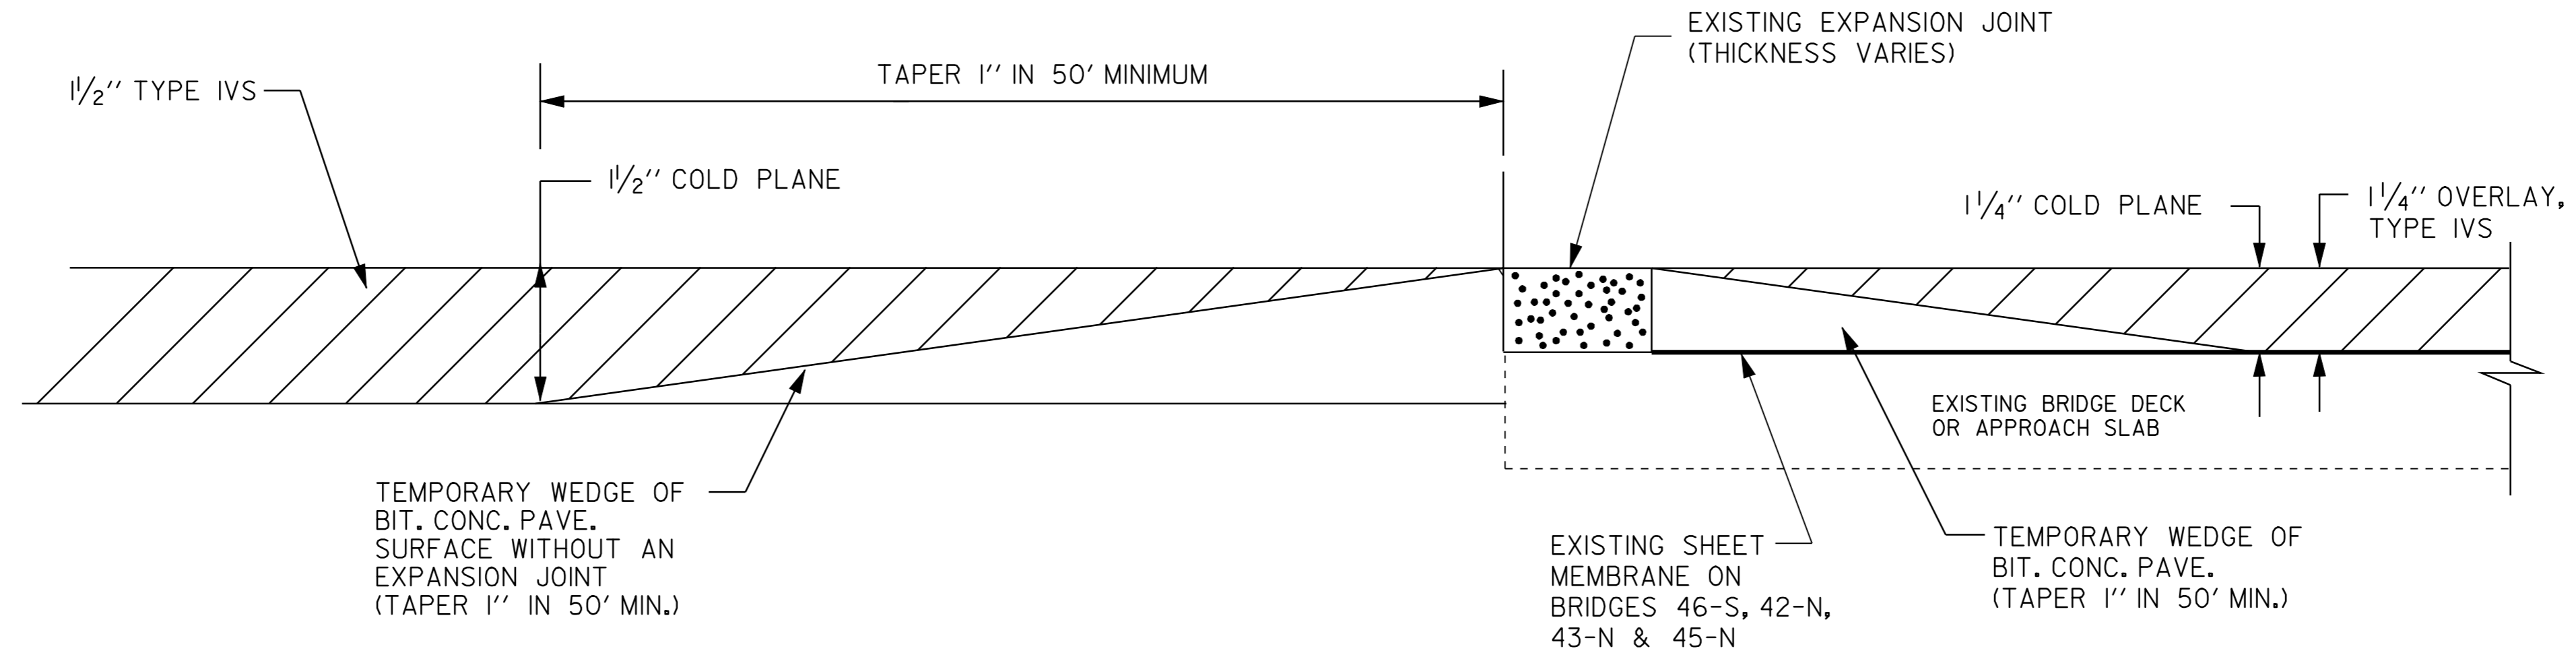

BRIDGE APPROACH DETAIL

SB BR # 42-S	STA 2816+52 TO STA 2817+27	NB BR # 42-N	STA 2816+52 TO STA 2817+27
SB BR # 42-S	STA 2825+59 TO STA 2826+34	NB BR # 42-N	STA 2825+59 TO STA 2826+34
SB BR # 43-S	STA 2892+40 TO STA 2893+15	NB BR # 43-N	STA 2892+40 TO STA 2893+15
SB BR # 43-S	STA 2894+71 TO STA 2895+46	NB BR # 43-N	STA 2894+71 TO STA 2895+46
SB BR # 45-S	STA 3098+58 TO STA 3099+33	NB BR # 45-N	STA 3098+58 TO STA 3099+33
SB BR # 45-S	STA 3100+50 TO STA 3101+25	NB BR # 45-N	STA 3100+50 TO STA 3101+25
SB BR # 46-S	STA 3351+93 TO STA 3352+68		
SB BR # 46-S	STA 3356+26 TO STA 3357+01		

NOT TO SCALE

**PROJECT
TYPICAL
SHEET 3**

PROJECT NAME: MONTPELIER - WATERBURY
PROJECT NUMBER: IM 089-2(34)

FILE NAME: Zpqve\03a026\03a026.dgn PLOT DATE: 11-APR-2005 10:17
PROJECT LEADER: DRAWN BY:
DESIGNED BY: CHECKED BY:
IPARM NAME: p03a026p+3.l SHEET 4 OF 23