

621.505 MANUFACTURED TERMINAL SECTIONS (FLARED)

~~2830+18.5 TO 2830+56 LT.  
 2845+02 TO 2845+39.5 RT.  
 2869+78.5 TO 2870+16 LT.  
 2906+27 TO 2906+64.5 LT.  
 2923+64 TO 2924+01.5 RT.  
 2939+74.5 TO 2940+12 RT.  
 3008+70 TO 3009+07.5 LT.  
 3063+56 TO 3063+93.5 LT.  
 3076+81.5 TO 3077+19 LT.~~

SB 58.273 TO SB 58.280 LT.  
 SB 56.983 TO SB 56.990 LT.  
 SB 58.022 TO SB 58.029 LT.  
 SB 53.602 TO SB 53.609 LT.  
 SB 54.352 TO SB 54.359 LT.  
 SB 55.042 TO SB 55.050 LT.  
 SB 53.883 TO SB 53.890 RT.  
 SB 55.372 TO SB 55.379 RT.  
 SB 55.677 TO SB 55.684 RT.  
 SB 58.828 TO SB 58.835 RT.  
 SB 56.387 TO SB 56.394 RT.  
 NB 54.698 TO NB 54.705 RT.  
 NB 57.324 TO NB 57.331 RT.  
 NB 55.019 TO NB 55.026 LT.  
 NB 54.472 TO NB 54.479 RT.  
 NB 55.736 TO NB 55.743 RT.  
 NB 56.107 TO NB 56.113 LT.  
 NB 53.299 TO NB 53.306 RT.  
 NB 53.791 TO NB 53.798 RT.  
 NB 58.089 TO NB 58.096 RT.

~~621.80 REMOVAL & DISP. OF GUARDRAIL~~

~~2830+18.5 TO 2830+56 LT.  
 2845+02 TO 2845+39.5 RT.  
 2869+78.5 TO 2870+16 LT.  
 2906+27 TO 2906+64.5 LT.  
 2923+64 TO 2924+01.5 RT.  
 2939+74.5 TO 2940+12 RT.  
 3008+70 TO 3009+07.5 LT.  
 3063+56 TO 3063+93.5 LT.  
 3076+81.5 TO 3077+19 LT.~~

~~646.414 DURABLE 6" WHITE LINE (MOD.)~~

~~2801+04 TO 3078+66 SOLID LT  
 2801+04 TO 3078+66 DASHED CL~~

~~646.614 TEMPORARY 6" WHITE LINE~~

~~2801+04 TO 3078+66 SOLID LT  
 2801+04 TO 3078+66 DASHED CL~~

~~646.415 DURABLE 6" YELLOW LINE (MOD.)~~

~~2801+04 TO 3078+66 SOLID RT~~

~~646.615 TEMPORARY 6" YELLOW LINE~~


~~2801+04 TO 3078+66 SOLID RT~~

604.412 REHABING DI,CB OR MH CLASS I

2811+60 LT  
~~3053+42 LT  
 3057+12 LT~~

MONTPELIER, EXIT 8 NB ON RAMP "B"  
 MONTPELIER, EXIT 8 SB OFF RAMP "D", 2 EA.  
 SB MM 53.25 RT.

**STA 3078+66  
 (MM 58.308)**

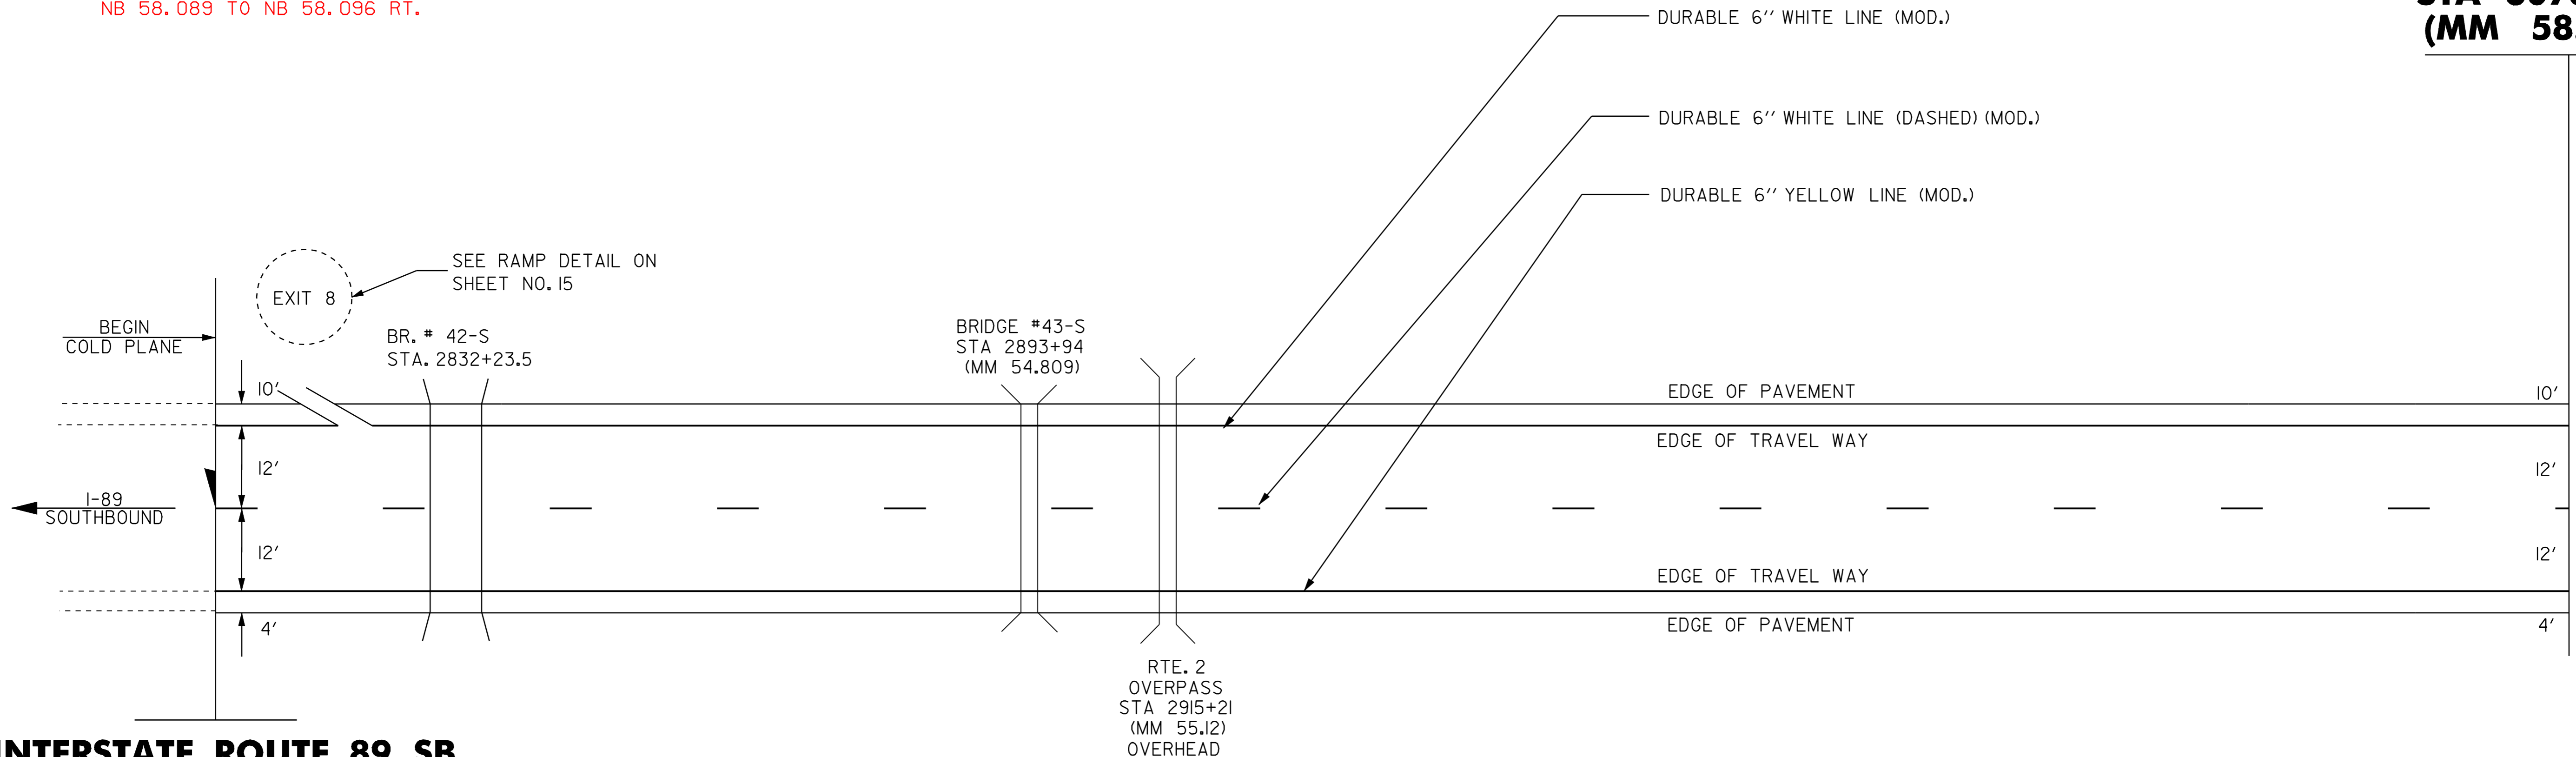

**INTERSTATE ROUTE 89 SB  
 STA 2801+04  
 (MM 53.05)  
 BEGIN PROJECT  
 IM 089-2(34)**

NOT TO SCALE

**PAVING  
 PROJECT  
 LAYOUT #1**

PROJECT NAME: MONTPELIER - WATERBURY  
 PROJECT NUMBER: IM 089-2(34)

FILE NAME: /pave/03a026/p03a026.dgn PLOT DATE: 11-APR-2005 10:18  
 PROJECT LEADER: DRAWN BY:  
 DESIGNED BY: CHECKED BY:  
 IPARM NAME: p03a026I01I SHEET 11 OF 23