

621.505 MANUFACTURED TERMINAL SECTION

~~3107+38.5 TO 3107+76 LT.~~
~~3128+35 TO 3128+72.5 LT.~~
~~3155+43 TO 3155+80.5 LT.~~
~~3175+92 TO 3176+29.5 LT.~~
~~3192+23.5 TO 3192+61 LT.~~
~~3322+33.5 TO 3322+71 LT.~~
~~3341+34 TO 3341+71.5 LT.~~

SB 59.249 TO SB 59.256 LT.
 SB 63.283 TO SB 63.290 LT.
 SB 62.923 TO SB 62.930 LT.
 SB 60.752 TO SB 60.759 LT.
 SB 60.150 TO SB 60.169 LT.
 SB 60.459 TO SB 60.466 LT.
 SB 58.852 TO SB 58.859 LT.
 SB 59.762 TO SB 59.769 LT.
 SB 58.828 TO SB 58.835 RT.
 NB 54.698 TO NB 54.705 RT.
 MSH RAMP "D"
 NB 58.459 TO NB 58.466 RT.

NB 58.678 TO NB 58.685 RT.
 NB 58.869 TO NB 58.876 RT.
 NB 59.365 TO NB 59.372 RT.
 NB 59.958 TO NB 59.965 RT.
 NB 58.615 TO NB 58.622 LT.
 NB 60.259 TO NB 60.266 RT.
 NB 60.628 TO NB 60.635 RT.
 NB 61.012 TO NB 61.019 RT.
 NB 61.557 TO NB 61.564 RT.
 NB 61.907 TO NB 61.914 RT.
 NB 62.344 TO NB 62.351 RT.

621.80 REMOVAL & DISP. OF GUARDRAIL

~~3107+38.5 TO 3107+76 LT.~~
~~3128+35 TO 3128+72.5 LT.~~
~~3155+43 TO 3155+80.5 LT.~~
~~3175+92 TO 3176+29.5 LT.~~
~~3192+23.5 TO 3192+61 LT.~~
~~3197+51.5 TO 3197+64 LT.~~
~~3322+33.5 TO 3322+71 LT.~~
~~3341+34 TO 3341+71.5 LT.~~

~~646.414 DURABLE 6" WHITE LINE (MOD.)~~
~~3078+66 TO 3356+19 SOLID LT~~
~~3078+66 TO 3356+19 DASHED CL~~

~~646.415 DURABLE 6" YELLOW LINE (MOD.)~~
~~3078+66 TO 3356+19 SOLID RT~~


~~646.614 TEMPORARY 6" WHITE LINE~~
~~3078+66 TO 3356+19 SOLID LT~~
~~3078+66 TO 3356+19 DASHED CL~~

~~646.615 TEMPORARY 6" YELLOW LINE~~
~~3078+66 TO 3356+19 SOLID RT~~

~~604.412 REHABING DI, CB OR MH CLASS +~~
~~3090+91 LT~~

STA 3078+66
(MM 58.308)

INTERSTATE ROUTE 89 SB
STA 3356+19
(MM 63.564)
END PROJECT
IM 089-2(34)

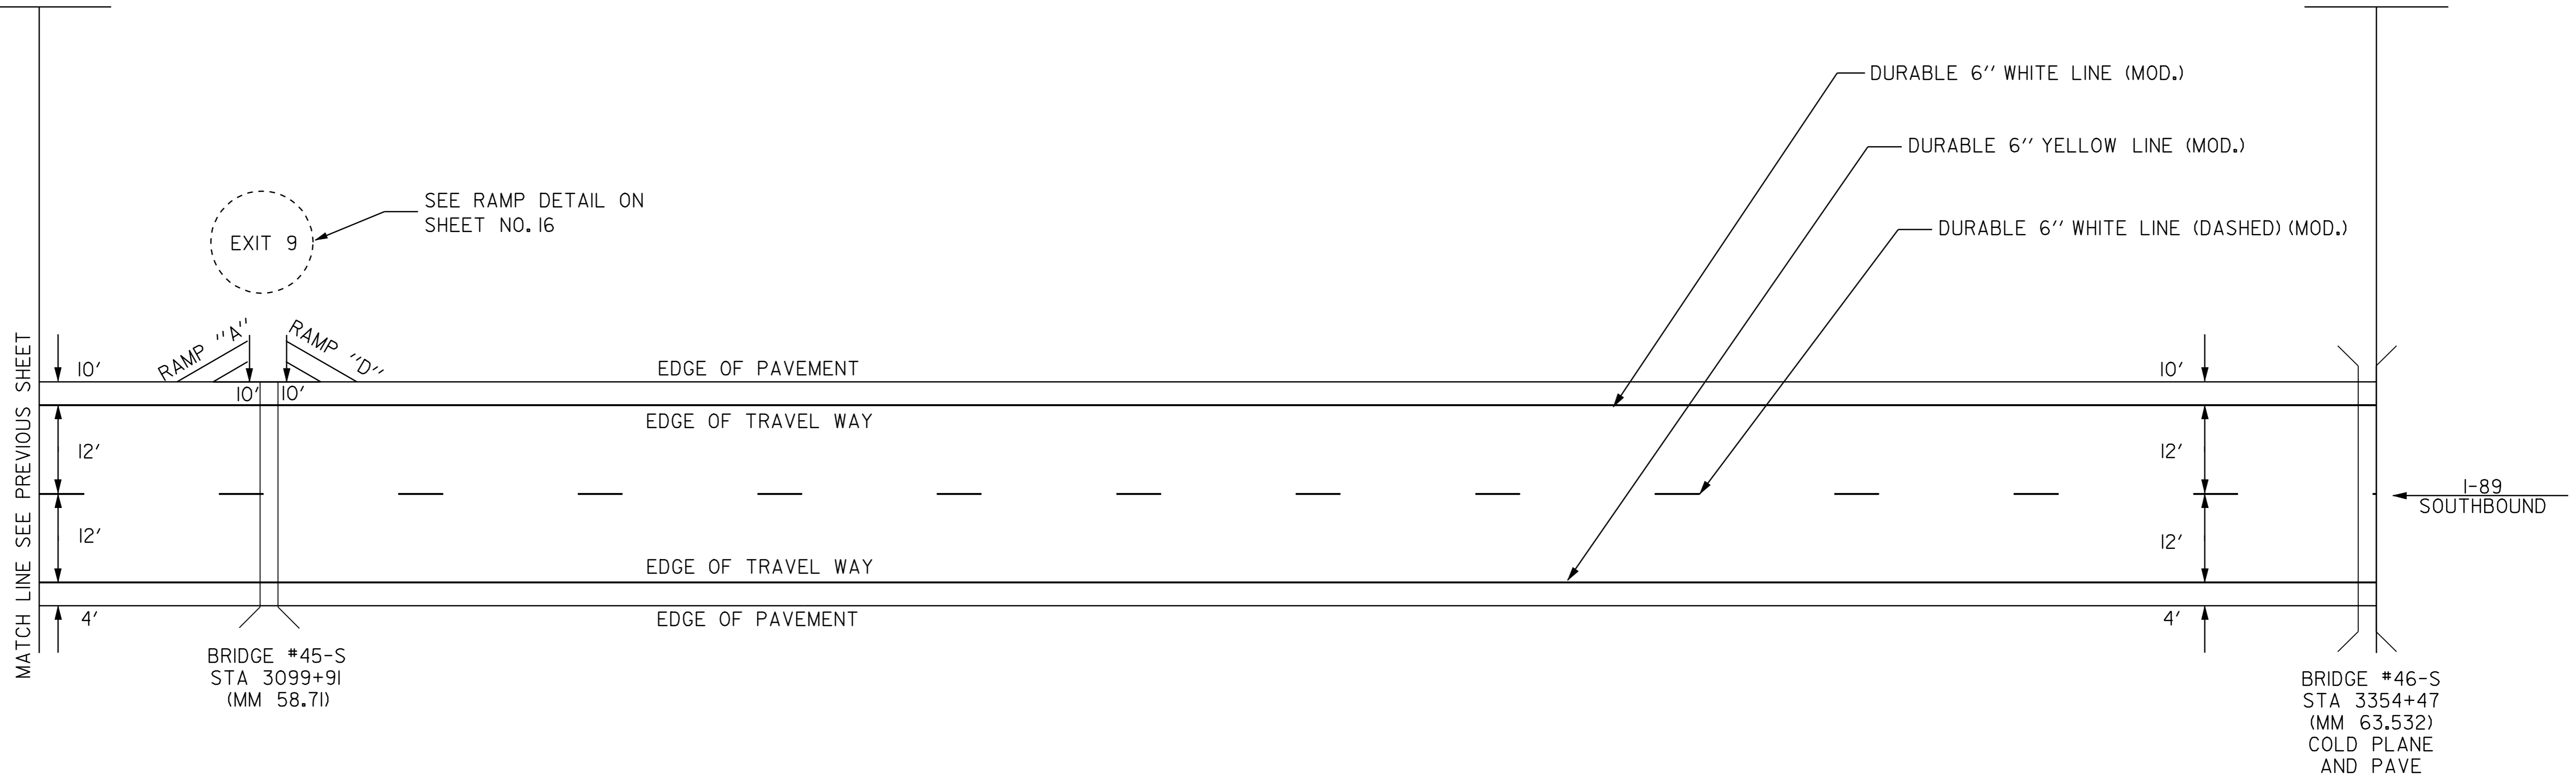

NOT TO SCALE

**PAVING
 PROJECT
 LAYOUT #2**

PROJECT NAME: MONTPELIER - WATERBURY
 PROJECT NUMBER: IM 089-2(34)

FILE NAME: /pave/03a026/p03a026.dgn
 PROJECT LEADER:
 DESIGNED BY:
 IPARM NAME: p03a026i02.i

PLOT DATE: 11-APR-2005 10:18
 DRAWN BY:
 CHECKED BY:
 SHEET 12 OF 23