


# GUARDRAIL TREATMENT AT BULLNOSE LOCATIONS—BRIDGES

LOCATIONS:  
 SB MM 54.778 TO SB MM 54.937 BR 43 S  
 NB MM 54.695 TO NB MM 54.842 BR 43 N

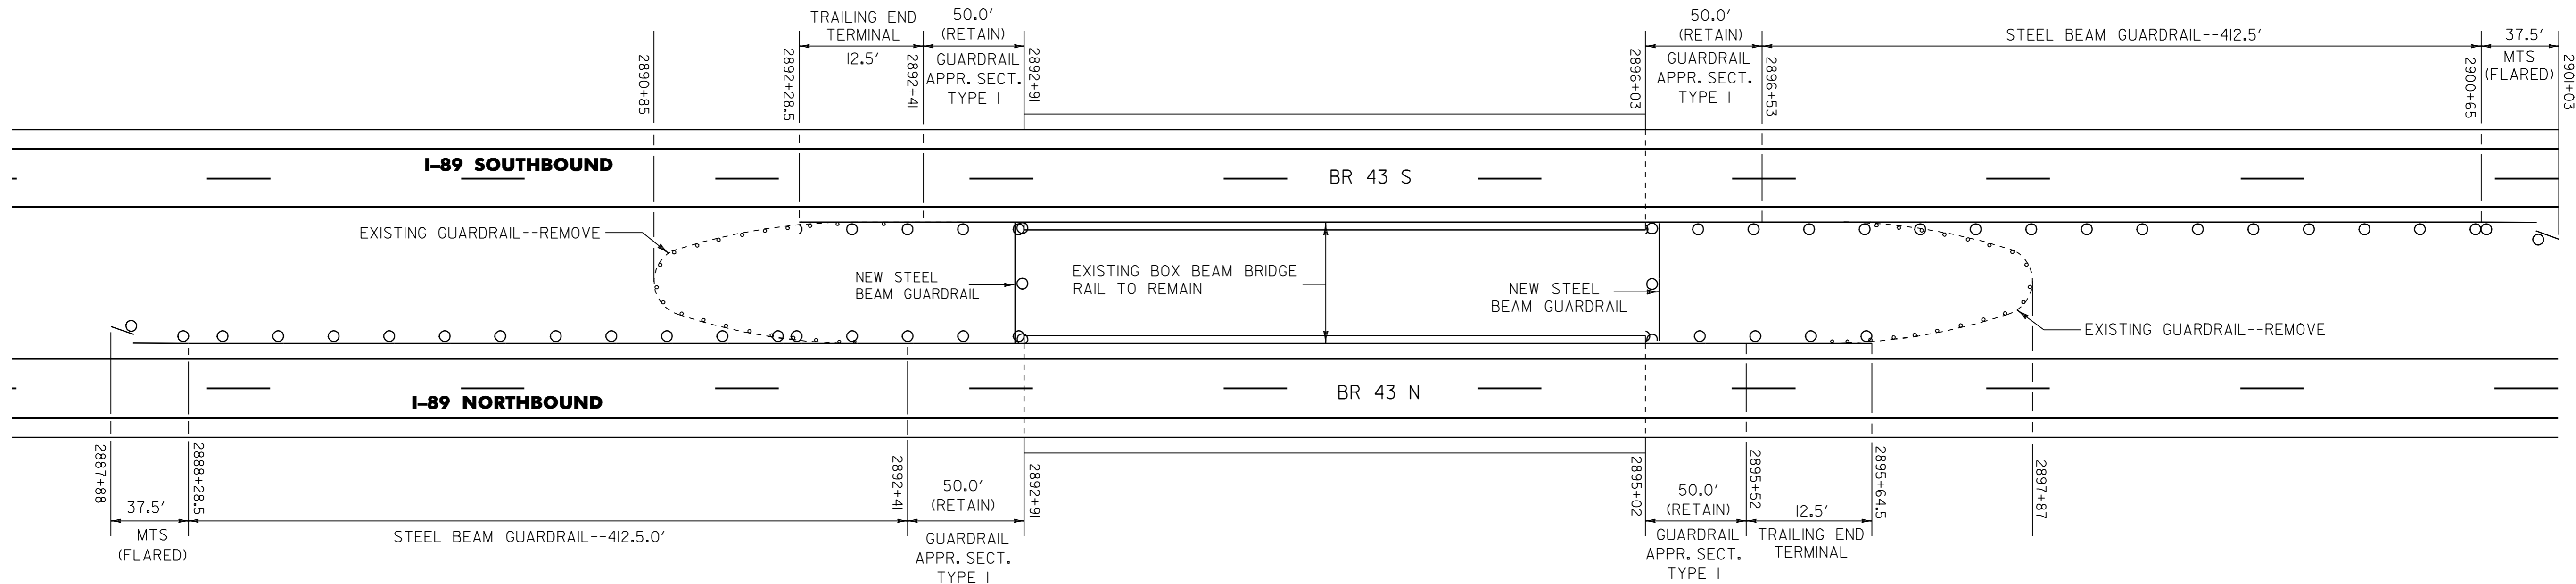

**621.20 STEEL BEAM GUARDRAIL**

NB--2892+41 LT (50 LF)  
 NB--2895+02 LT (50 LF)  
 NB--2888+28 ~ 2892+41 LT  
 SB--2896+53 ~ 2900+65 RT

**621.52 MTS (TRAILING END TERMINAL)**

NB--2895+52 ~ 2895+64.5 LT  
 SB--2892+28.5 ~ 2892+41 RT


**621.505 MTS (FLARED)**

NB--2887+88 ~ 2888+28 LT  
 SB--2900+65 ~ 2901+03 RT

**621.80 REMOVING AND DISPOSAL OF GUARDRAIL**

NB--2890+85 ~ 2892+41 LT (275 LF)  
 NB--2896+53 ~ 2897+87 LT (300 LF)

LOCATIONS:  
 SB MM 58.703 TO SB MM 58.835 BR 45 S  
 NB MM 58.615 TO NB MM 58.752 BR 45 N

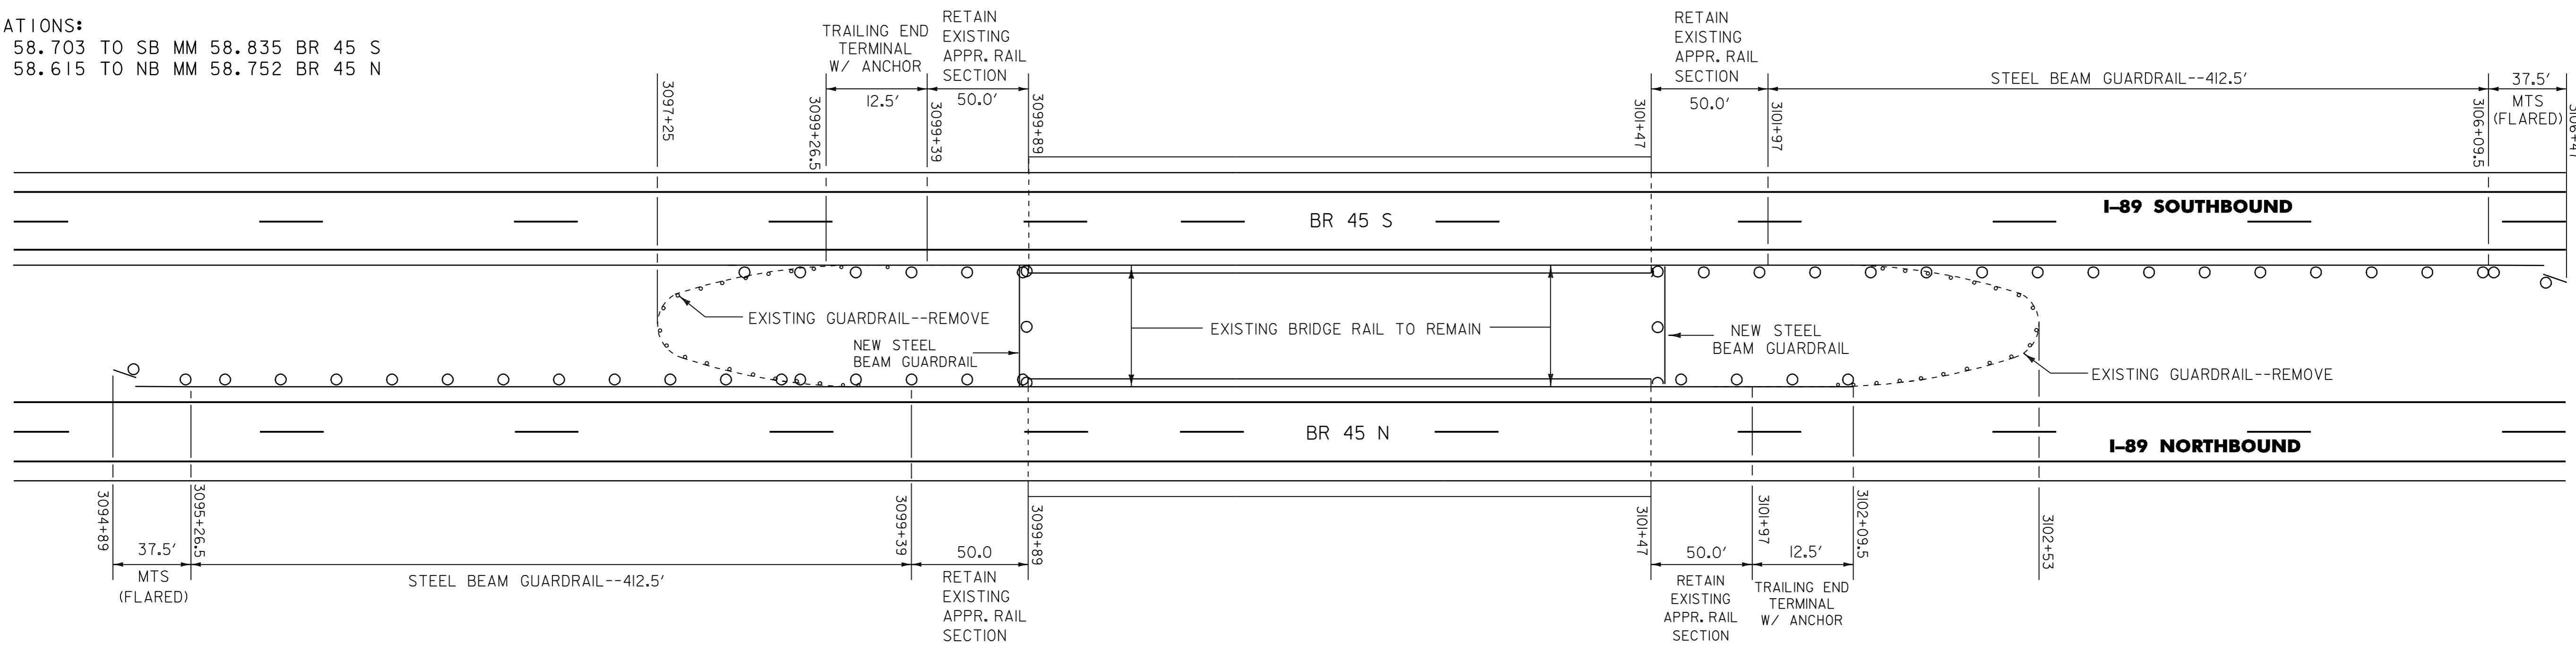

**621.20 STEEL BEAM GUARDRAIL**

SB--3095+26.5 ~ 3099+39 LT  
 SB--3101+97 ~ 3106+09.5 RT  
 NB--3099+89 LT (50 LF)  
 NB--3101+47 LT (50 LF)

**621.505 MTS (FLARED)**

NB--3094+89 ~ 3095+26 LT  
 SB--3106+09.5 ~ 3106+47 RT

**621.52 MTS (TRAILING END TERMINAL)**

NB--3101+97 ~ 3102+09.5 LT  
 SB--3099+26 ~ 3099+39 RT

**621.80 REMOVING AND DISPOSAL OF GUARDRAIL**

NB--3097+25 ~ 3099+39 (450 LF)  
 NB--3101+97 ~ 3102+53 (125 LF)

THE CONTRACTOR SHALL WIDEN WITH EARTH BORROW ADJACENT TO THE 4.0' SHOULDER TO PROVIDE BACKING FOR THE NEW GUARDRAIL AND TO CONSTRUCT A FLARE FOR THE END TERMINAL. CONSTRUCTION OF THE WIDENING AND TERMINAL FLARE SHALL BE COMPLETED IN ACCORDANCE WITH STANDARD G-19.

**BULLNOSE  
TREATMENT  
DETAIL  
SHEET 1**

PROJECT: MONTPELIER - WATERBURY	PROJECT NO. : IM 089-2(34)
DESIGN FILE NAME: /pave/03a026/03a026.dgn	
IPARM FILE NAME: /p03a026gr1.dgn	PLOT DATE: APR-2005 10:00
SURVEYED BY: N/A	SURVEY DATE:
SQUAD LEADER: MW	DRAWN BY: JLR
SHEET: 18 OF 23	